1942.

GOLD ST – N.L. KINKAID TO N.L. BROOKINGS ADDN.

2'6" CONC.

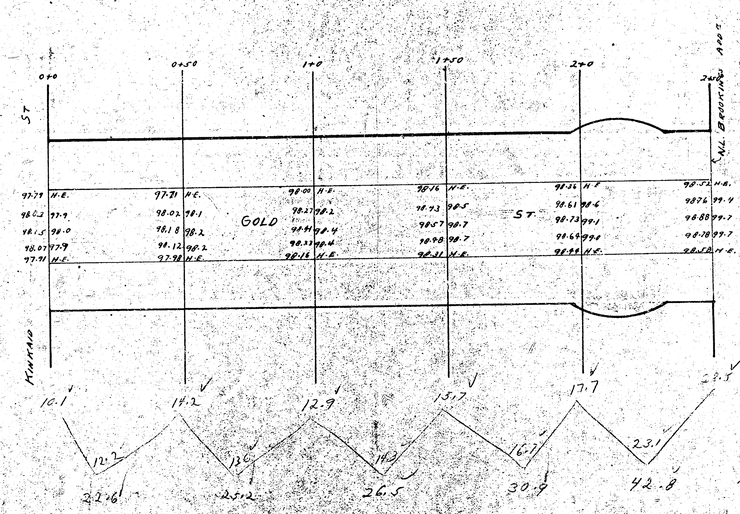

Pours

22.6
25.2
26.5
30.9
42.8

148.0

÷ 10 14.8

Total 6 2.6