


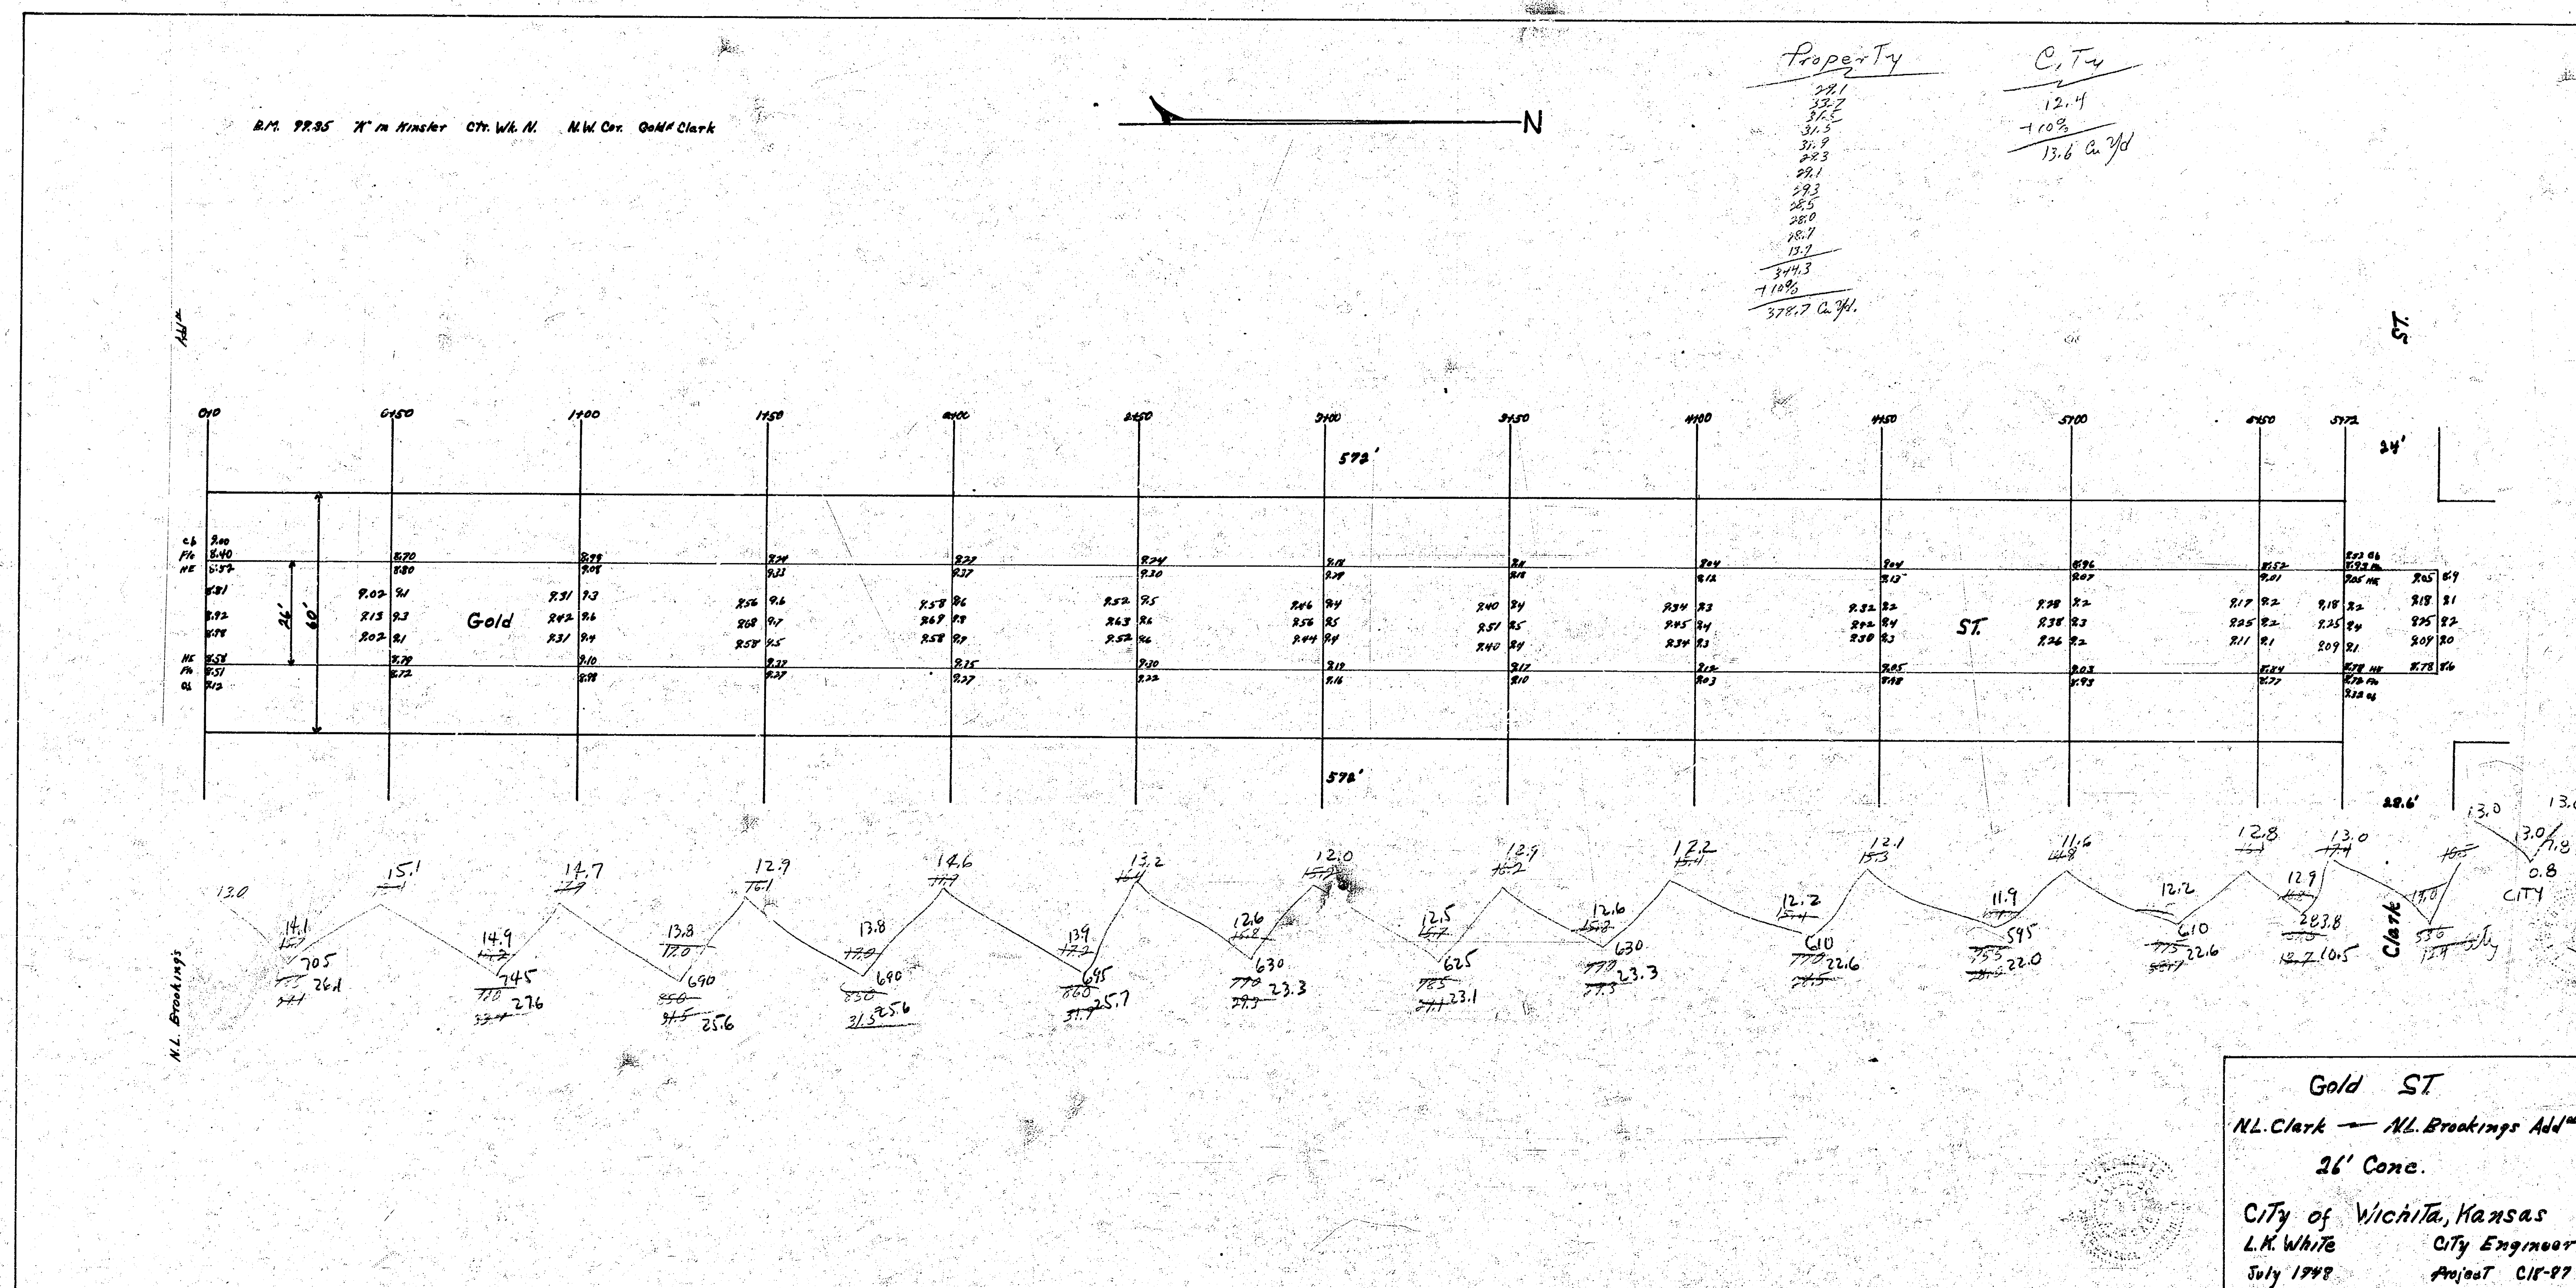

4 13 4 (8)