


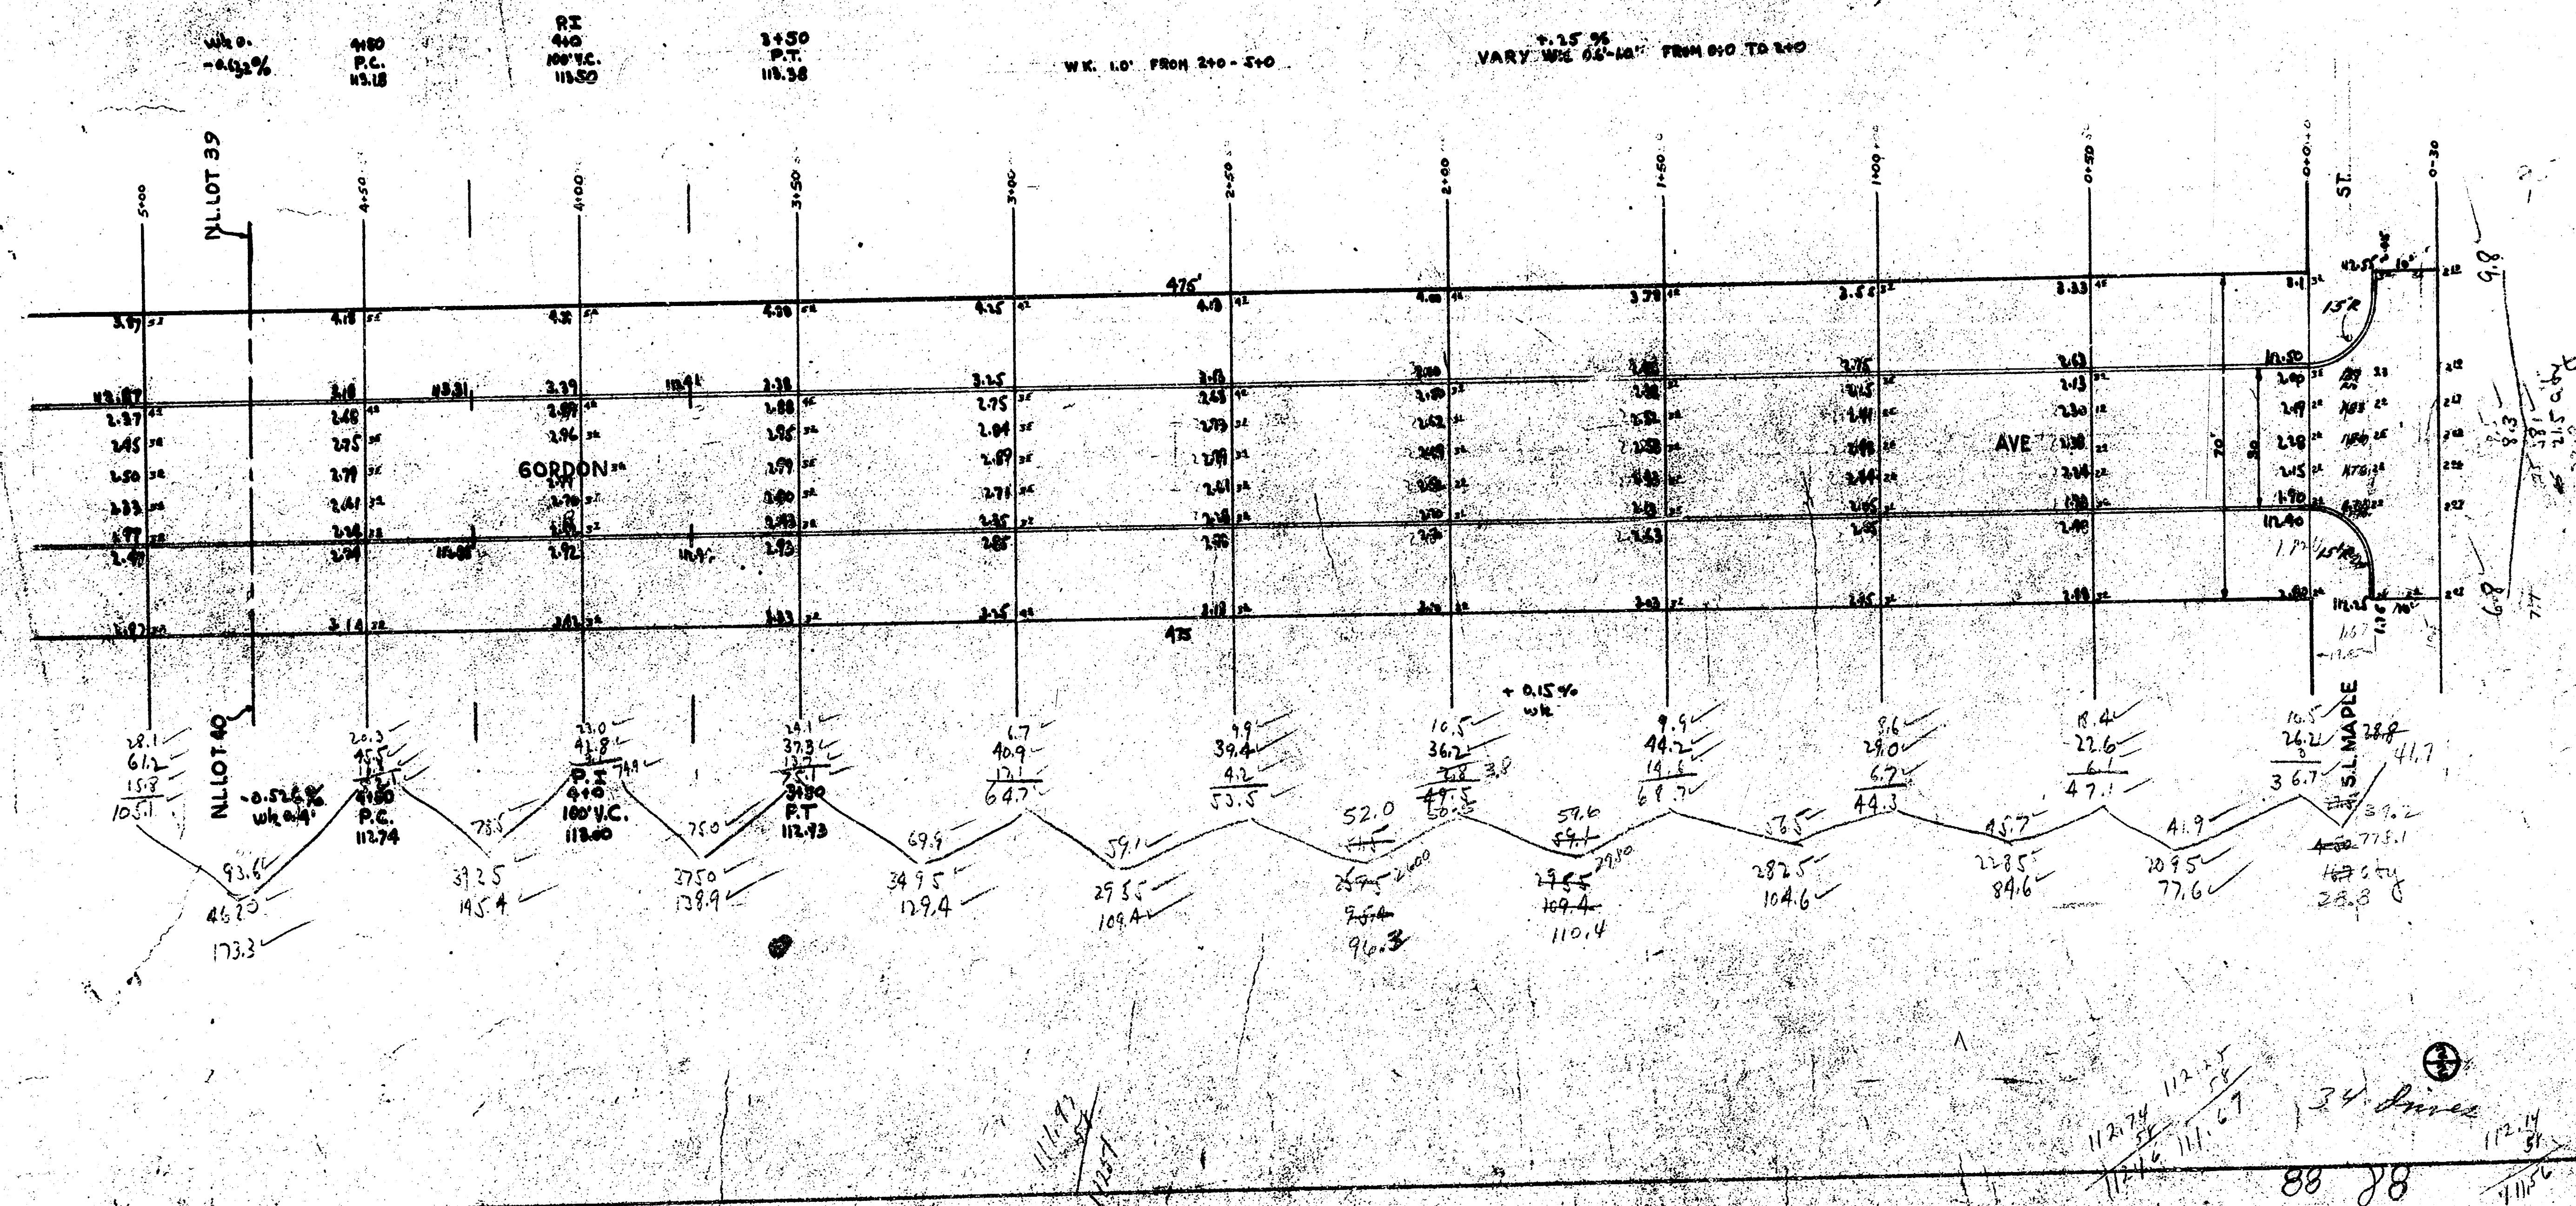

Boon 16

-N

$$\begin{array}{r} 276 \\ 658 \\ 103 \\ \hline 1042 \end{array} \quad \begin{array}{r} 100.7 \\ 103.5 \\ \hline 197.5 \end{array}$$

6.6
141
5

N.L. LOT 40

GORDON AVE
S.L. MAPLE TO S.L. UNIVERSITY
30' CONC. & CB
CITY of WICHITA, KANSAS
L.K.WHITE CITY ENGINEER
MARCH 1947

Prop

52.5	64.5
87.4	77.8
78.9	70.4
57.6	157.6
44.3	16.7
44.3	21.5
75.7	338.3
144.3	+10%
173.3	
155.4	
138.7	
123.4	
109.4	
95.4	
109.4	
104.6	
84.6	
77.6	
175.0	
+10%	
173.3	

Scupys

772.1 w yds

