
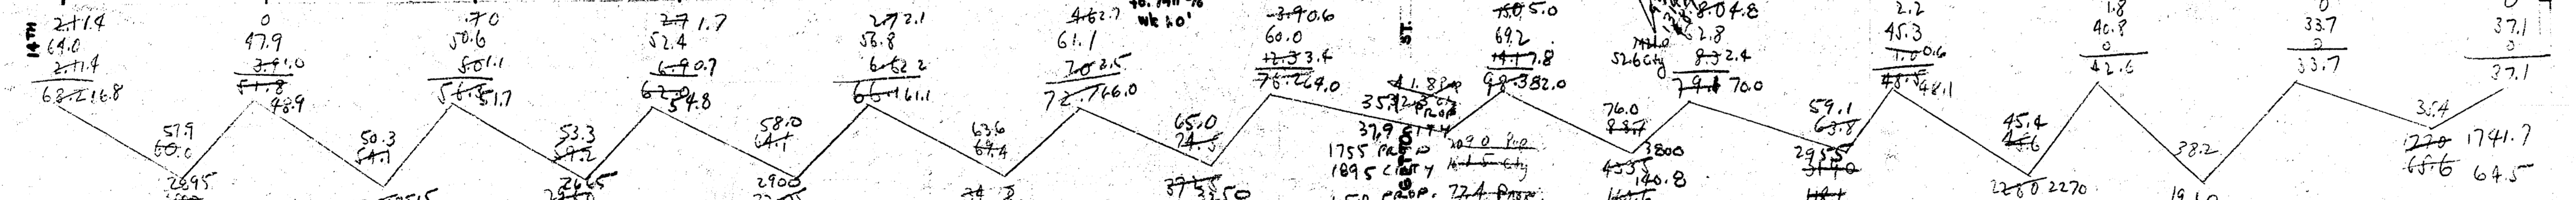


B.M. 124.33 B in Burton App. Wk. E. of Green N. 3. 1944
 B.M. 126.48 Top S. Bolt Top Hyd. S.W. 14th & Green

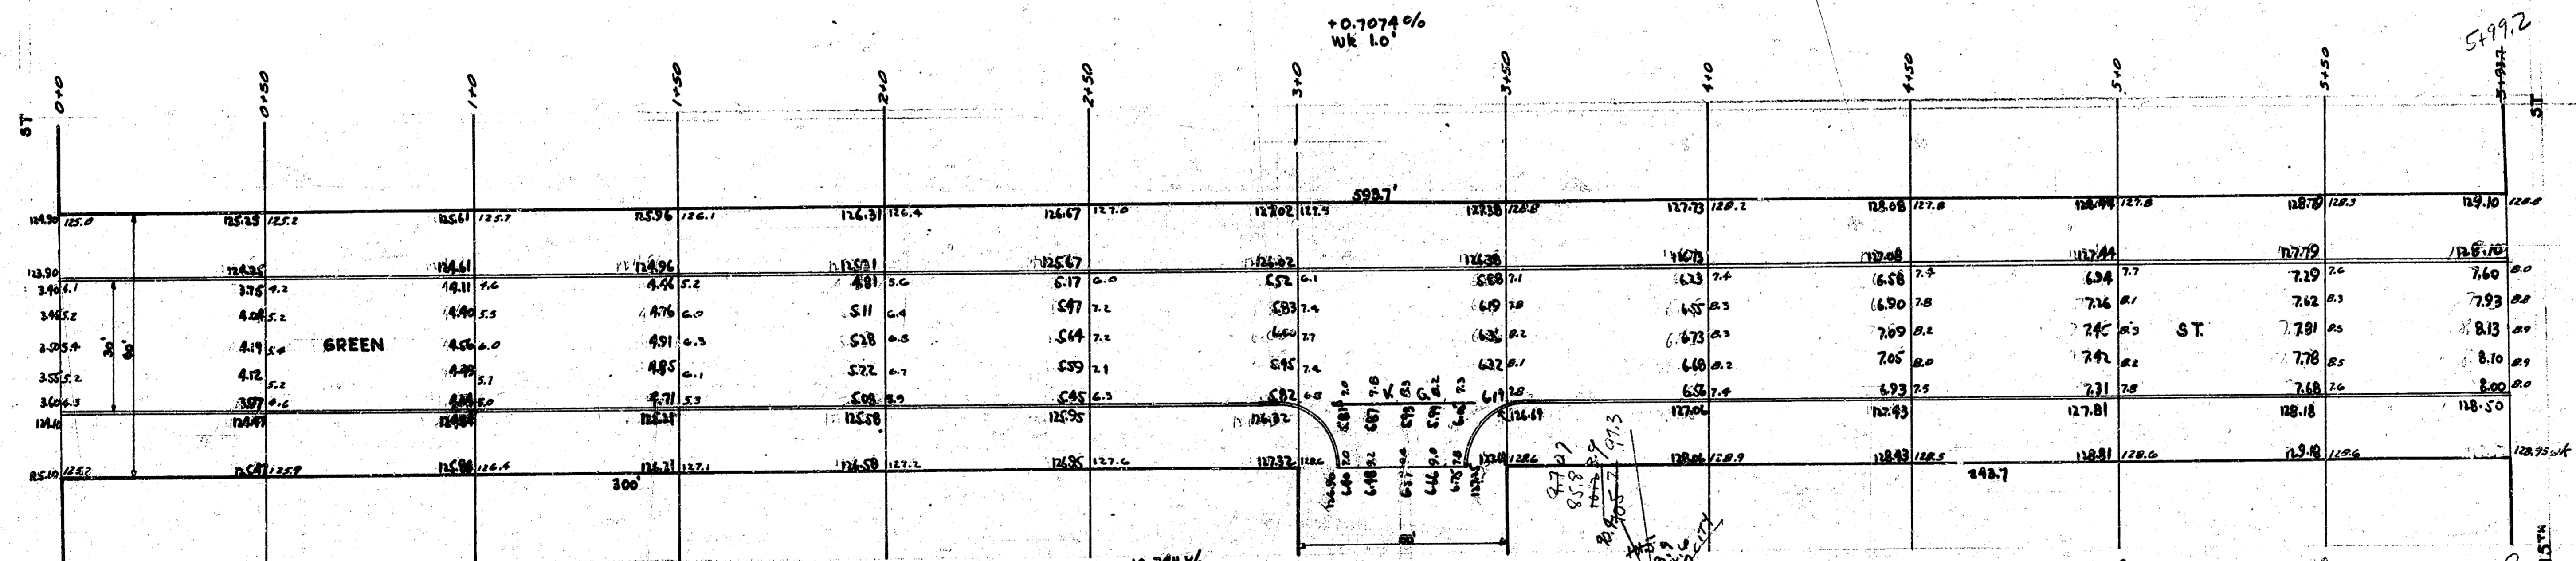

GREEN ST
 N.L. 14TH TO S.L. 15TH
 30' CONCRETE
 CITY OF WICHITA, KANSAS
 L.K. WHITE CITY ENGINEER
 MARCH 1947

4 3 3 1