
B.M. 99.80 - 6" in Globe S.End Cb. W.S. Palisade — NL. Greenway
B.M. 110.03 X" Top Cb. N.S. Hinkaid — Near E.L. Greenway

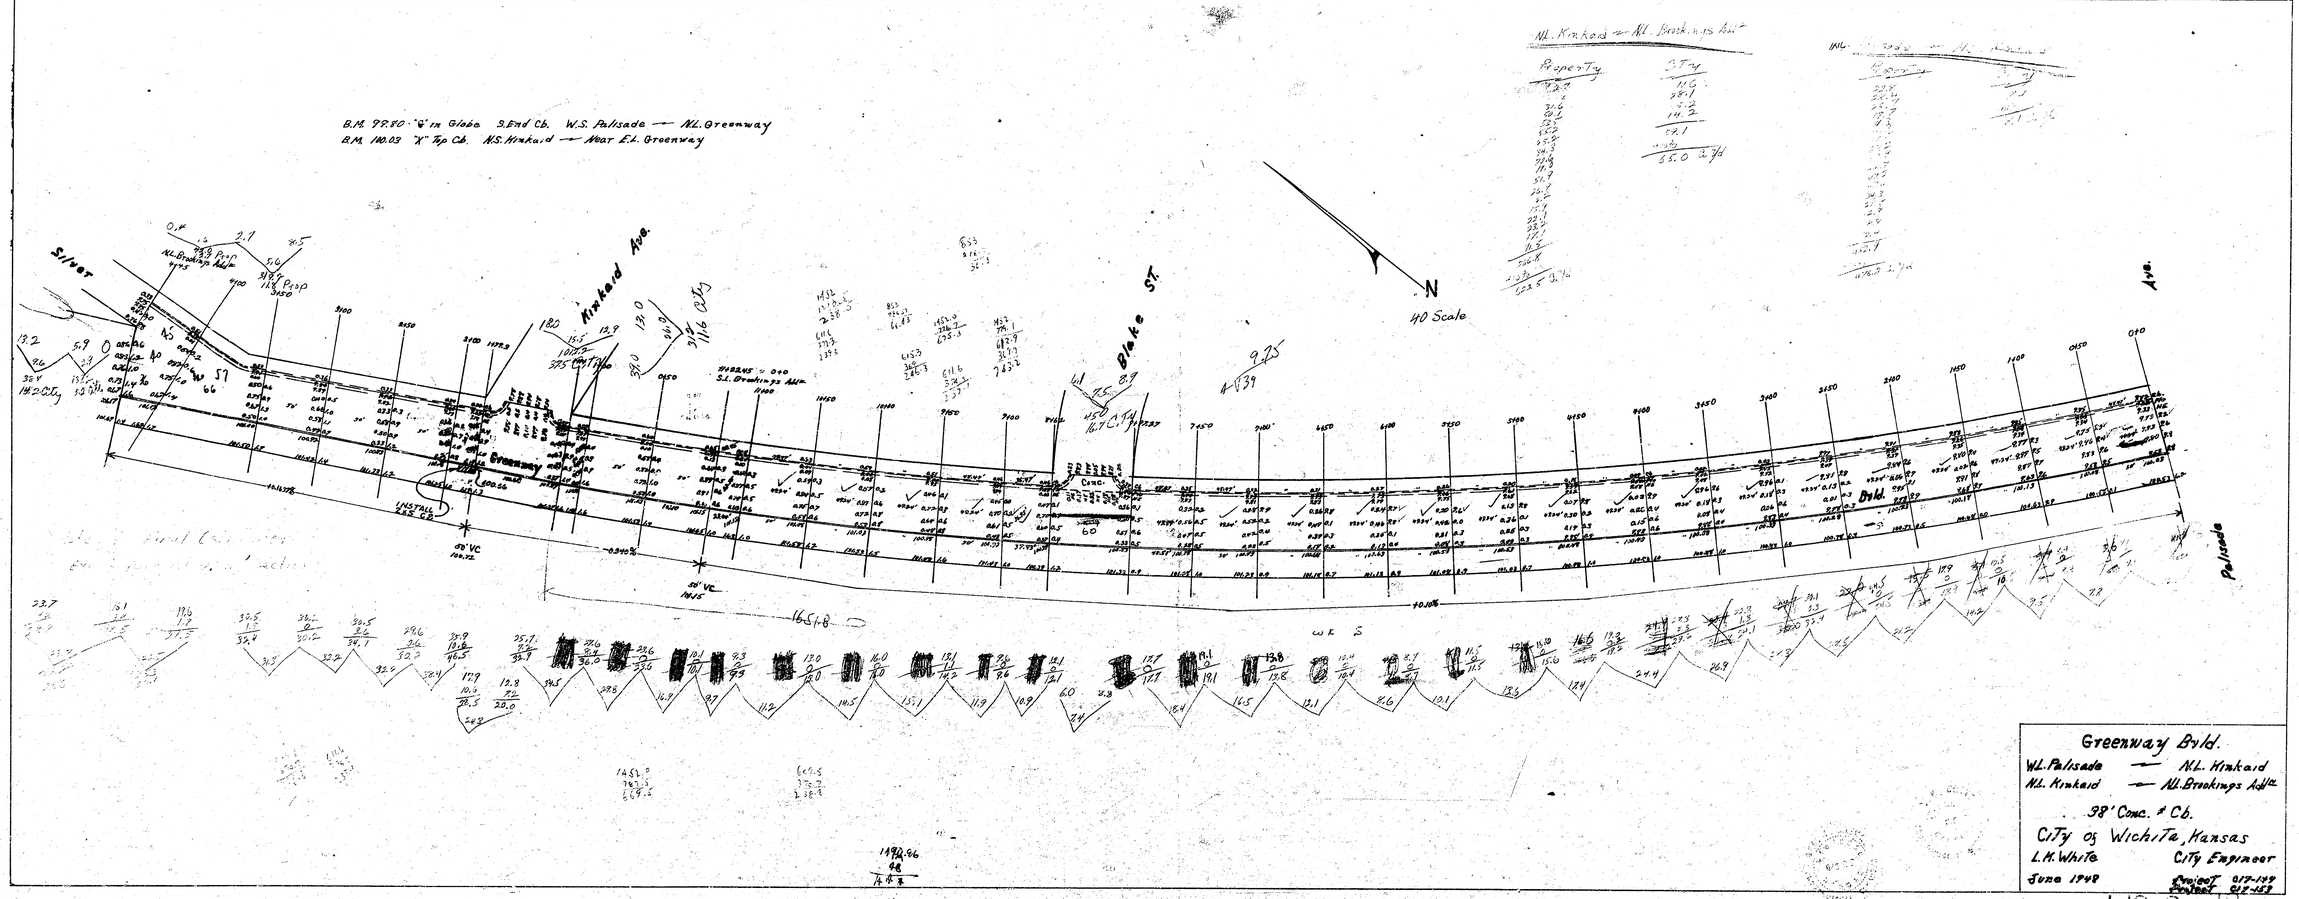

NL. Hinkaid — NL. Brookings Add'n

Property	City
	11.6
	28.1
	13.2
	14.2
	CR 1
	55.0 2/4

Greenway Blvd.
WL. Palisade — NL. Hinkaid
NL. Hinkaid — NL. Brookings Add'n
98' Conc. # Cb.
City of Wichita, Kansas
L.H. White City Engineer
June 1948
Project 017-129
Contract 017-103

1492.46
98
744

413 18