



3.19 92.54 N.W. Cor. Porch next to gar. wall, Ho # 2916 Greenwood

Stations on 9° offset from E.R.

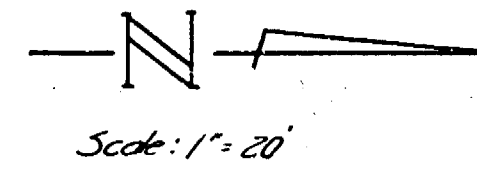

Scale: 1" = 20'

Surveyed by
Checked by
B.E. Smith
B.E. Smith
B.E. Smith
B.E. Smith

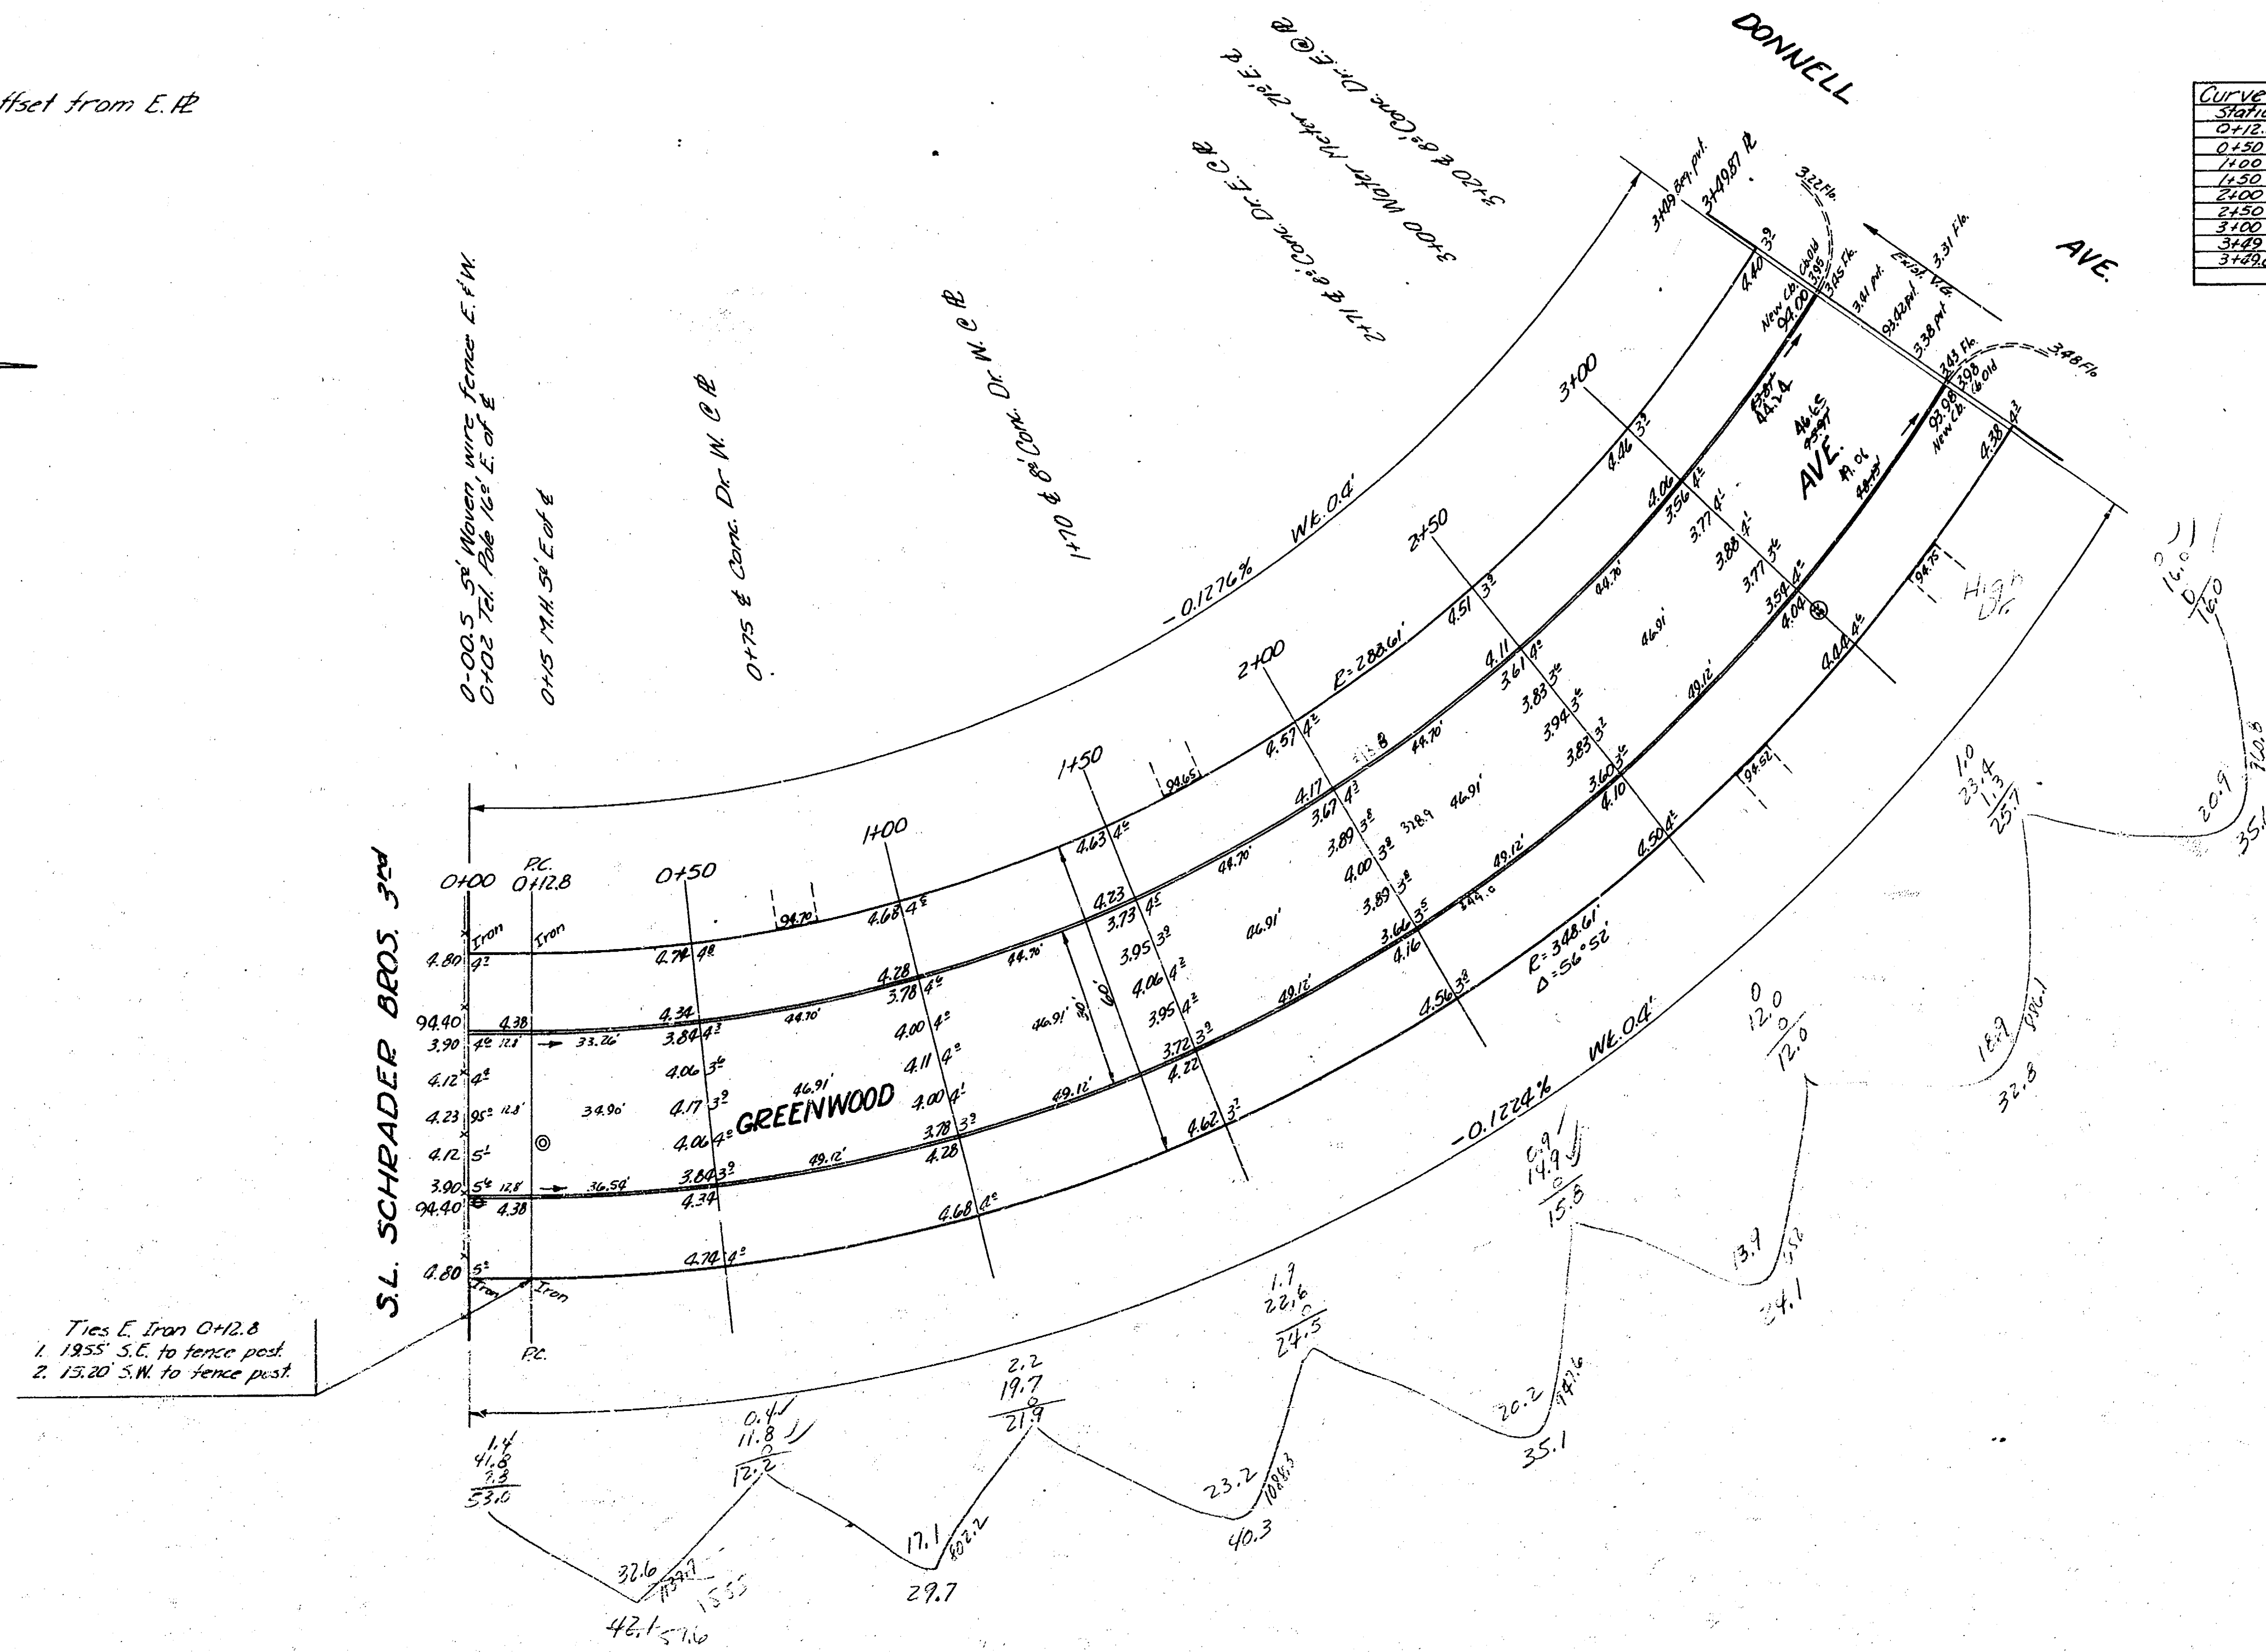

Curve Data for 4° OFFSET FROM FACE OF E. CB				
Station	Offset	Offset	Offset	Offset
0+12.8 R.C.	32.20	32.18	33.20	31.08 16"

Excav.
Prop.
City
412.7
24.0
Total 283.7 cu. yd.



GREENWOOD AVE.
SL. DONNELL - SL. SCHRADER BROS. 30'
30' CONG. I.C.B.
CITY OF WICHITA, KANS.
B.E. SMITH CITY ENGINEER
AUG. 1953 PROJ. NO. C13-121