

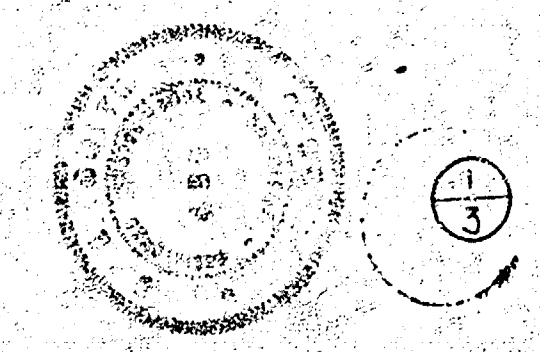


PAVING PLAN 1943
 GROVE ST. - S.L. SHADYBROOK ADD^N to S.L. 21ST ST.
 13' 6" CONCRETE

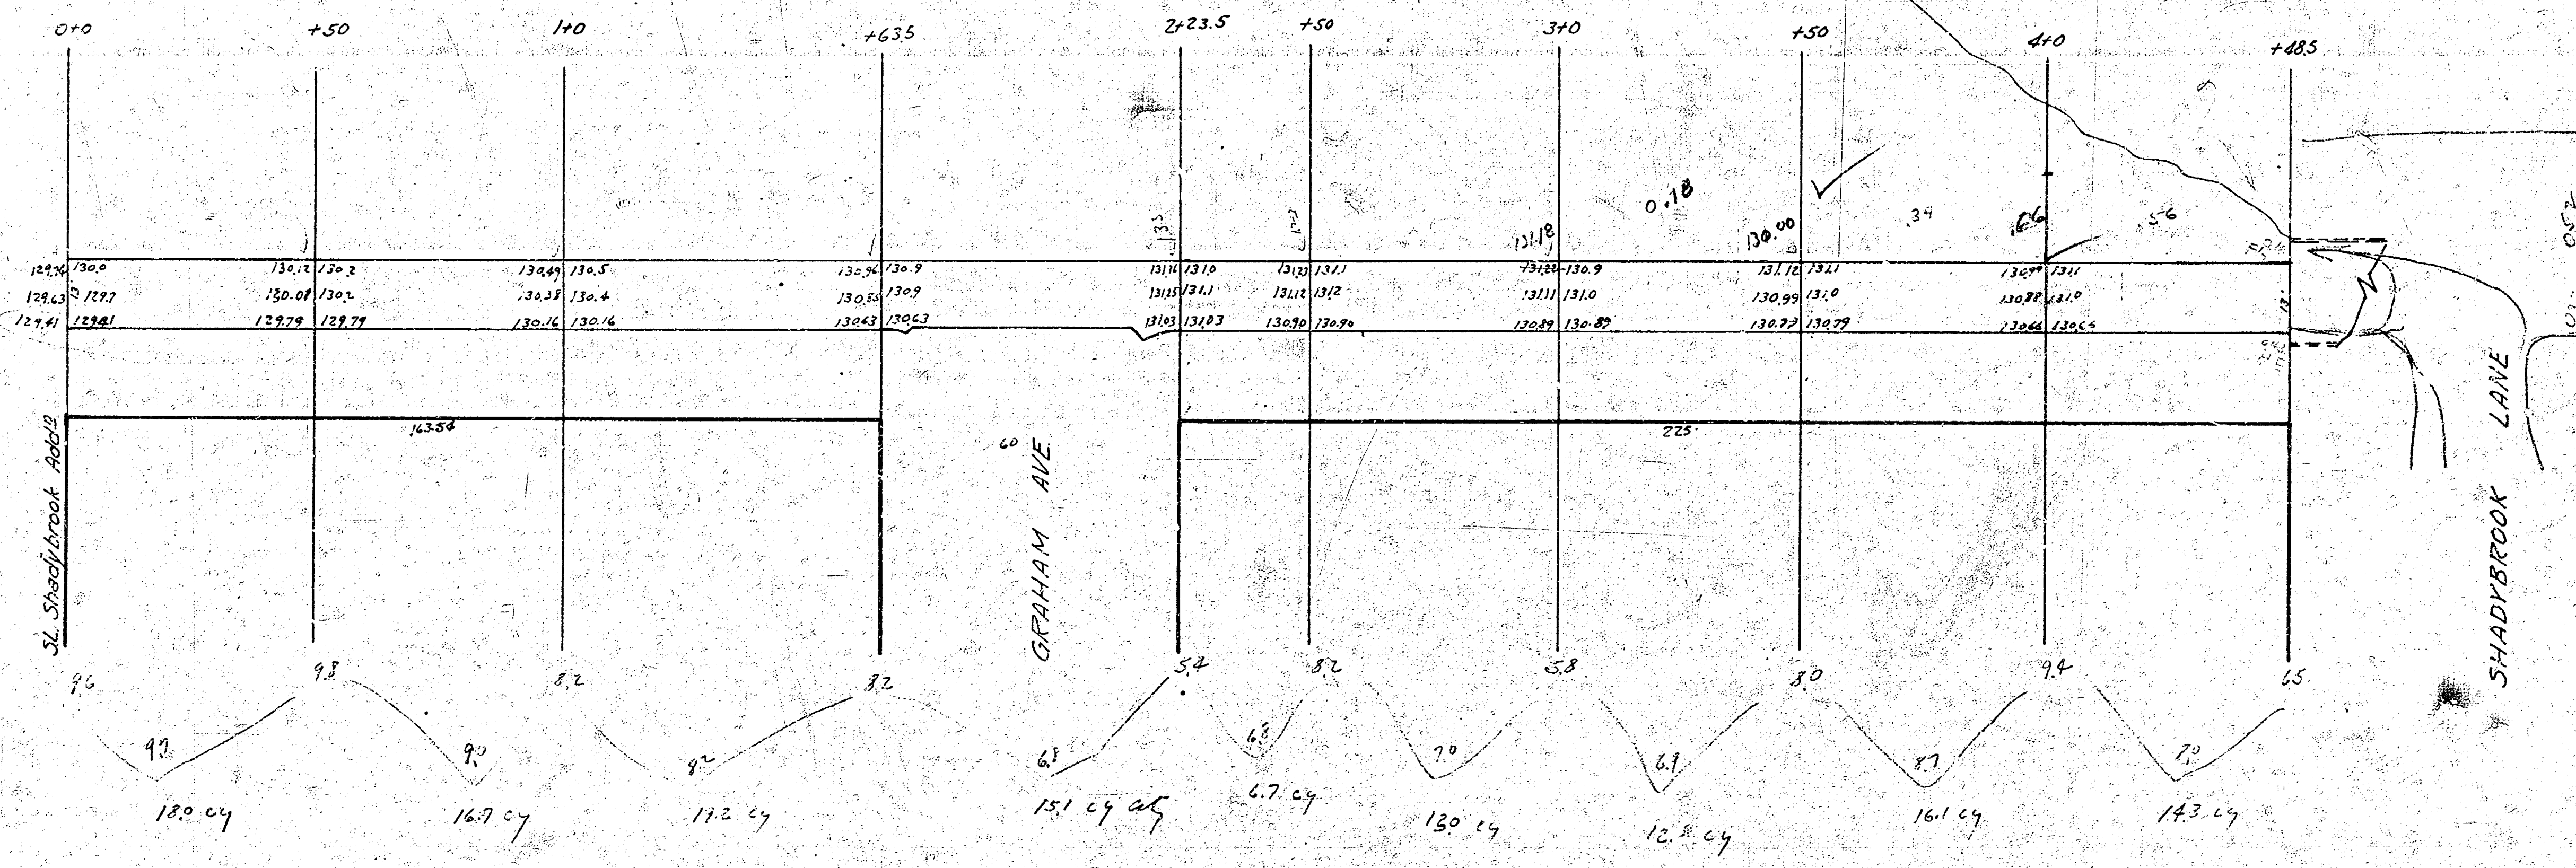

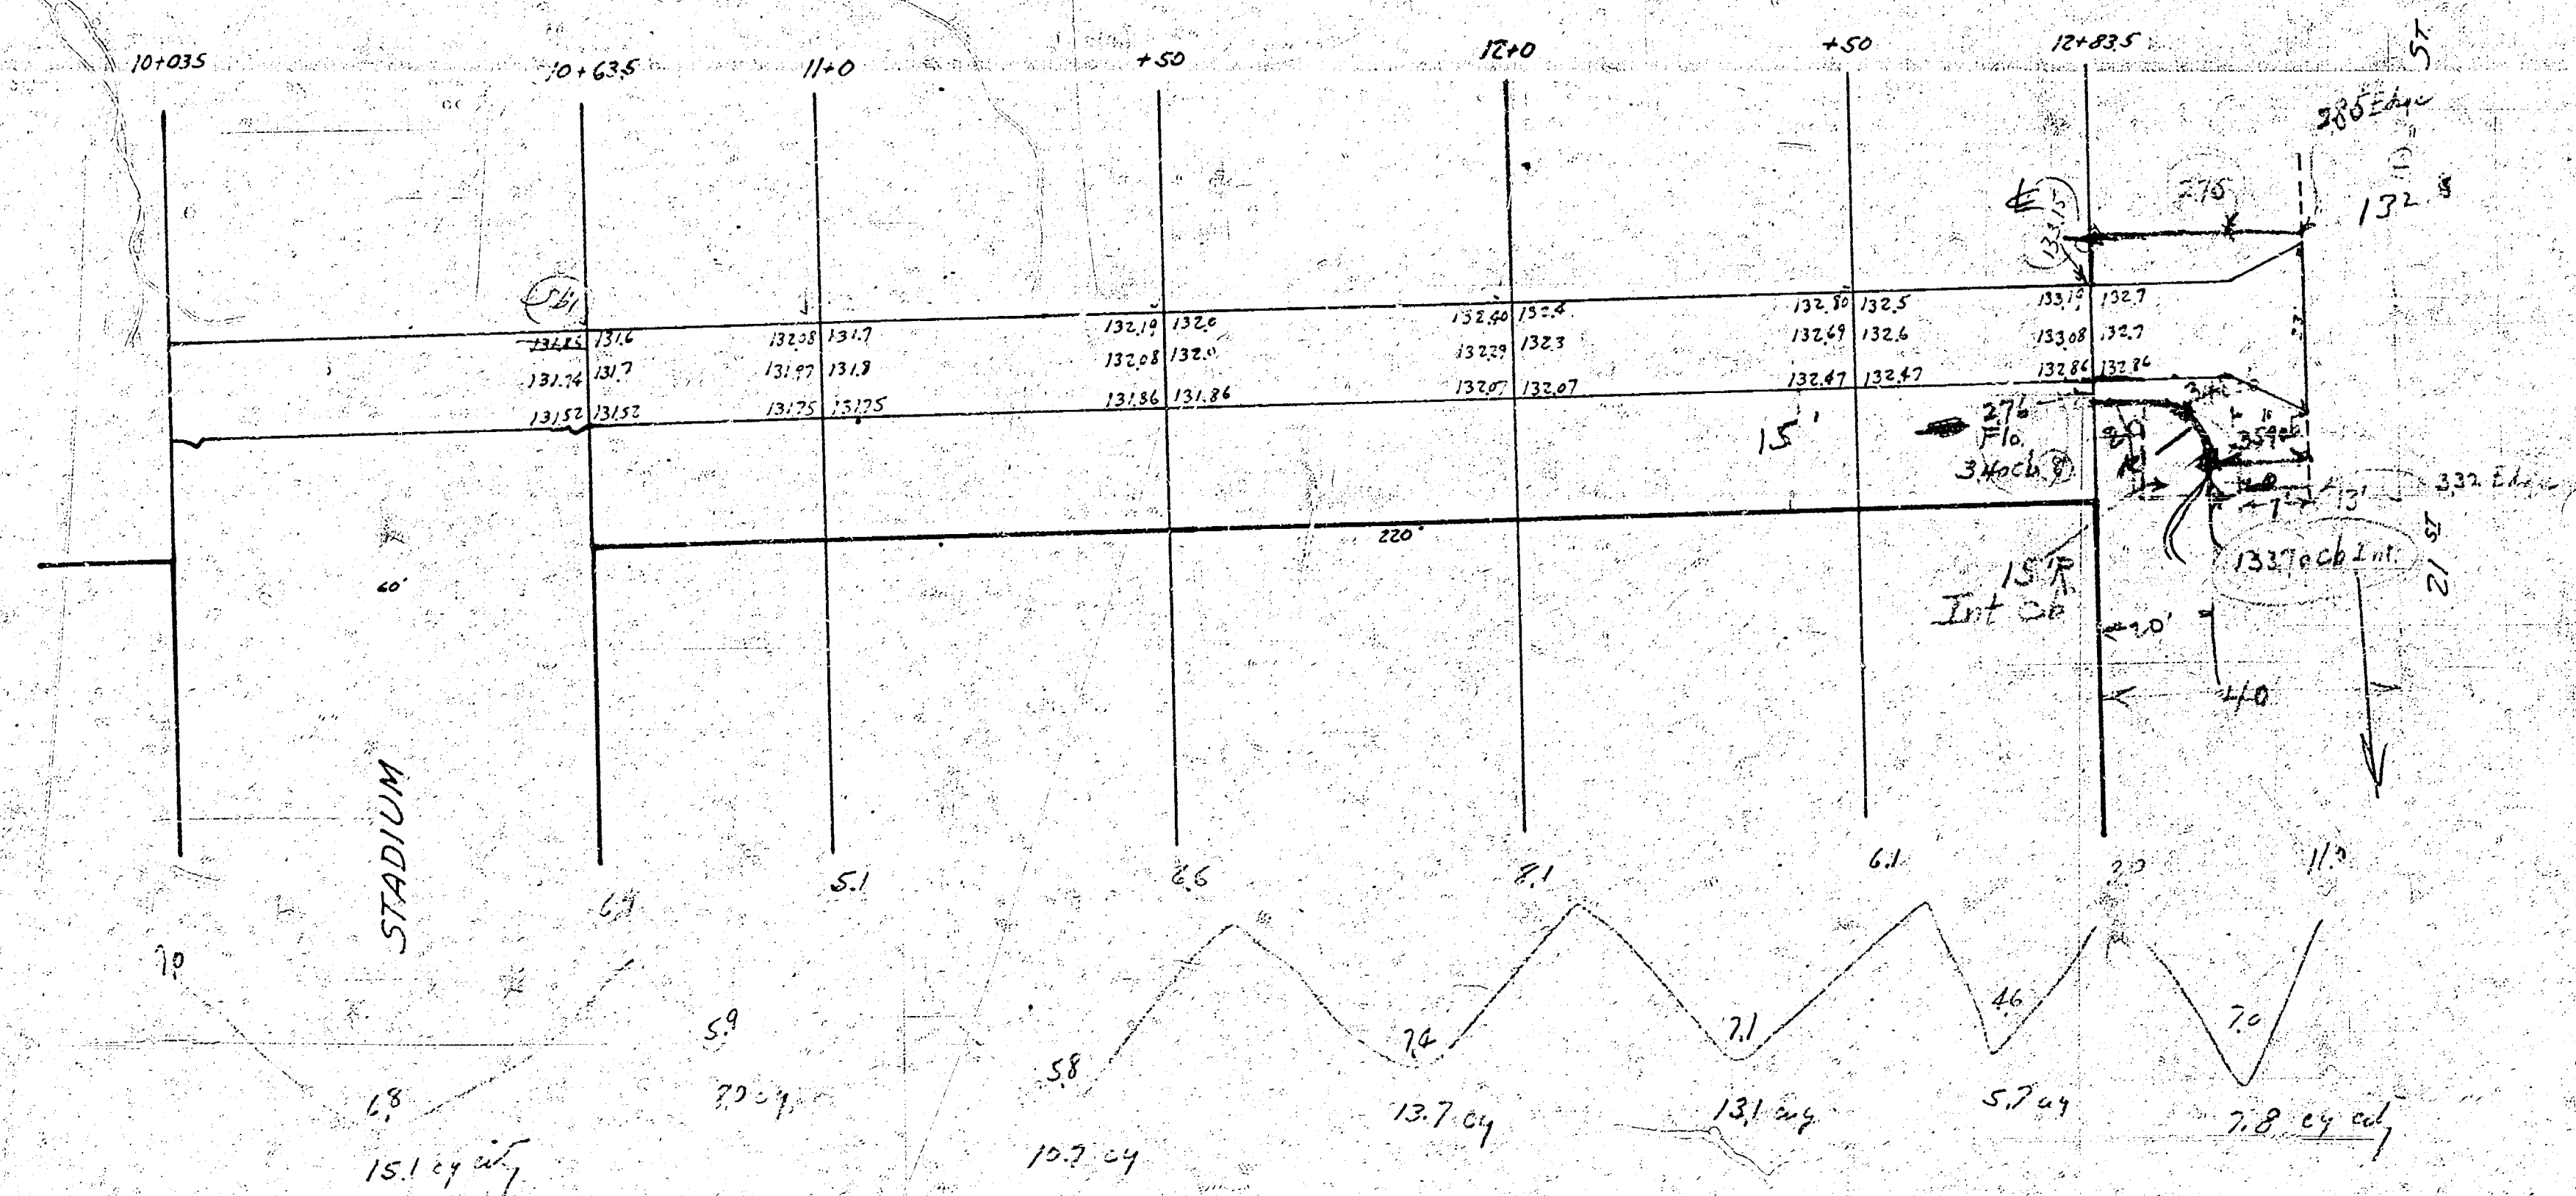

Price 30.59
 +10% 3.06
 Total 33.65

Why 607
 1170 62
 720 667 69

