Book 43


B.M. 126.76 "T" in Troy Top Hydrant, S.W. Cor. 17th & Grove

Note to Field Engineer: This Bench Mark is to be used only for setting grades on this plan. Elevation is approximately 0.2' too high.

LAB

Property
18.9
18.9
19.6
18.1
16.1
15.7
15.9
15.9
15.0
16.2
18.5
23.5
211.9 cu yds.
+10% 21.1
233.0

+0.185%
WK.0.6'

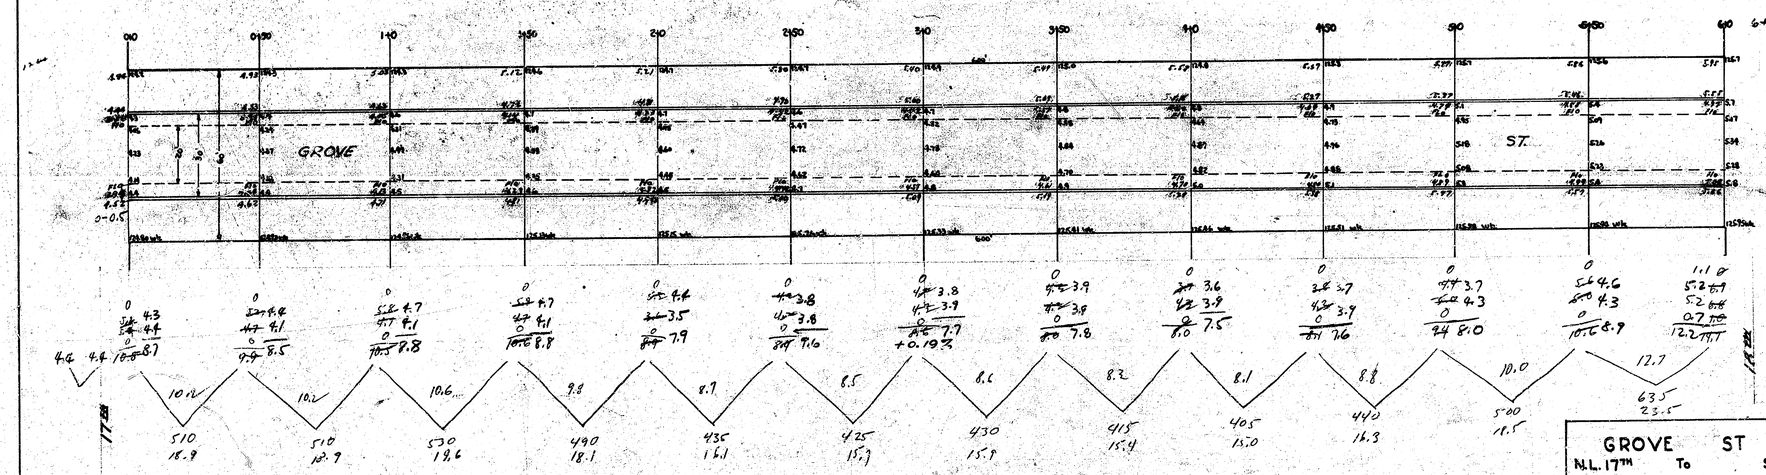

GROVE ST
N.L. 17TH To S.L. 18TH
Conc. & C.& Widen to 30'
City of Wichita, Kansas
L.K. White City Engineer
February 1948 C-17-159

24 Jun

4155 (e)