


Harding N.L. 3rd - SL Central

26' - corner.

B.M. Elev. 171.59 E. C.B. NL 3rd - Harding.

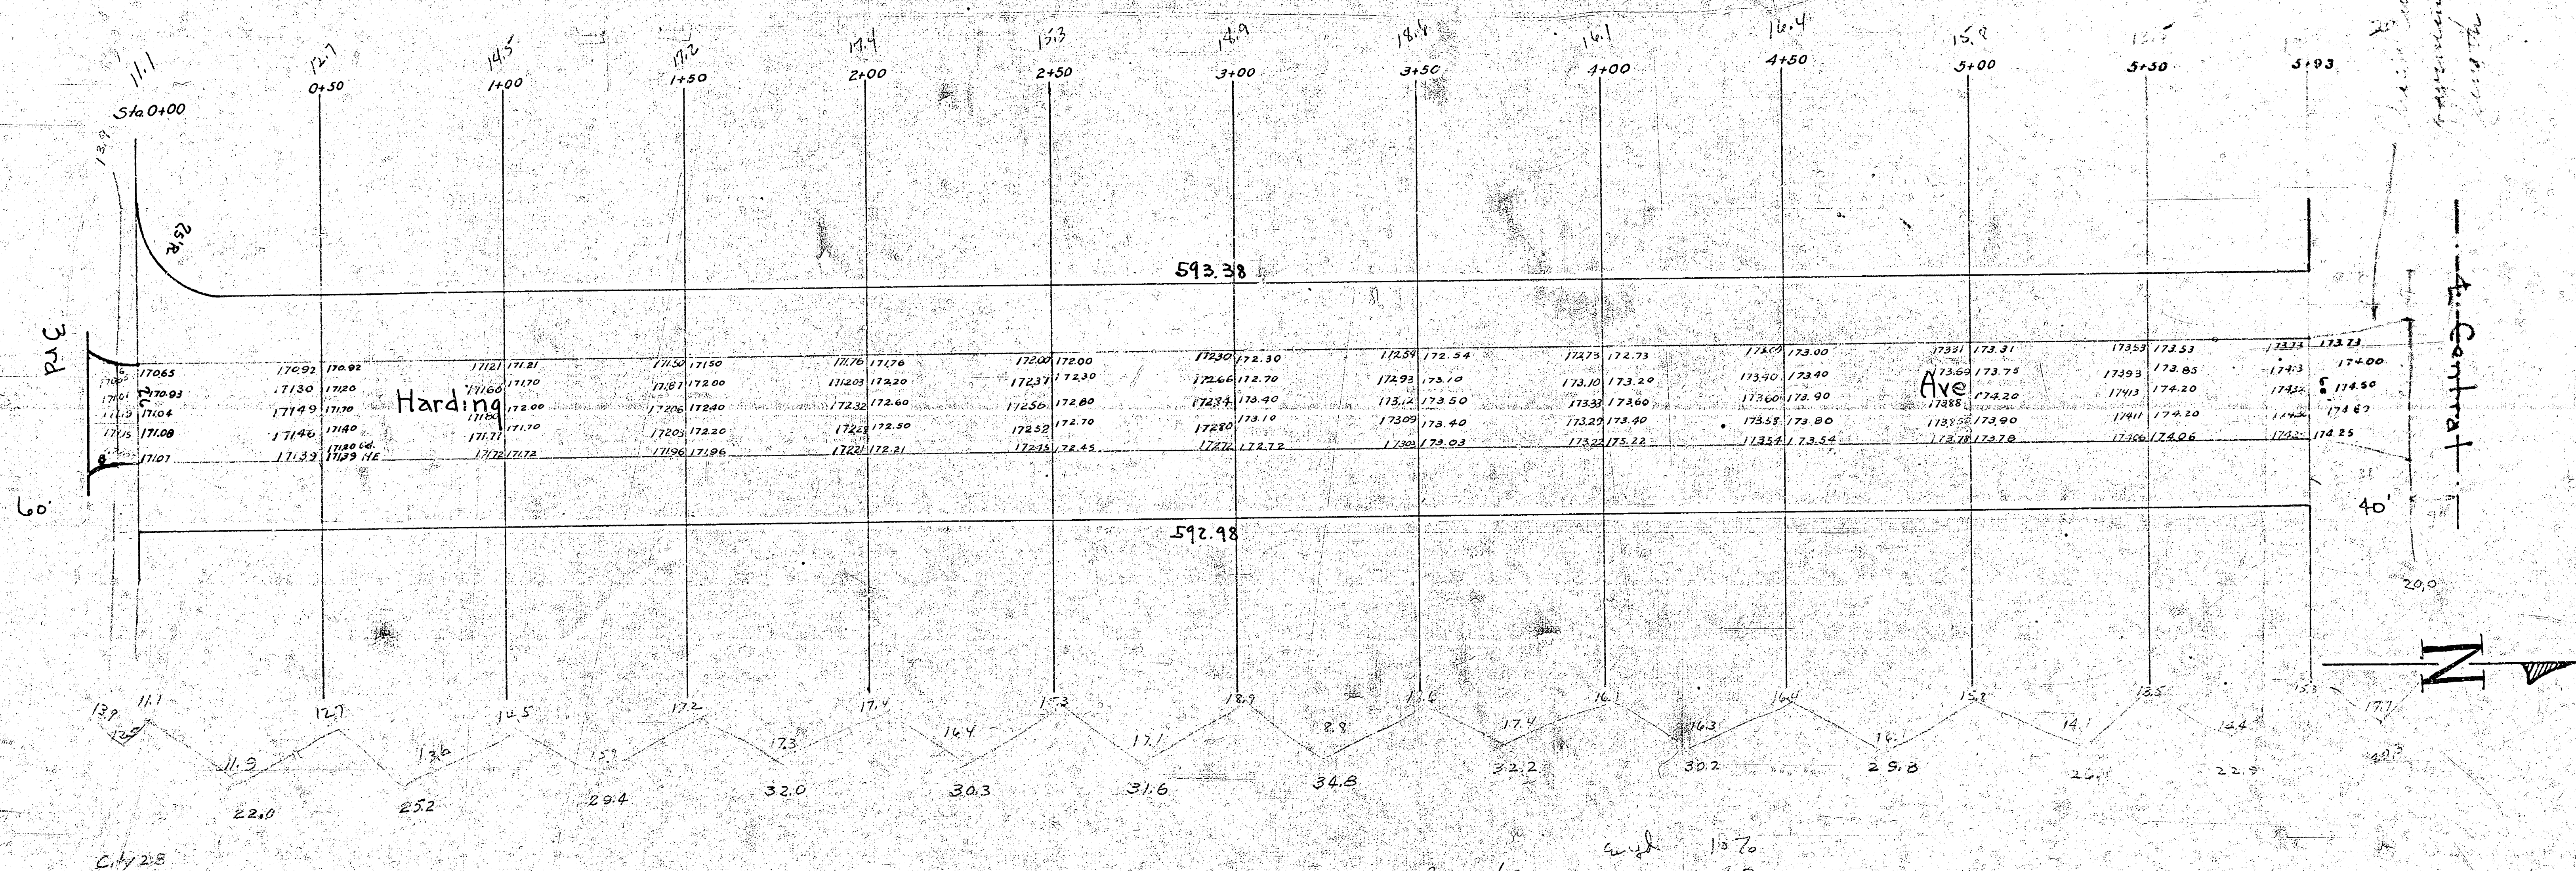

Property — 346.5 + 34.7 = 381.2
 City — 23.1 + 2.3 = 25.4
 Total — 406.6

