


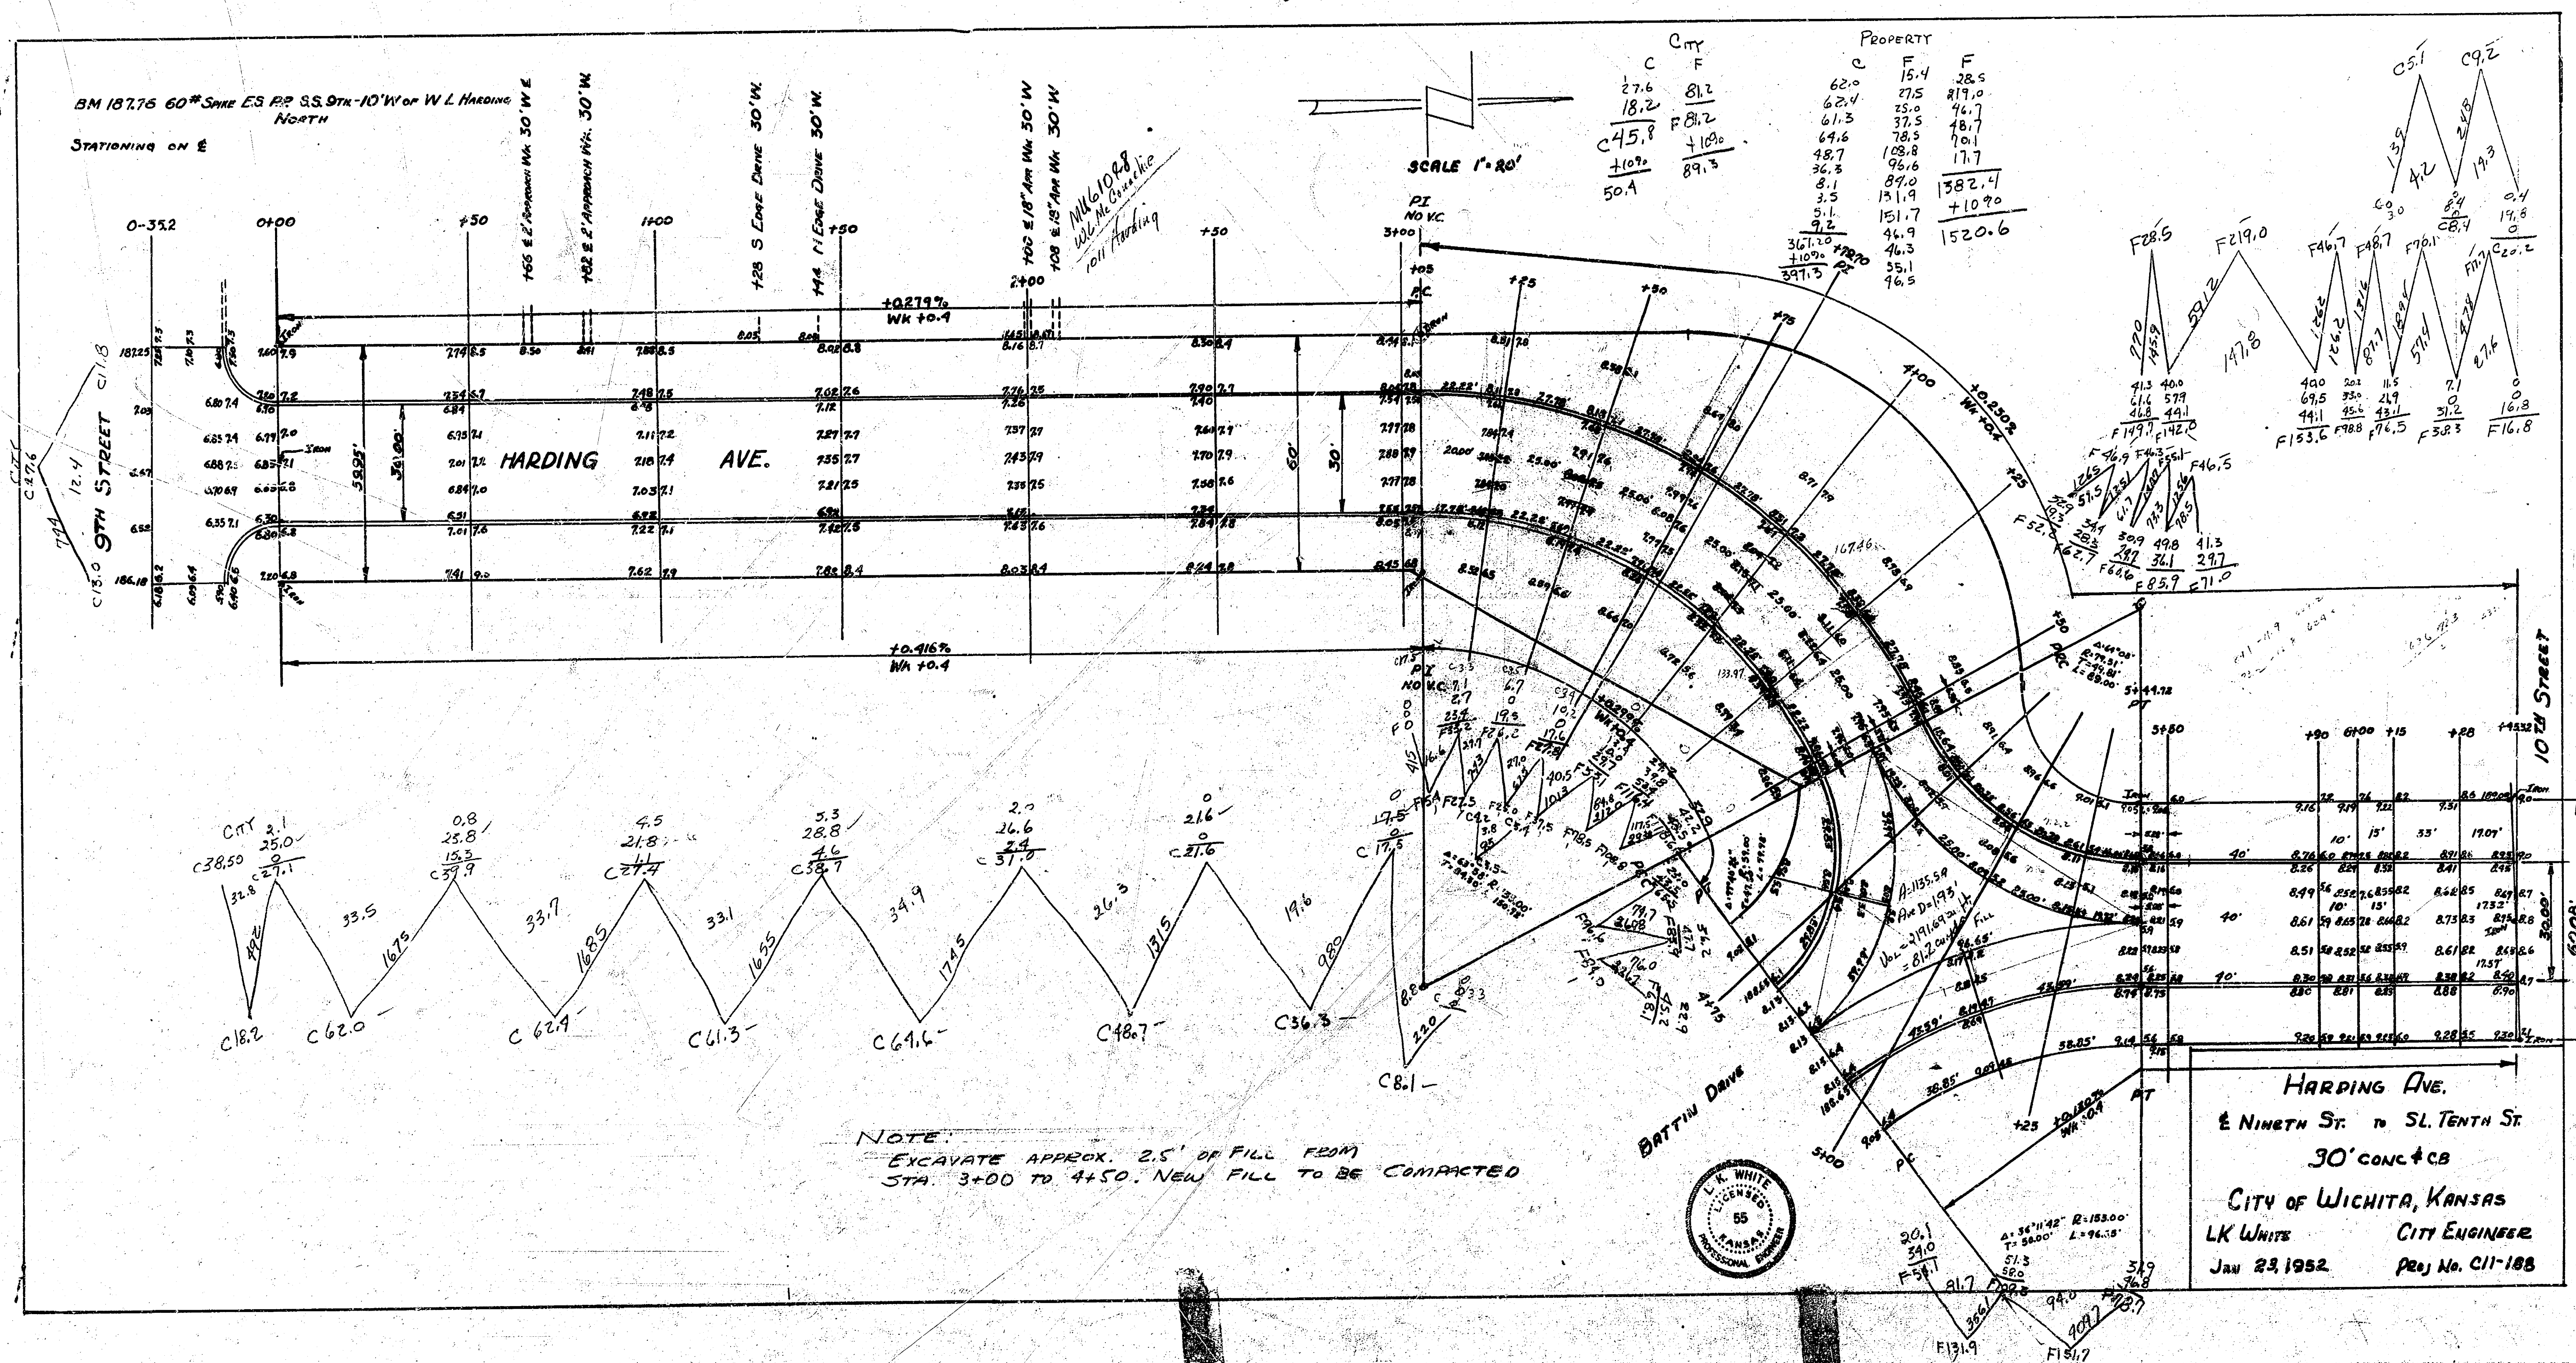

B.M. 185.00 "T" in Tree Top Hyd. NW Cor. 8th & Harding

Property

C. 7-4

47

110.8



5.2 2.30

35.6
41.7
40.0
40.0
42.5
48.0
41.3
39.4
39.1
40.7
42.5
478.0
-10.8
525.8 2.30

N

2.5

2.5

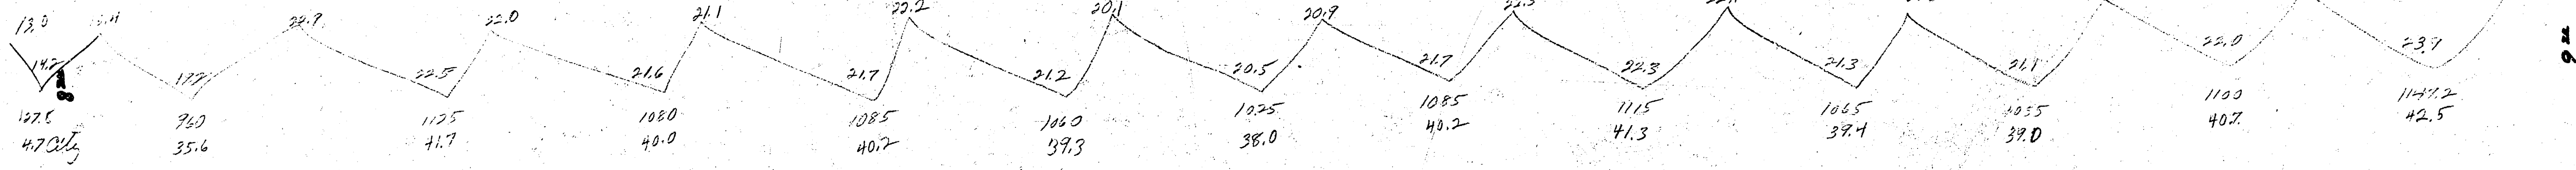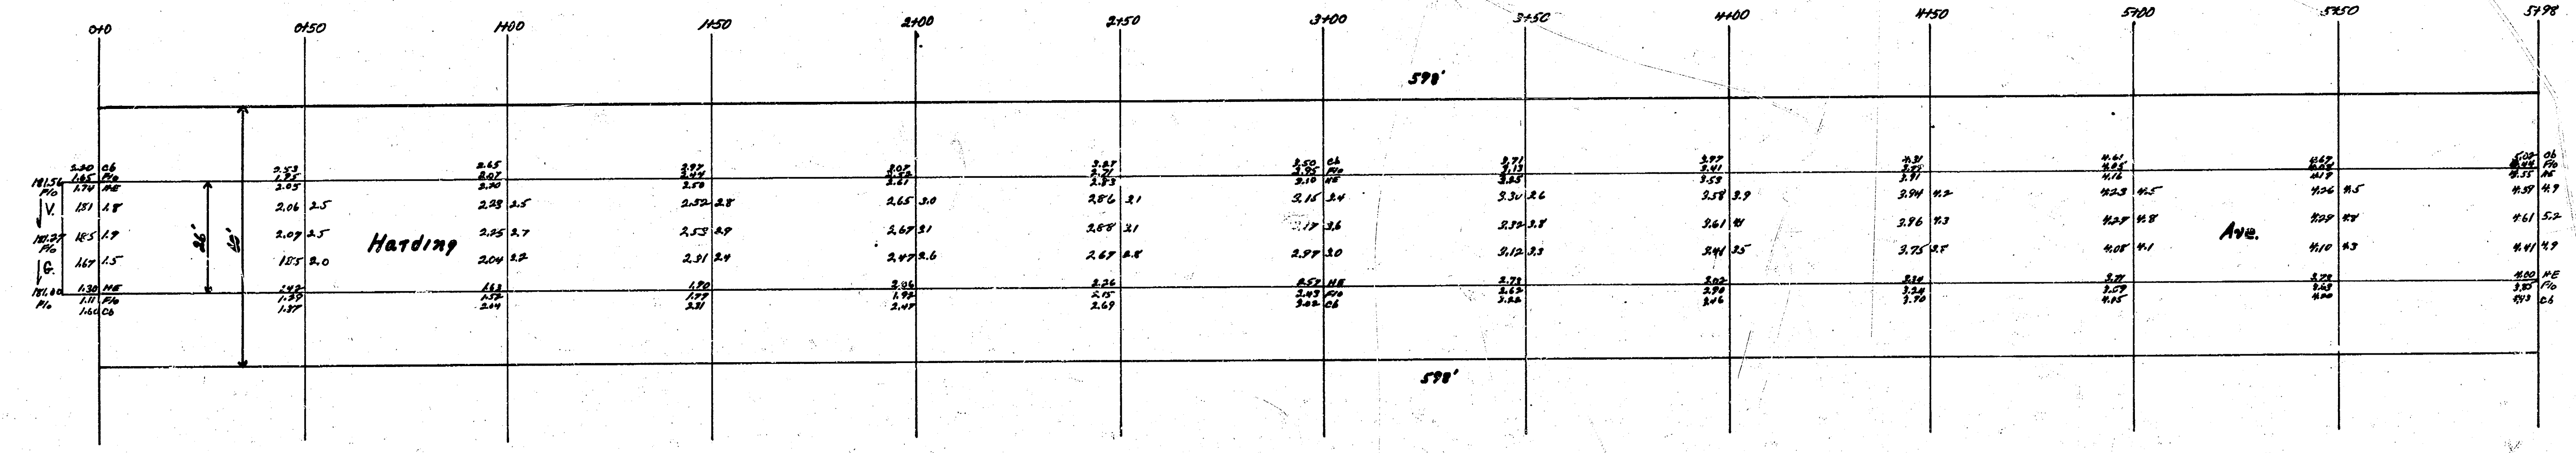

Elev. of Int.
Force Acct.
G. C. Co.
5/10/29

Harding Ave.
N.L. 8th SL 9th
26' Conc.
City of Wichita, Kansas
L.M. White City Engineer
May 1948 Project C18-69