


PAVING PLAN 1943
HARDING AVE - S.L. MURDOCK to NL. PINE ST.
26' CONC.

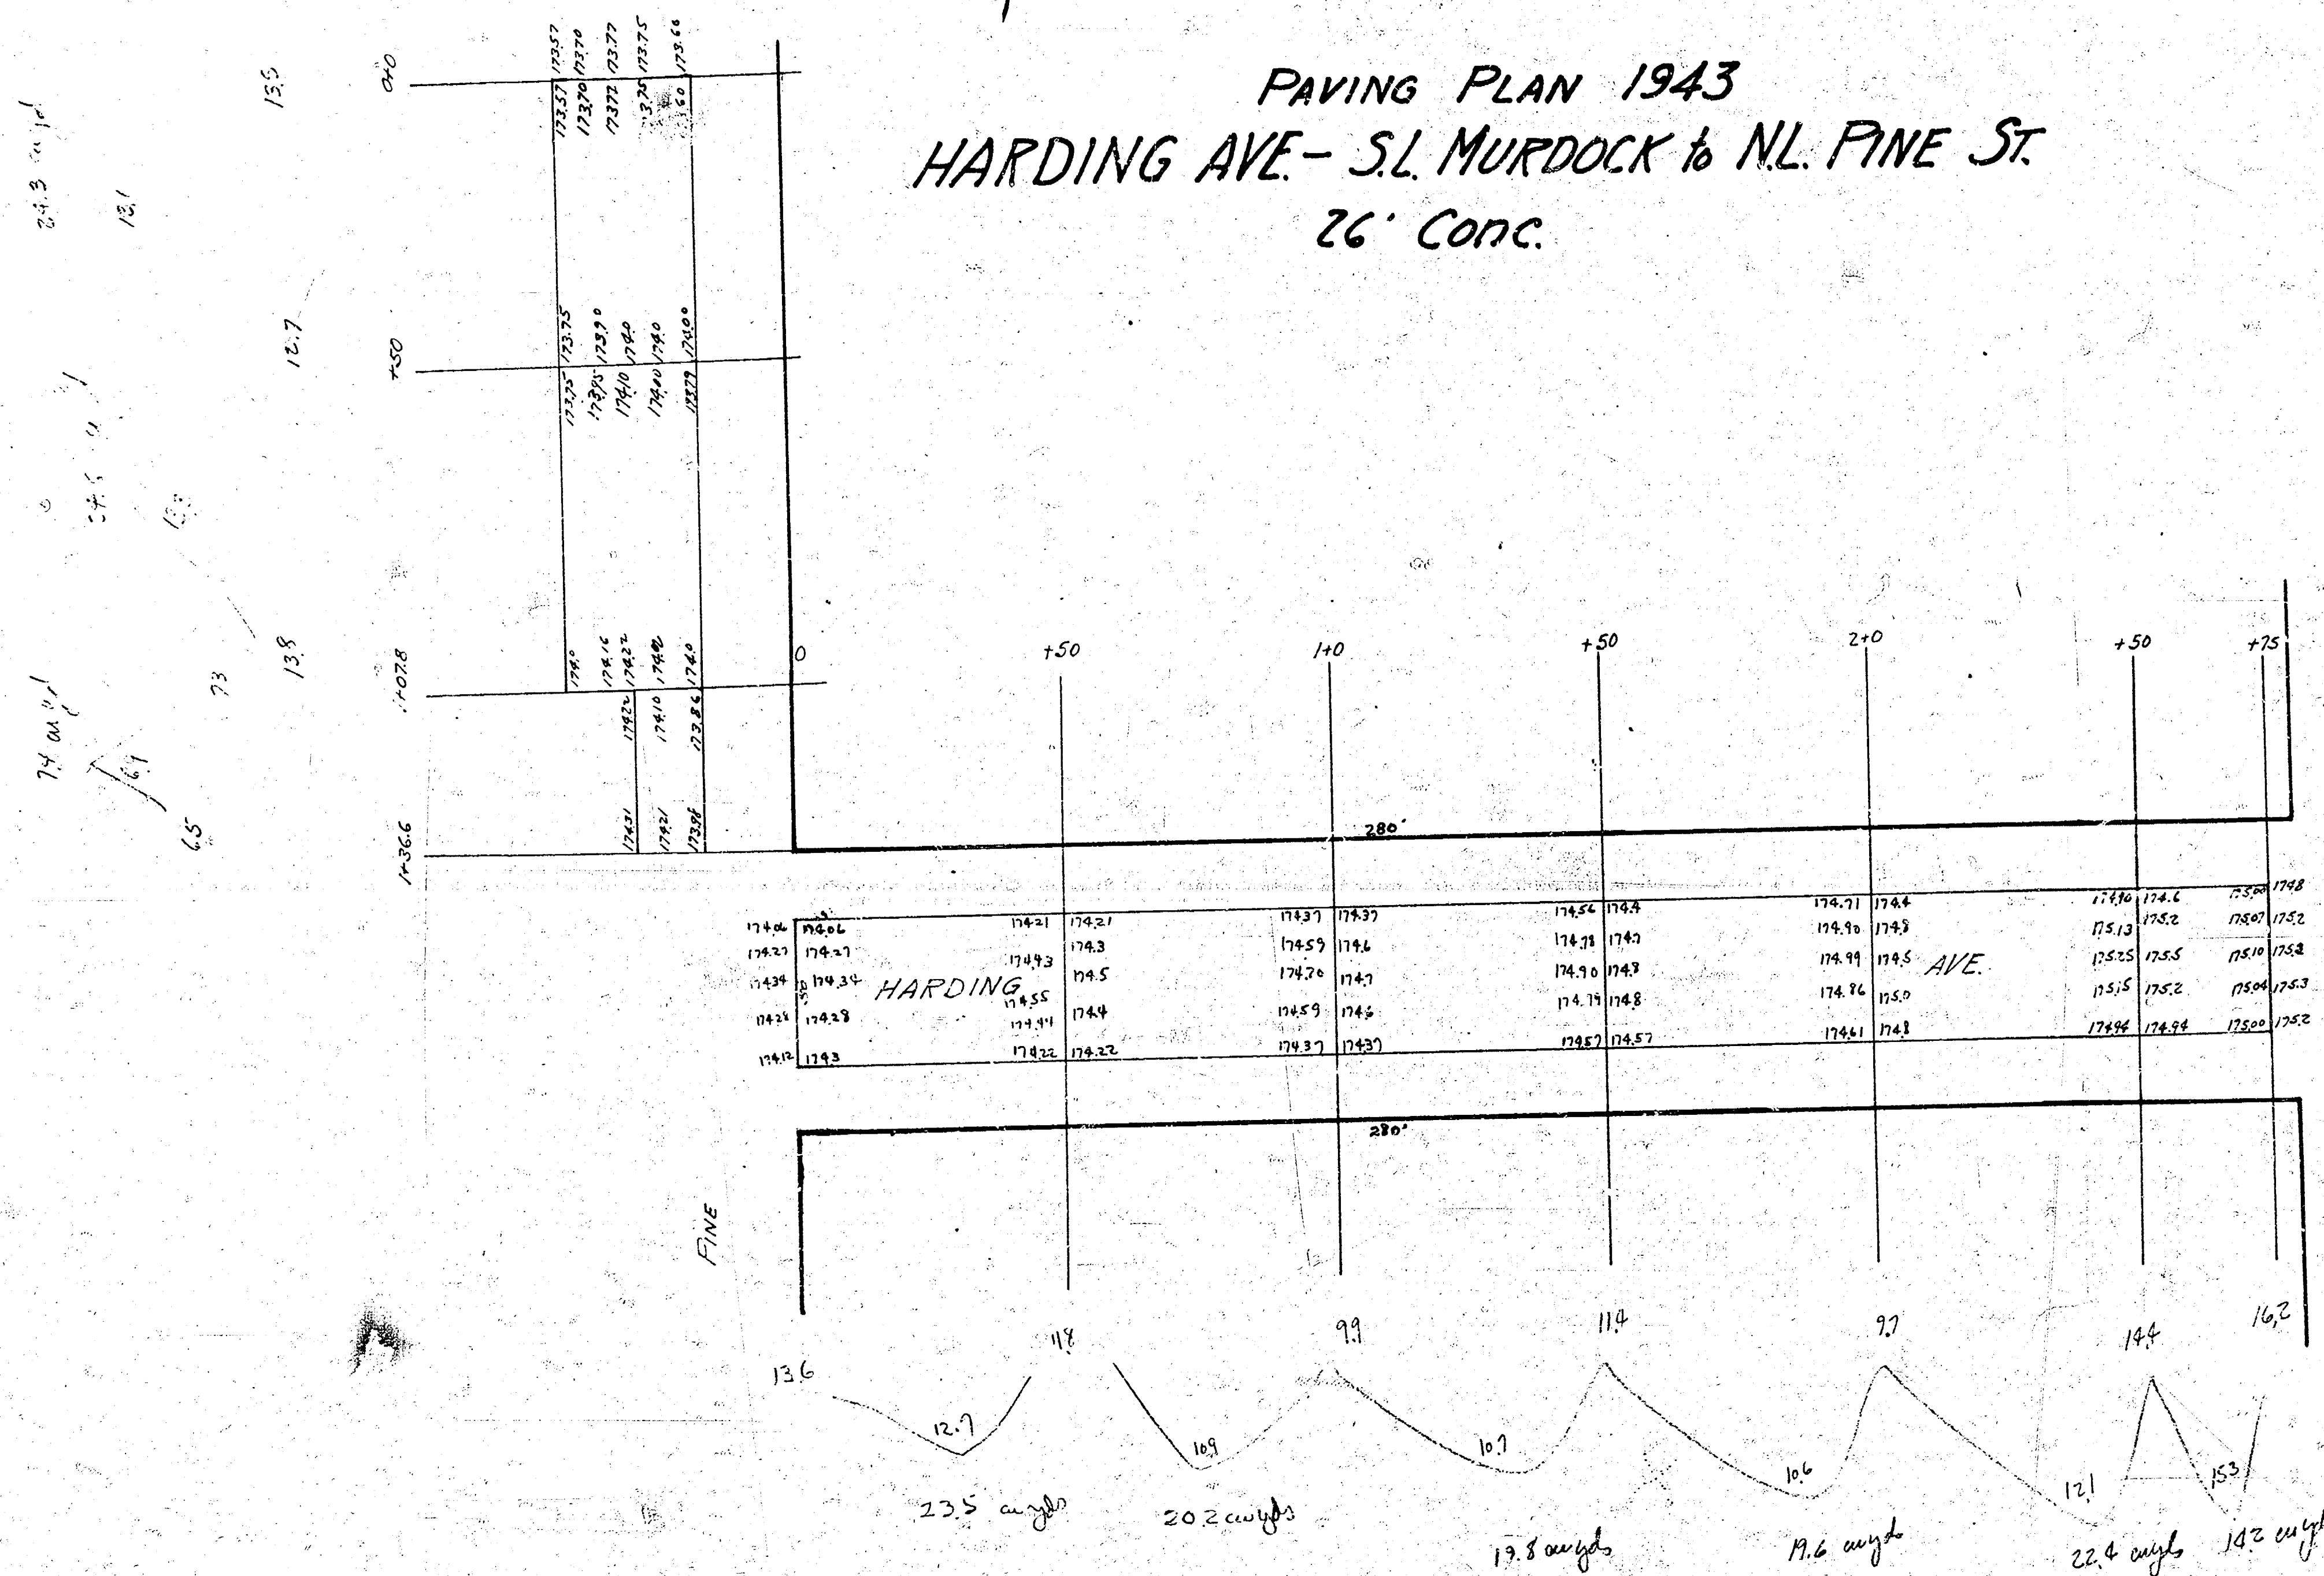

Parity = 112.7' angle
Total = 131.6' angle

5.3' angle
Total = 61.9' angle