

BK #2



R.R. 119.92 Top Thimble 12" & Woodland
 D.M. 119.29 Iron in Thimble 12" & Heiserman

Property

55.6
 76.5
 77.0
 76.3
 24.8
 45.1
 416.3
 457.9 476

Drive

Ties on Iron at S.L. Ferrell Drive & Heiserman
 West Side
 213' SW 1/4 NE 1/4 Foundation House #1927 N Heiserman
 228' SW 1/4 NE 1/4 Or. Stage Platform of Said House
 168' E. 16 E. 8" Chinese Elm
 East Side
 50' S. of West Iron
 127' NE 1/4 Center of Crotch in a double Paradise Tree
 135' NE 1/4 Center of Crotch in a Triple Paradise Tree
 135' SE 1/4 NW 1/4 Cor. of Foundation of House #1920

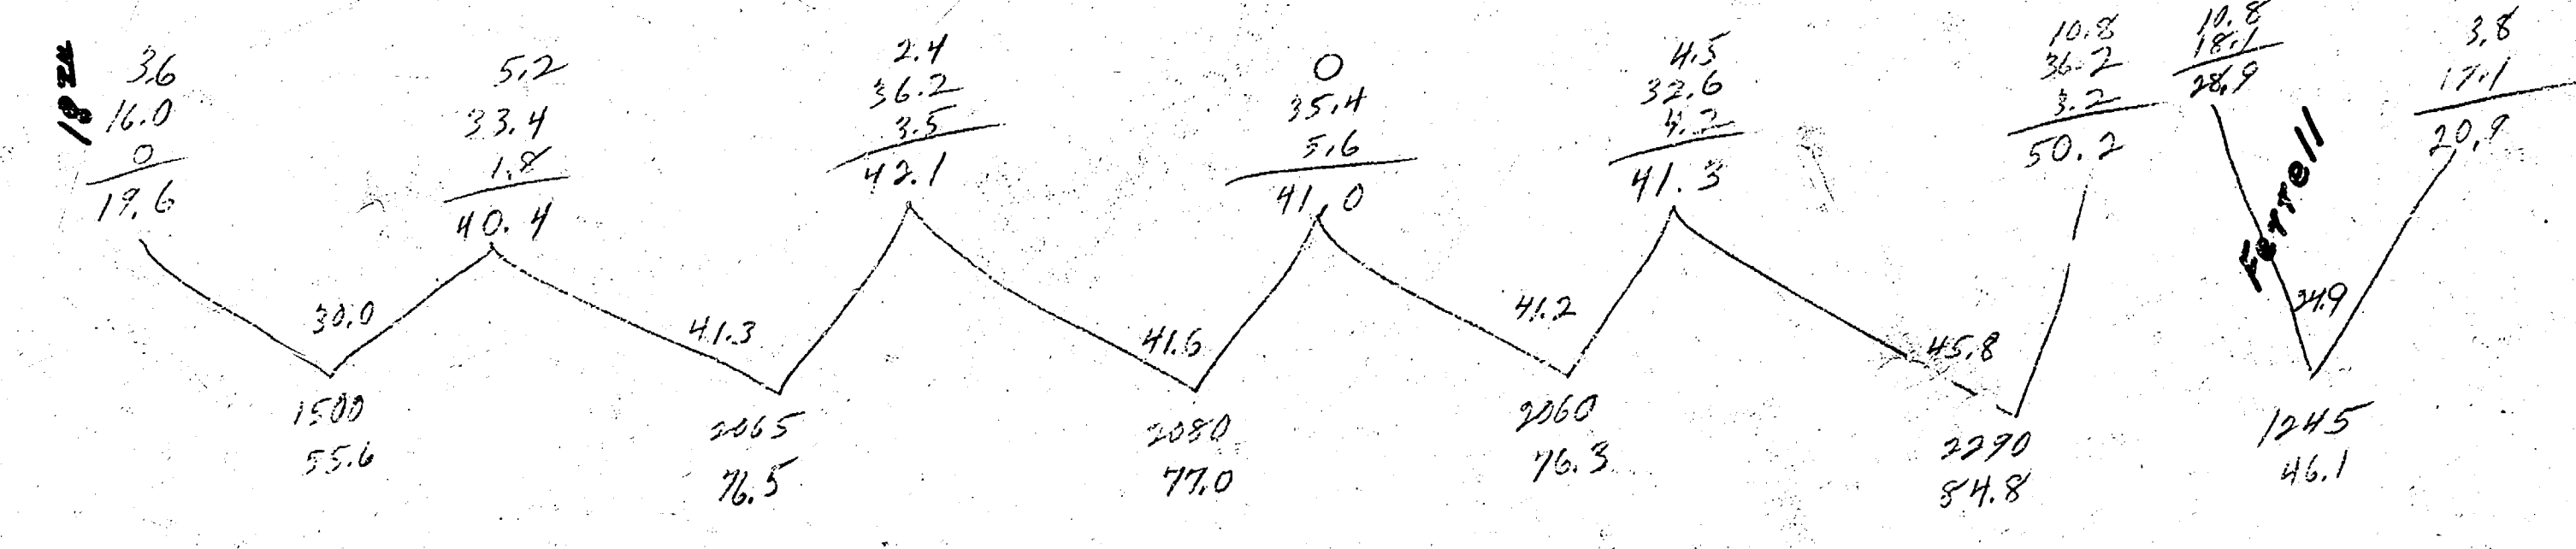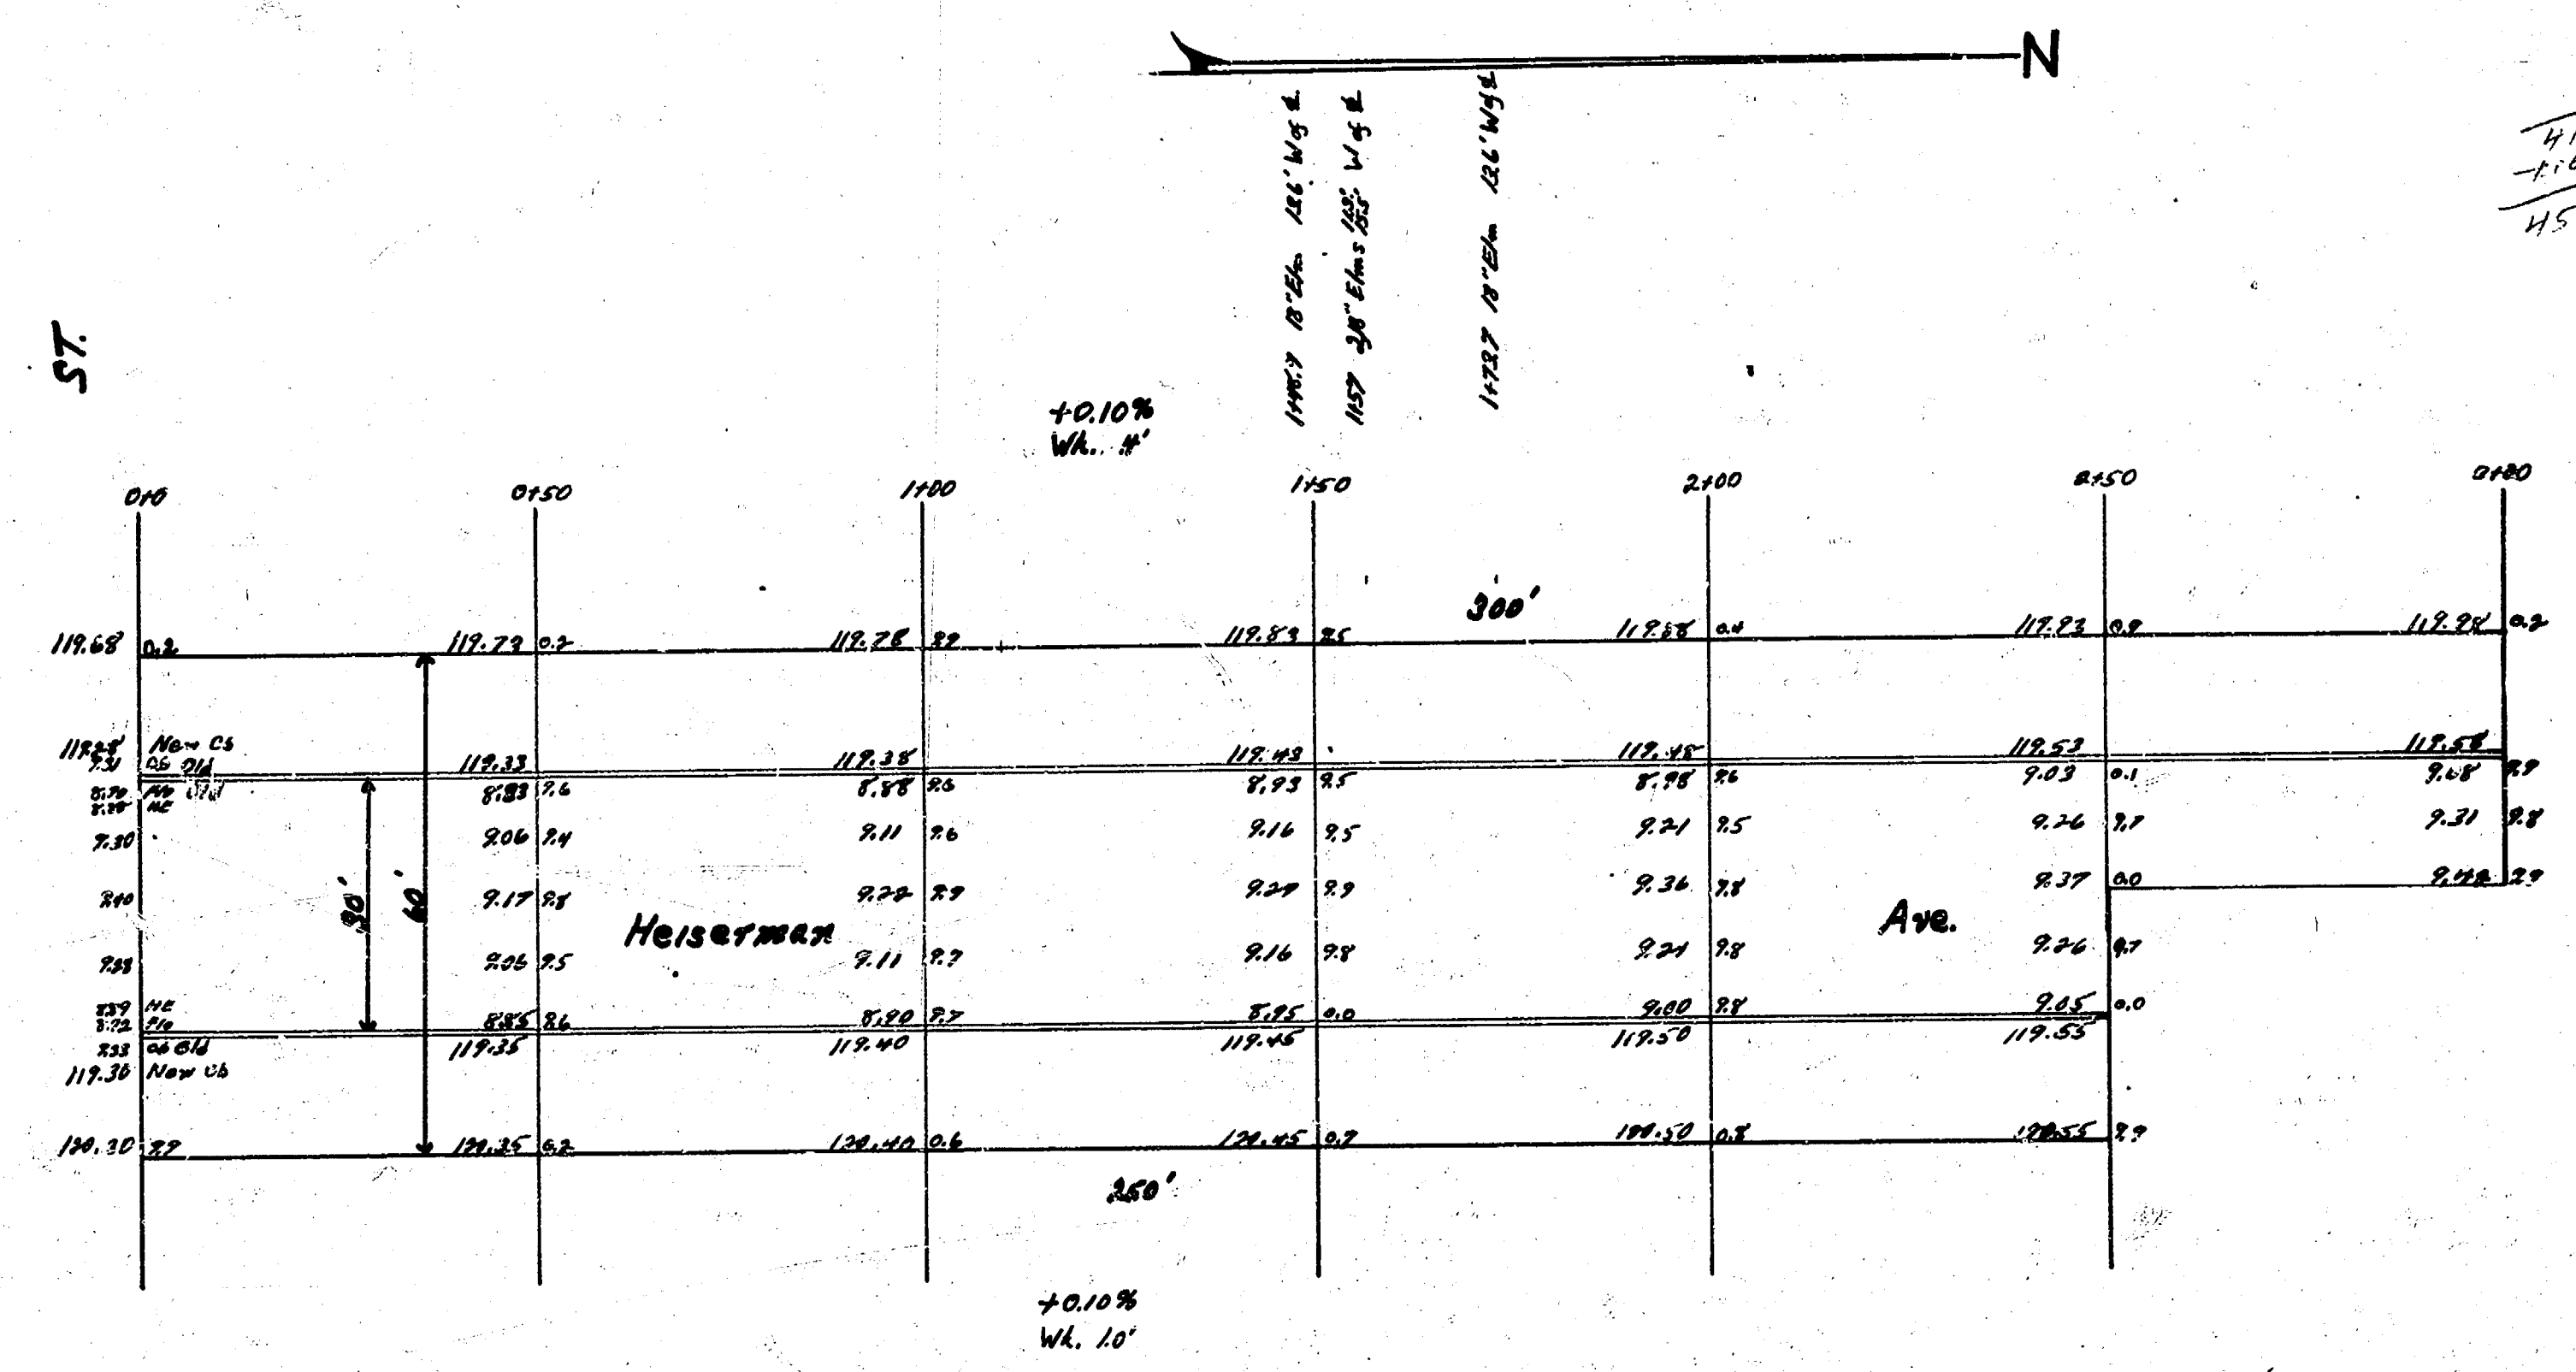

Heiserman Ave.
 N.E. 18" — S.L. Ferrell Dr.
 90' Conc. ~ Cb.
 City of Wichita, Kansas
 L.K. White City Engineer
 May 1948 Project C18-50

4 13 4 15