

B.M. 98.32 "G" IN GLOBE S. END CO. N.E. COR. MINNEAPOLIS & HODSON
CHANNING E. ON & HODSON

0+55 8" CONC. PIPE 37' LT.
0+60 8" CONC. PIPE 36' LT.

0+77 7" CONC. PIPE 38' LT.

1+26 8" CONC. PIPE 38' LT.
1+29 8" CONC. PIPE 38' LT.



1+45 8" CONC. PIPE 37' LT.
1+48 8" CONC. PIPE 38' LT.

1+53 8" CONC. PIPE 38' LT.

2+02 8" CONC. PIPE 38' LT.

E.I.C.
Prop. 239.4 18.6
+10.7 21.6
250.1 24.10

Survey B.M.
Plan
Exc. D.L.
Checked 37

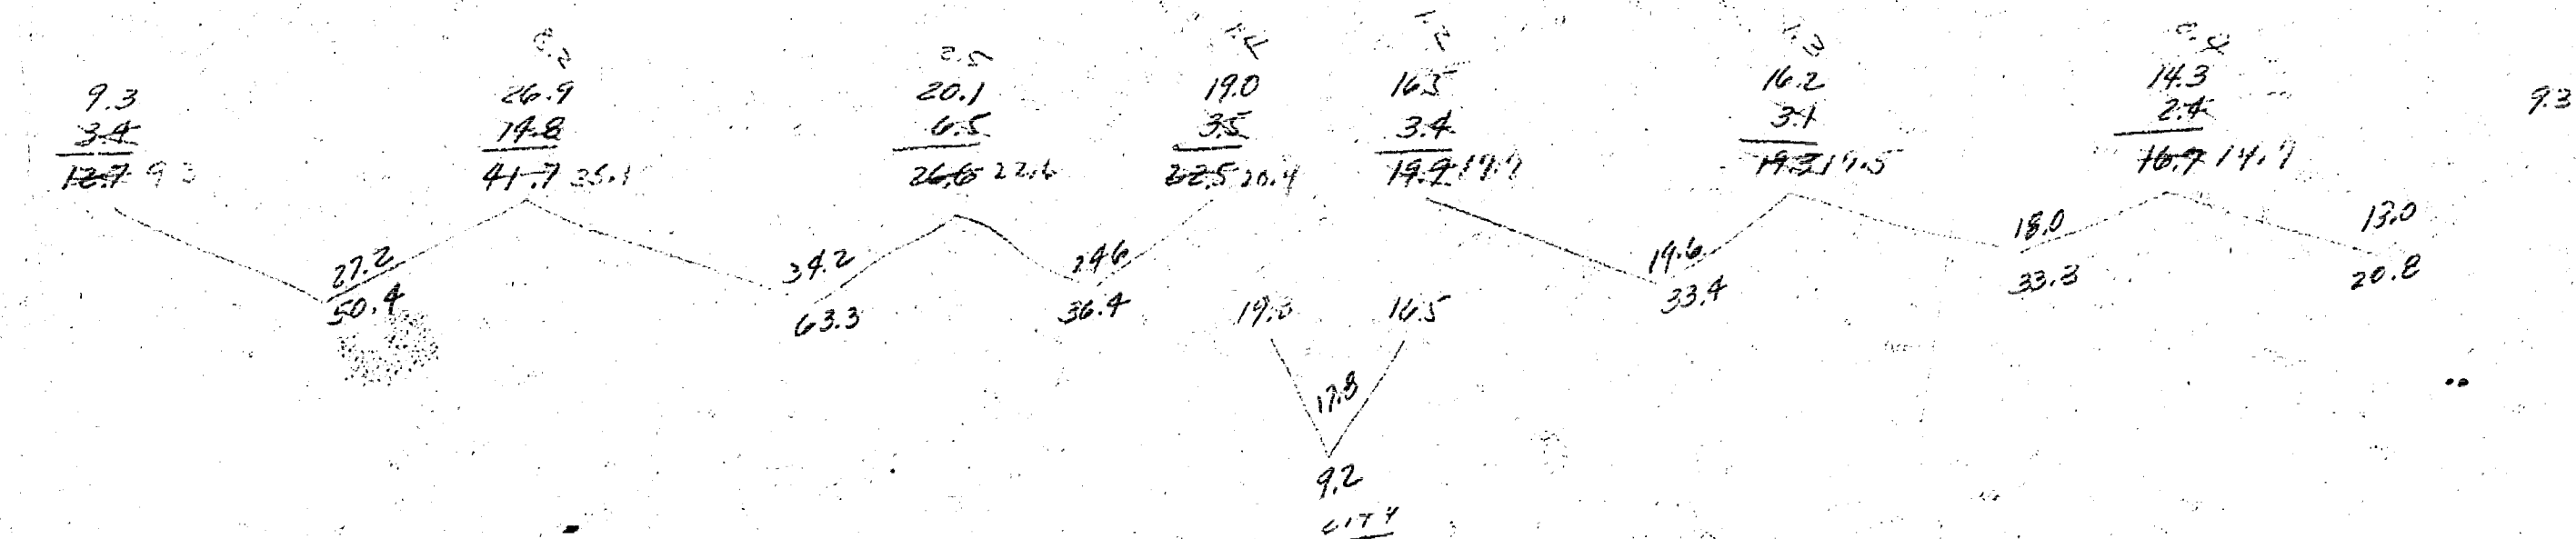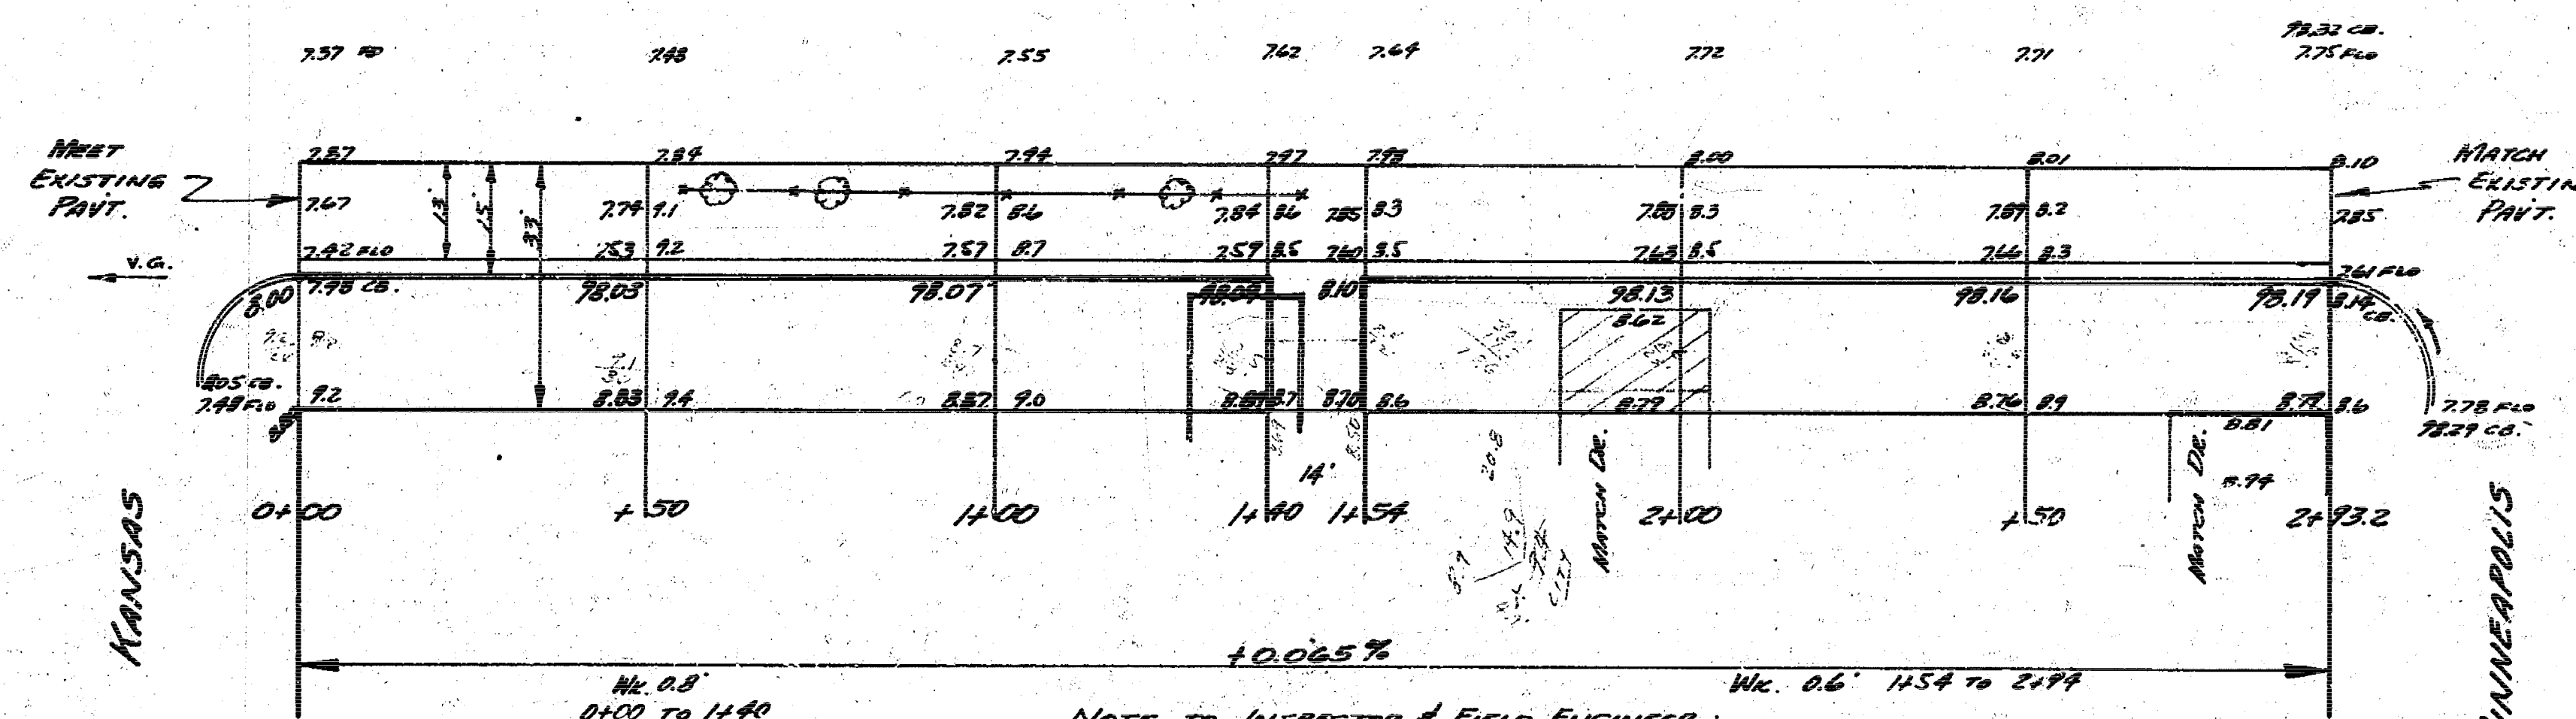

S 1/2 HODSON
E.L. KANSAS TO W.L. MINNEAPOLIS
13-2-15 A.C.
CITY OF WICHITA, KANSAS
B.E. SMITH - CITY ENGINEER
AUGUST, 1933 PROJ. C13-113

1 2 3 4 5 6 7 8 9 10