Hood St
N.L 14th - S.L 17th
26-2-30 4" Black Base
1"- Sheet Top

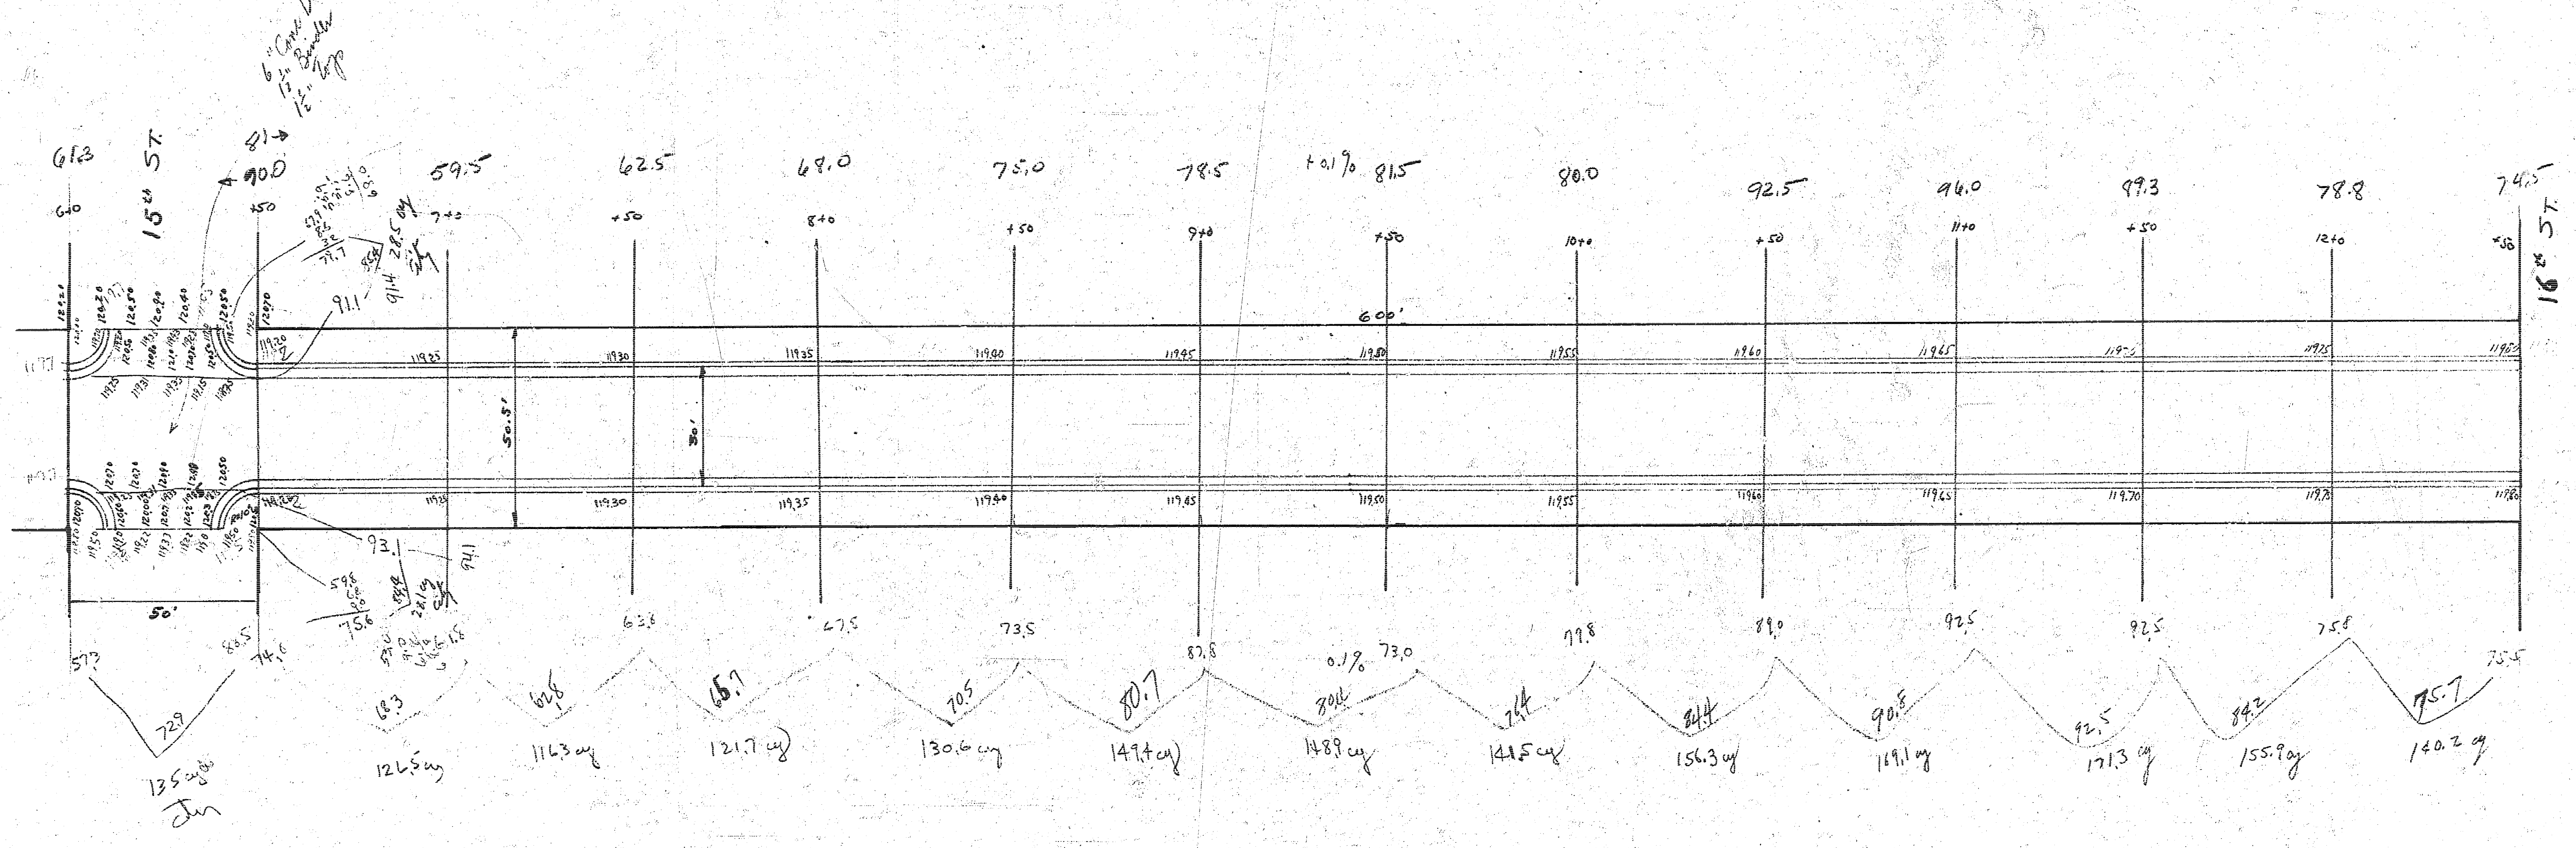

1727.7
191.6

HOOD ST.
N.L. 14th - S.L. 17th
26-2-30 4" Black Base
1" Sheet Top.

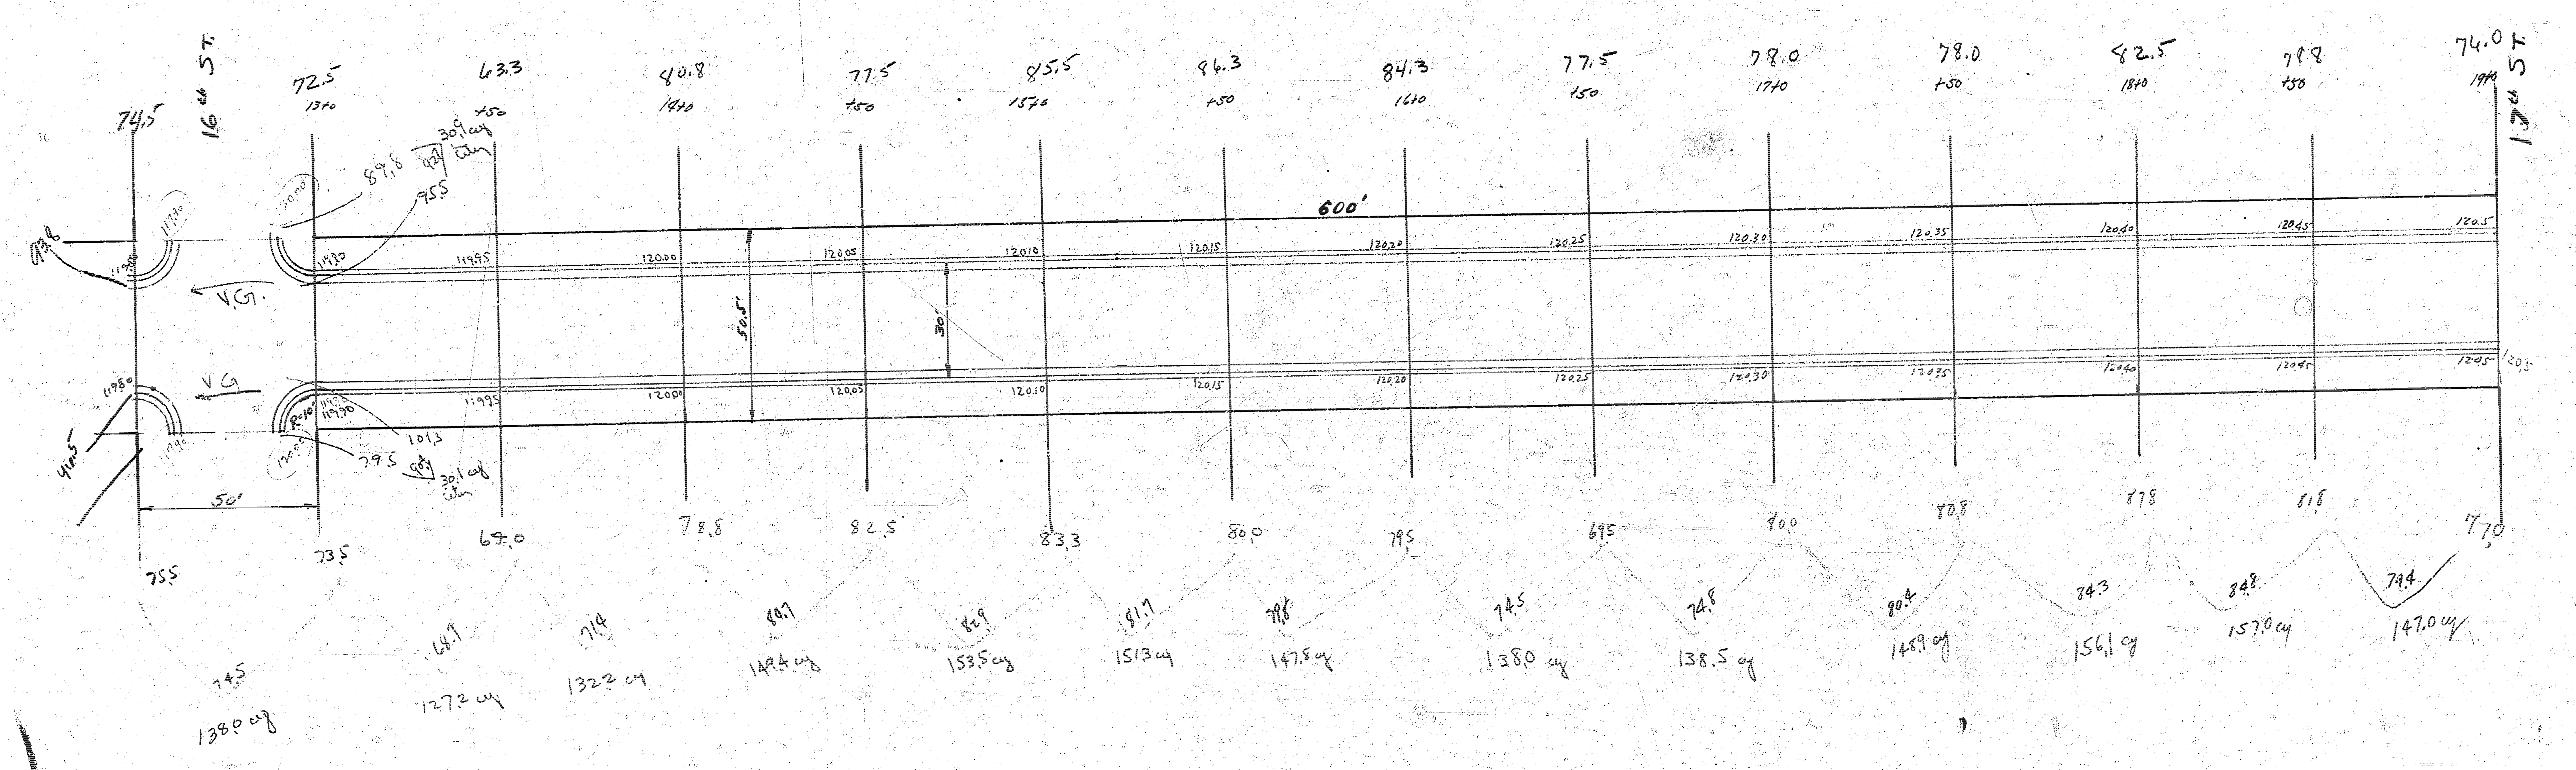

Imp. 1746.9
City 199.0

HOOD ST

N.L. 14th - S.L. 17th

26-2-30- 4" Black Base- 1" Top.

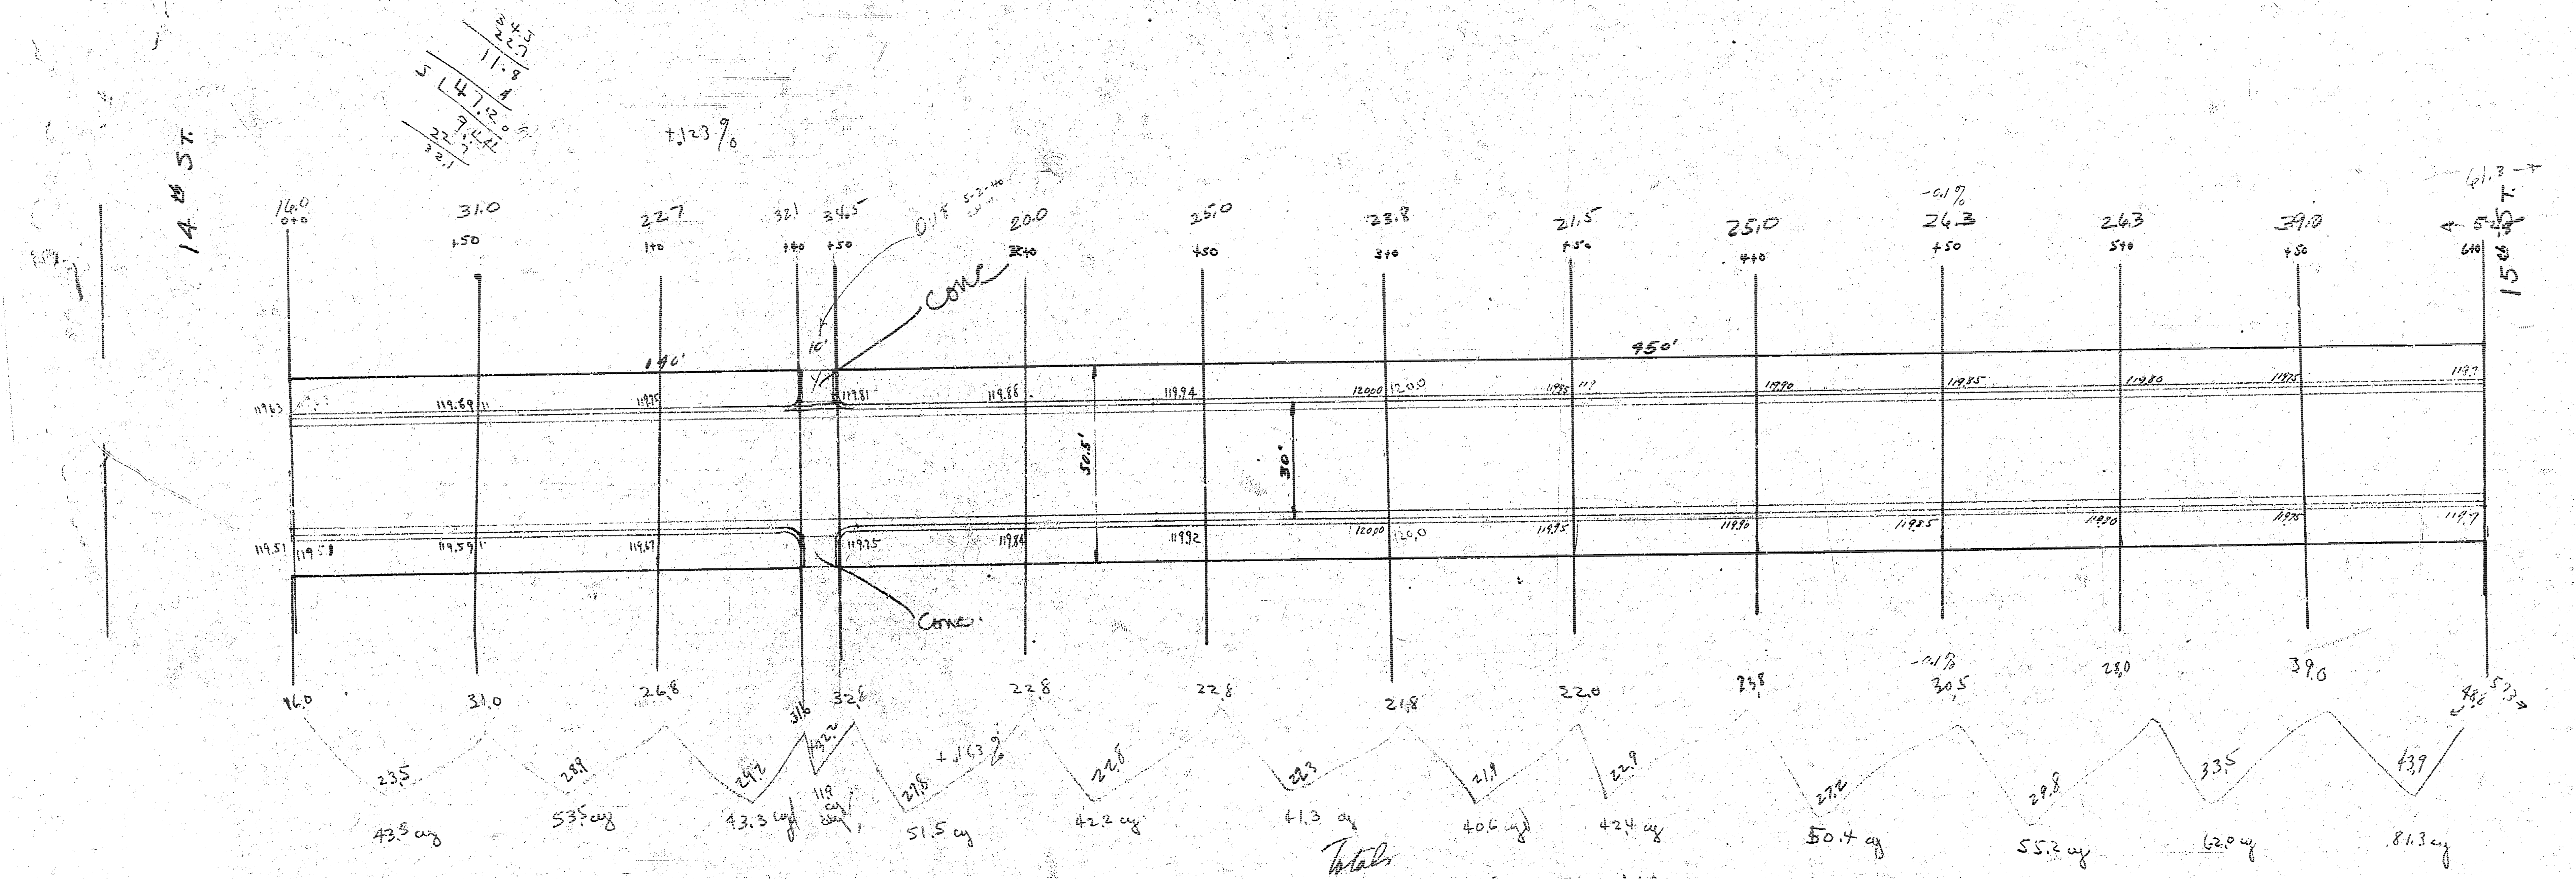

Totals

Property - 4081.8 +10 % 408.2 = 4490.0 cy
City = 402.5 + 40.3 = 442.8

49,32.8

Prog. 607.2
City 11.9