1942


CO + GTR

Track is not previously removed
Take out this and construct curb and
gutter contemporaneously under said
P.W.A.

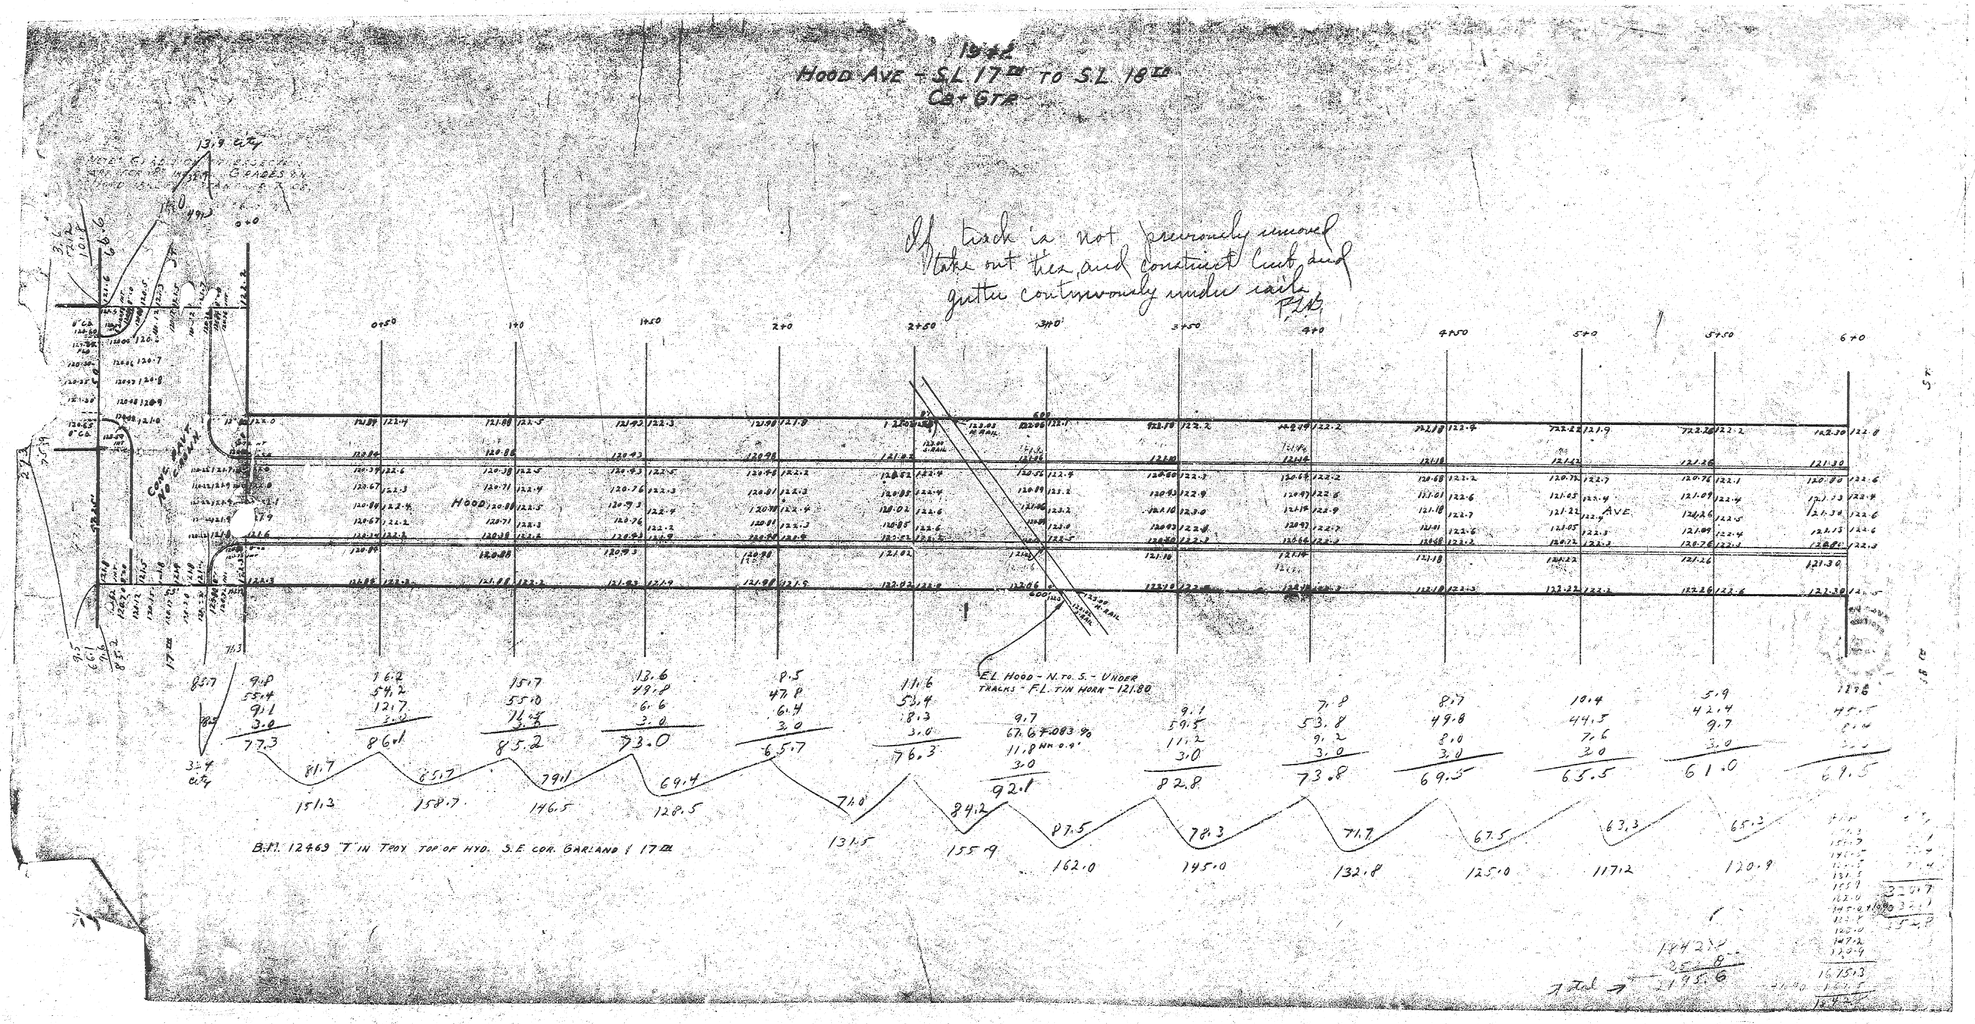

B.M. 124.43 S.E. CORNER CONC. PORCH S.W. 18TH & Hood

Note to estimator:
All Cy. gtr. & Driveways that are replaced due to change in grade will be charged to city at large. Mass construction to be paid by property concerned

Note: Remove & Replace all Existing Curb & Gutter in this Block

0+00 0+50 1+00 1+50 1+90 2+10 2+50 +0.12% 3+00 3+50 4+00 4+50 5+00 5+50 6+00.3

ST

18TH

HOOD

AVE.

17TH

ST

+9.83%

13.0 16.9 16.4 12.6 13.7 15.3 16.2 13.1 14.6 14.7 15.5 13.7 9.3 21.1

1.50 16.7 14.5 13.2 14.5 15.8 14.7 13.9 19.7 15.1 14.6 11.5 15.2

750 835 725 528 145 790 735 695 735 755 730 575 760

27.8 30.9 26.9 19.6 2.7 Cut 2.7 Fill 29.3 27.2 25.7 27.2 28.0 27.0 21.3 28.1

Fill 2.5' @ 1/2 mile

Fill
27.8
30.9
26.9
19.6
2.7
29.3
27.2
25.7
27.2
28.0
27.0
21.3
28.1
321.7
+10%
353.9 cu yds.

Cut
2.7
+10%
3.0 cu yds

HOOD AVE
N.L. 17TH TO S.L. 18TH
26' CONC. ASPH.
CITY of WICHITA, KANS.
L.K. WHITE CITY ENGINEER
JUNE 1947