




[illegible]

SCALES :  
 PLAN : 1" = 20'  
 PROFILE :  
 HORIZ. : 1" = 20'  
 VERT. : 1" = 5'

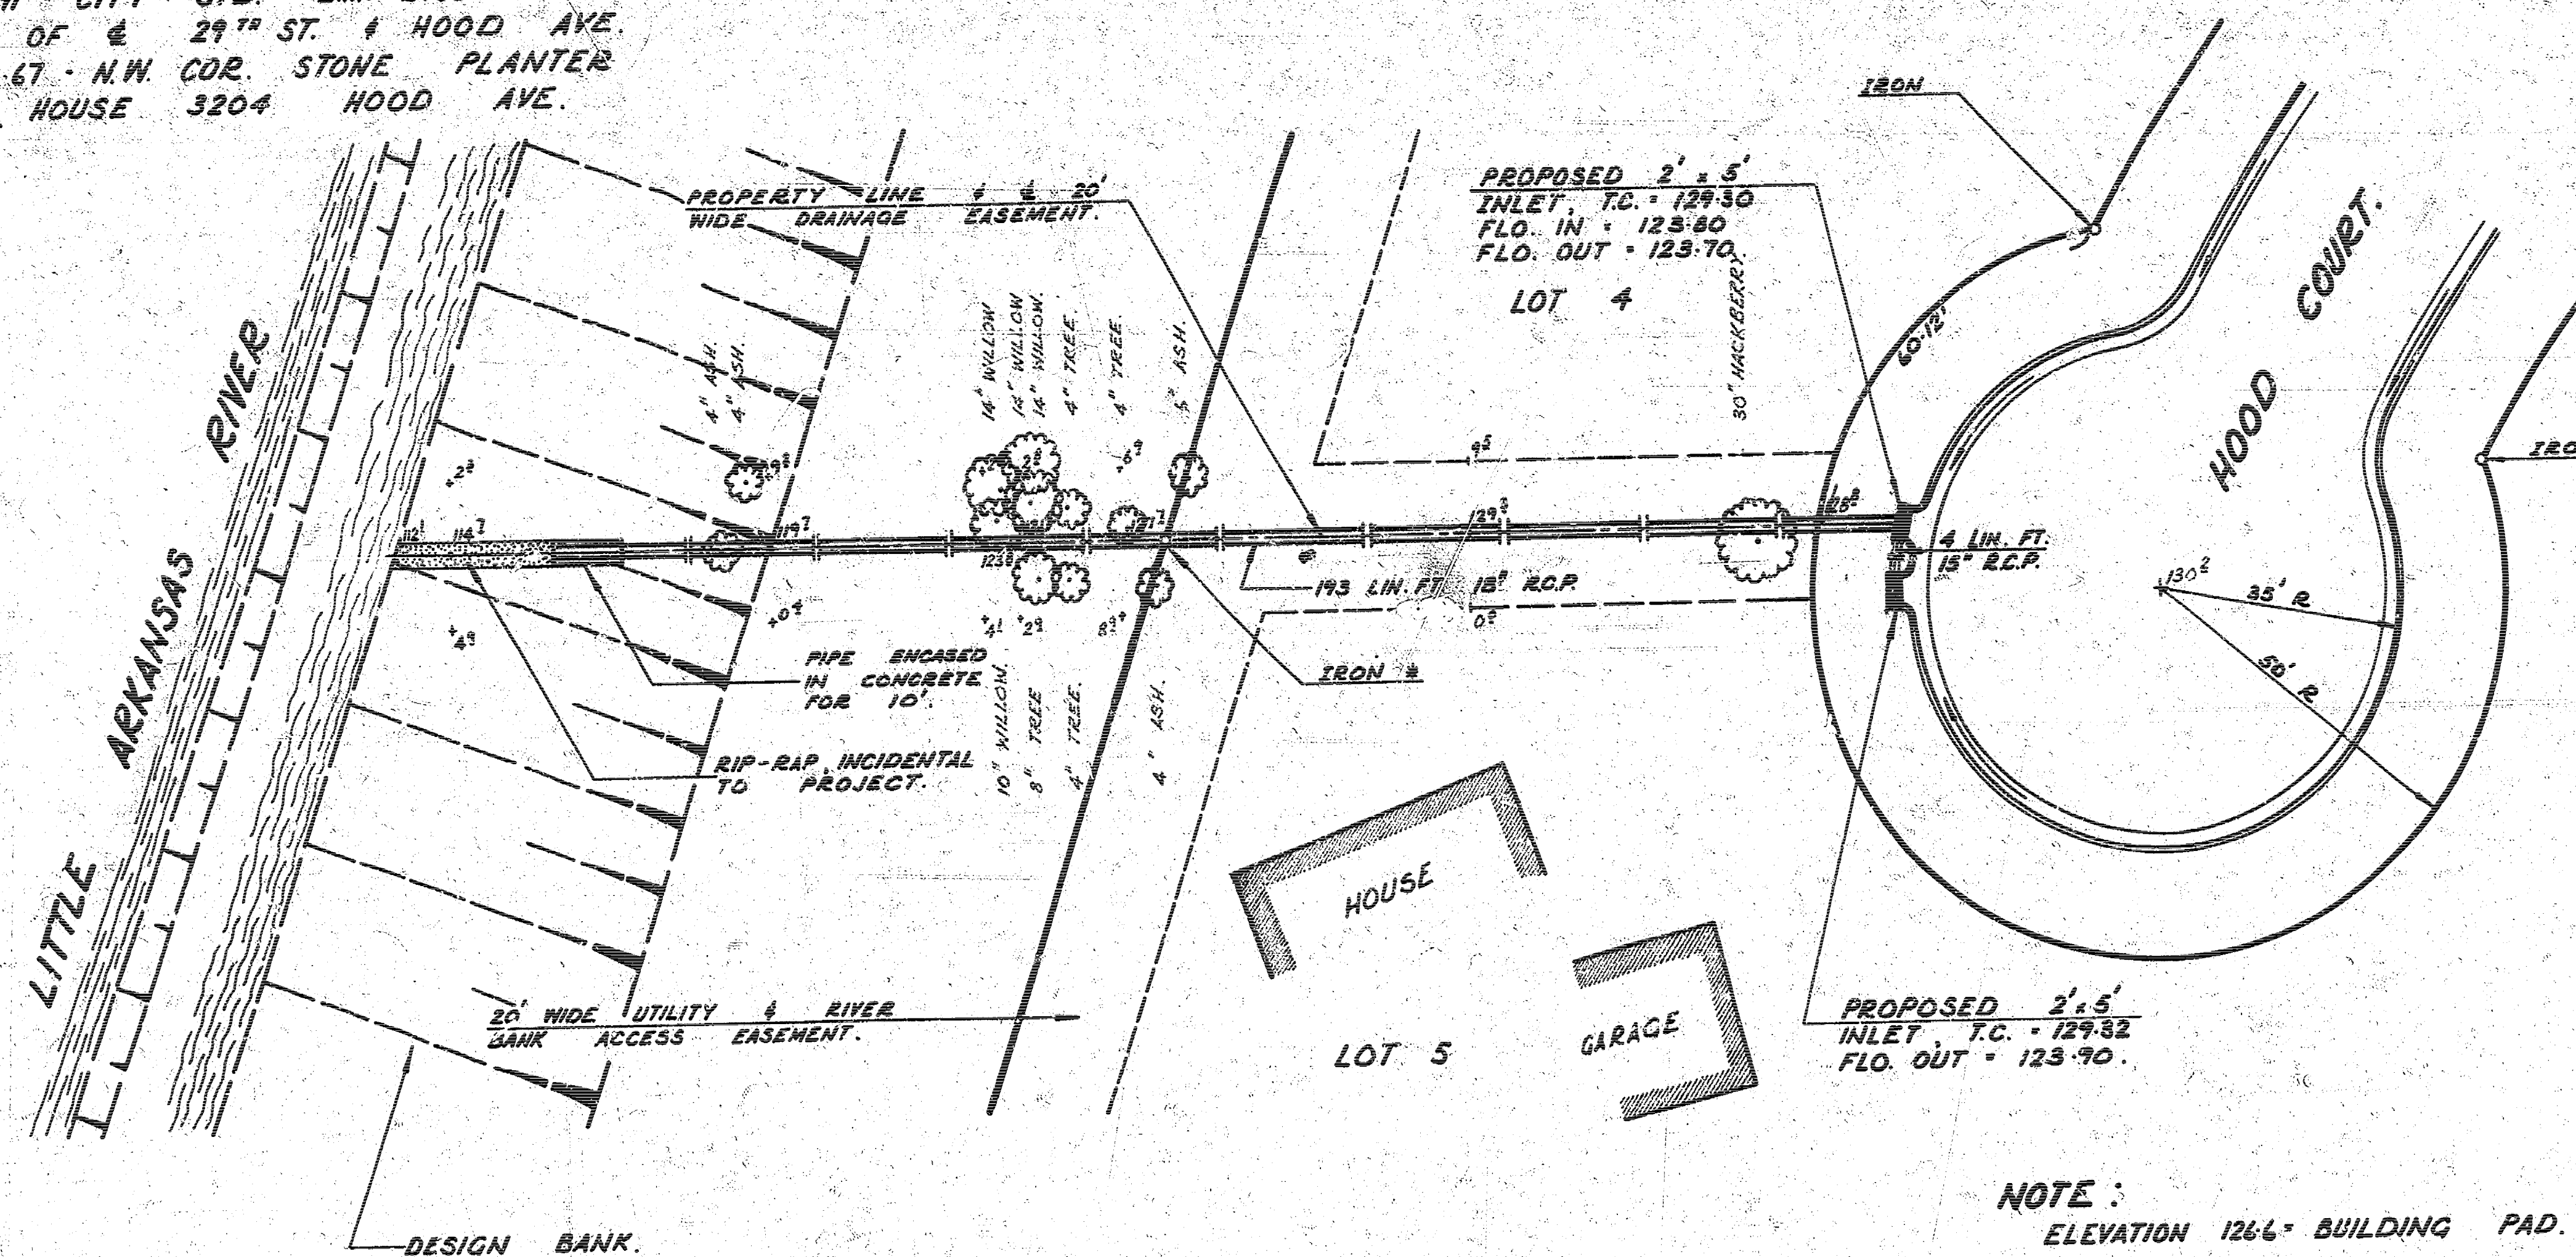

**NOTE :**  
ELEVATION 126-6 - BUILDING PAD.

≡ TIE IN IRON & REPLACE

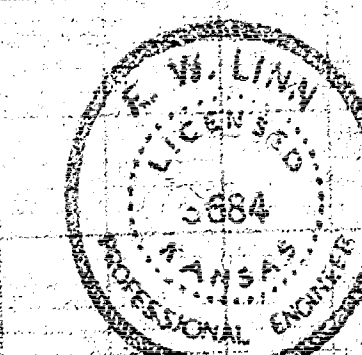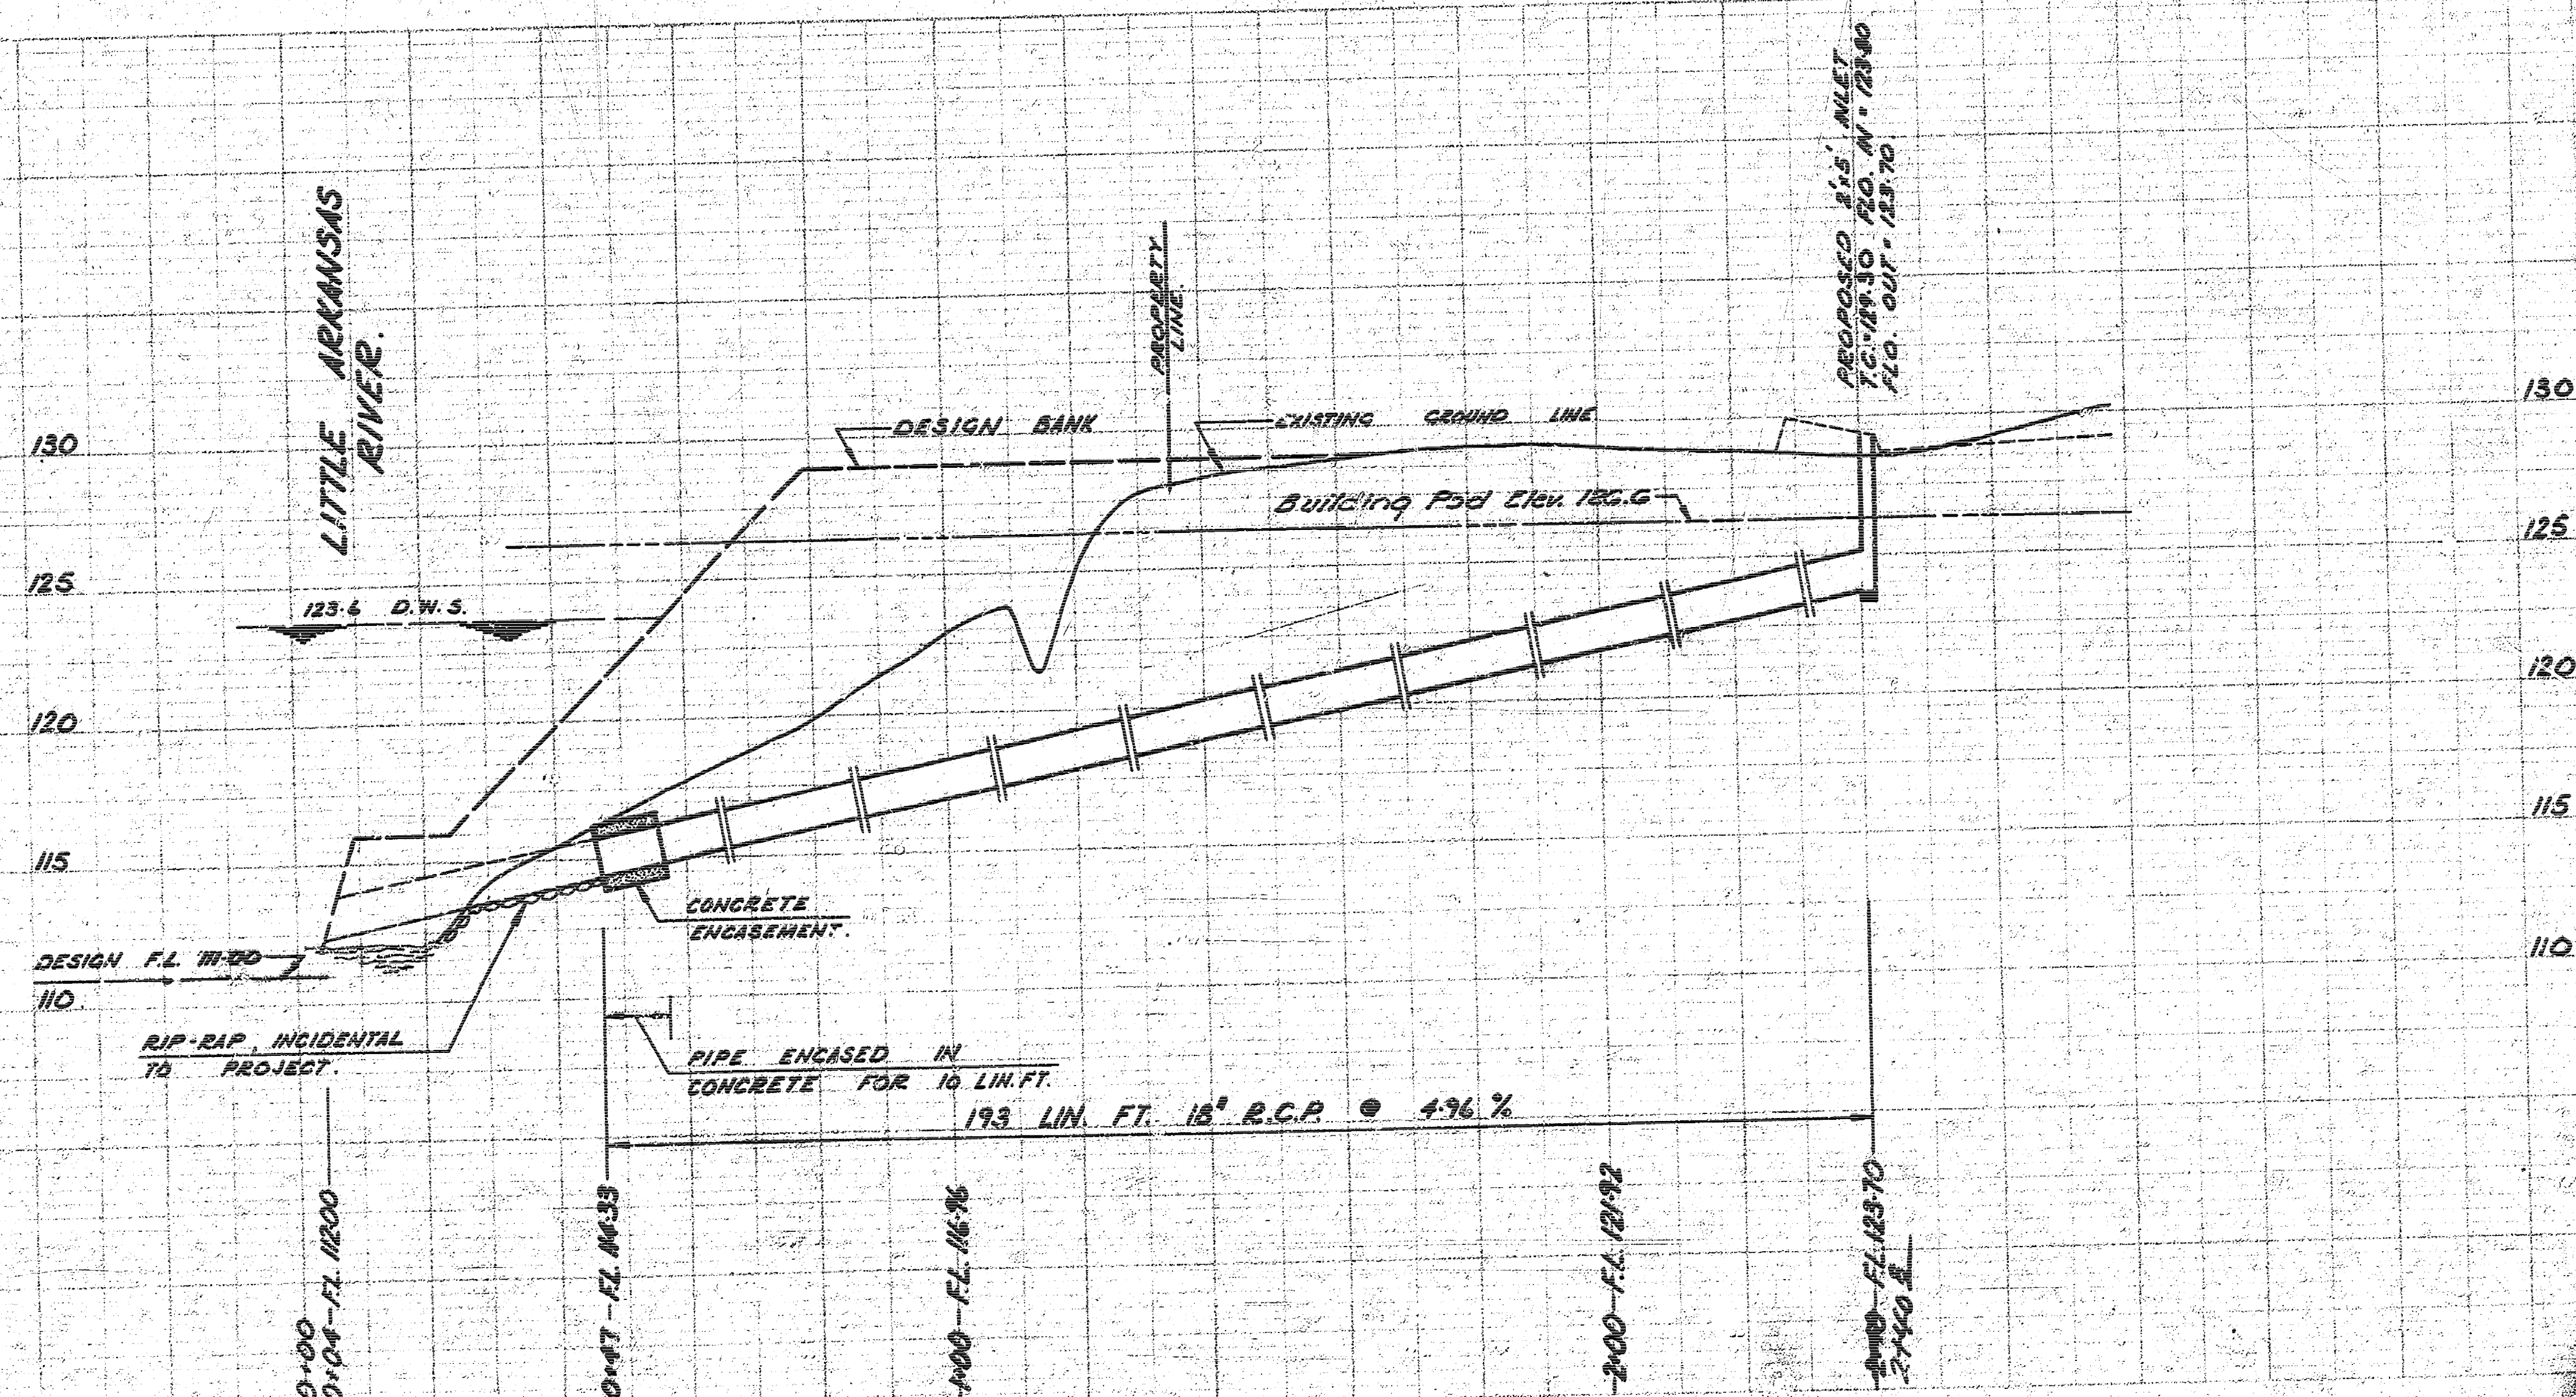

A3 Built 10-8-75

"DRAINAGE" IN CONNECTION  
WITH PAVING OF HOOD CT.  
CITY OF WICHITA, KANSAS.  
R.W. LINN. - CITY ENGINEER.  
DATE: PROJ. NO. DARD 574081.

14 2 3 12