
Book K-7 pgs. 67-73

B.M. 167.66 S.E. Cor. P.L. iron Orme & Hunter

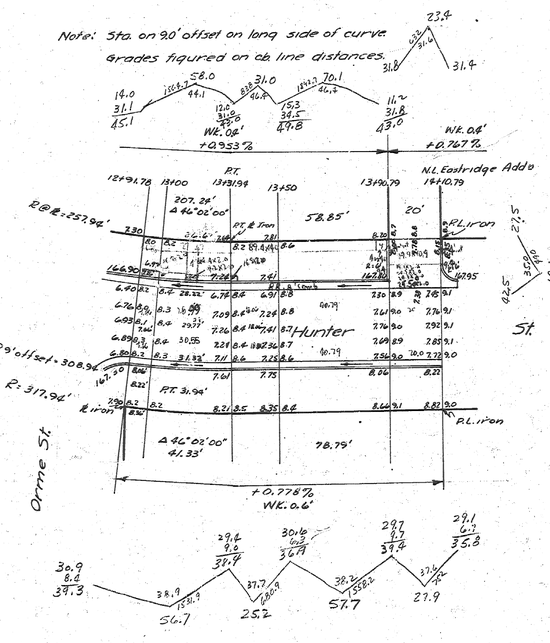

E½ HUNTER ST.
13-2-15 A.C.
Proj. No. C10-82

W½ HUNTER ST.
N.L. ORME ST. to N.L. Eastridge Add'n
13-2-15 A.C.
CITY OF WICHITA, KANS.
L.K. WHITE CITY ENGINEER
FEB. 1950 PRIVATE JOB

4 3 2 58x