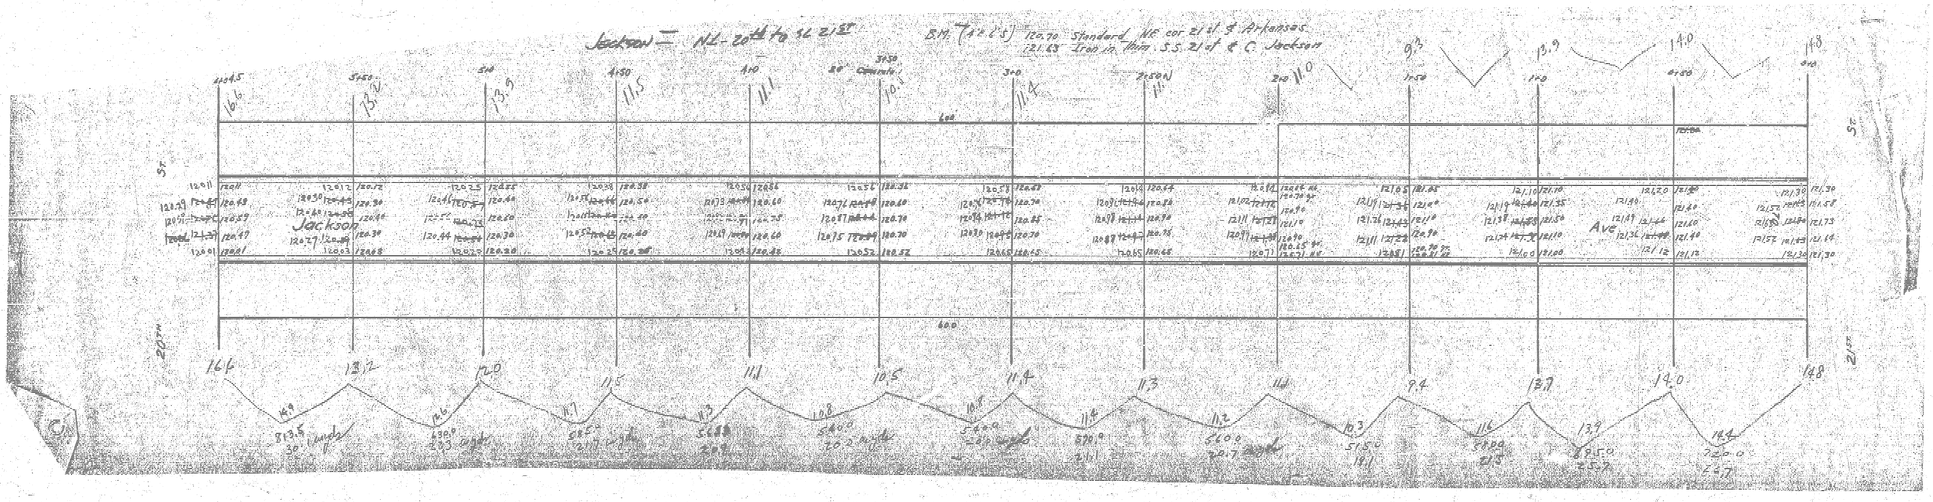
Jackson — NL - 20th to SL 21st
B.M. (1 of 5) 120.70 Standard NE cor 21 st. & Arkansas
121.63 Iron in thim. S.S. 21 st & C. Jackson
Jackson
Ave
600
20th