

B.M. 1087.0 "G" in Globe N. Curb Indianapolis 33' E. of ℄ Mosley
B.M. 1067.0 Iron in Thimble ℄ Indianapolis E.L. Washington


Chaining East on ℄

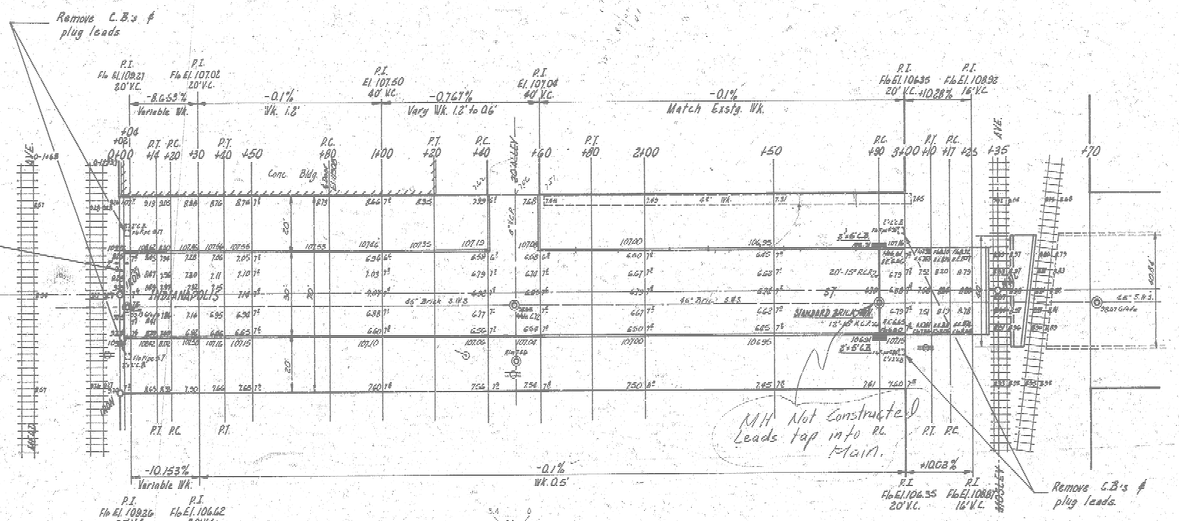

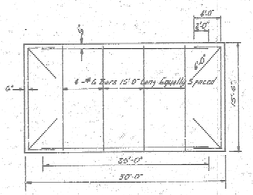


STEEL PATTERN
NOT TO SCALE

NOTE:
Frame top 18" of face of header.

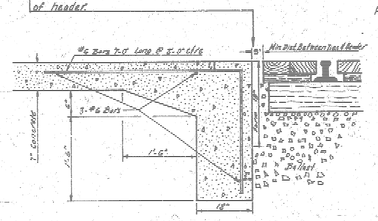

DETAIL OF CONCRETE HEADER FOR R.R. CROSSING
NOT TO SCALE

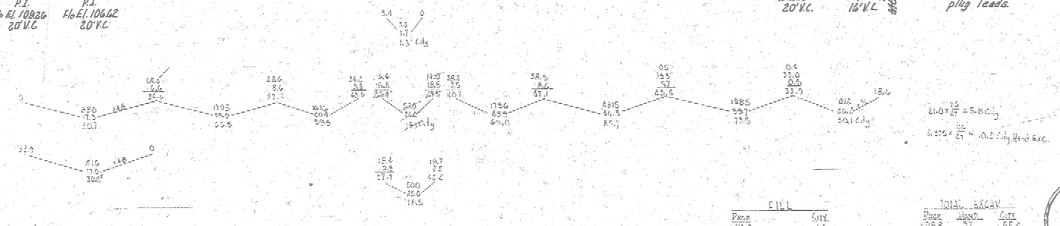

FILL		CUT	
Prism	10.2		1.5
+10%	3.0	+10%	0.1
	33.2 Cu.Yds.		1.6 Cu.Yds.

TOTAL EARTH			
Prism	Hand	Cuts	55.2
3.0	2.1		
+10%	0.0	+10%	0.5
3.3 Cells	0.2 Cu.Yds.		60.7 Cu.Yds.

B. E. SMITH
LICENSED
435
KANSAS
PROFESSIONAL ENGINEER

INDIANAPOLIS AVE.
E.L. MEAD - E.L. MOSLEY
30'-7" CONC. & C.B.
CITY OF WICHITA, KANS.
B.E. SMITH — CITY ENGINEER
SEPT. 1953 — PROJ. NO. C15-175

1 - 15 ⁴ (18)