


B.M. 1018.3 = Top Curb West Return Southwest Cor. 51st & Illinois Ave.

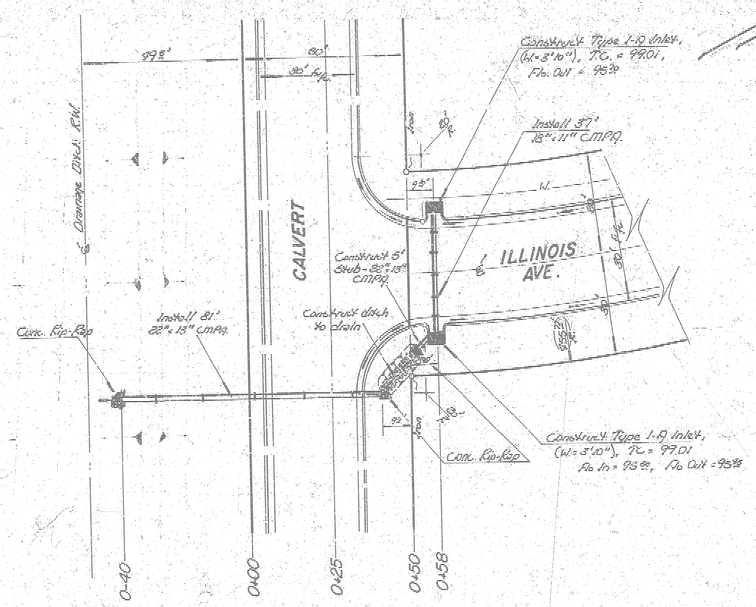

Scale:
Plan - 1"=20'
Profile - 1"=20' Hor.
1"=5' Vert.

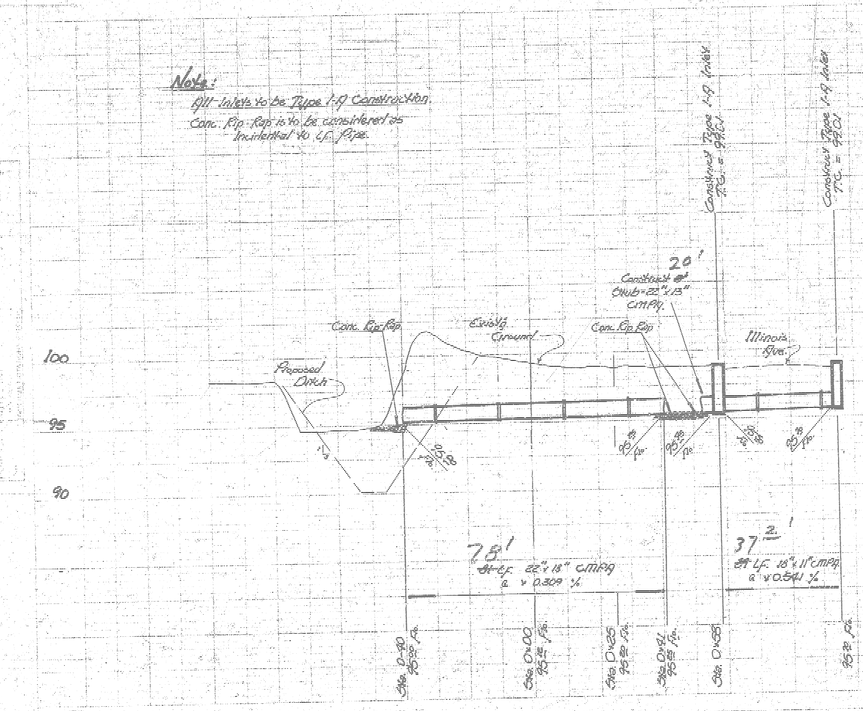

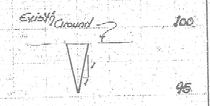

Drainage Ditch Detail
1:1 Slope
Place Conc. Rip-Rap along sides & bottom of ditch.

As built 3-31-78

INCIDENTAL DRAINAGE
In Connection w. Paving of
ILLINOIS AVE.
CITY OF WICHITA, KS.
R.W. Linn ——— City Engineer
Project No. ——— DAKS 575103
Date: ——— ———