





Scale $\frac{1}{2}'' = 1'$

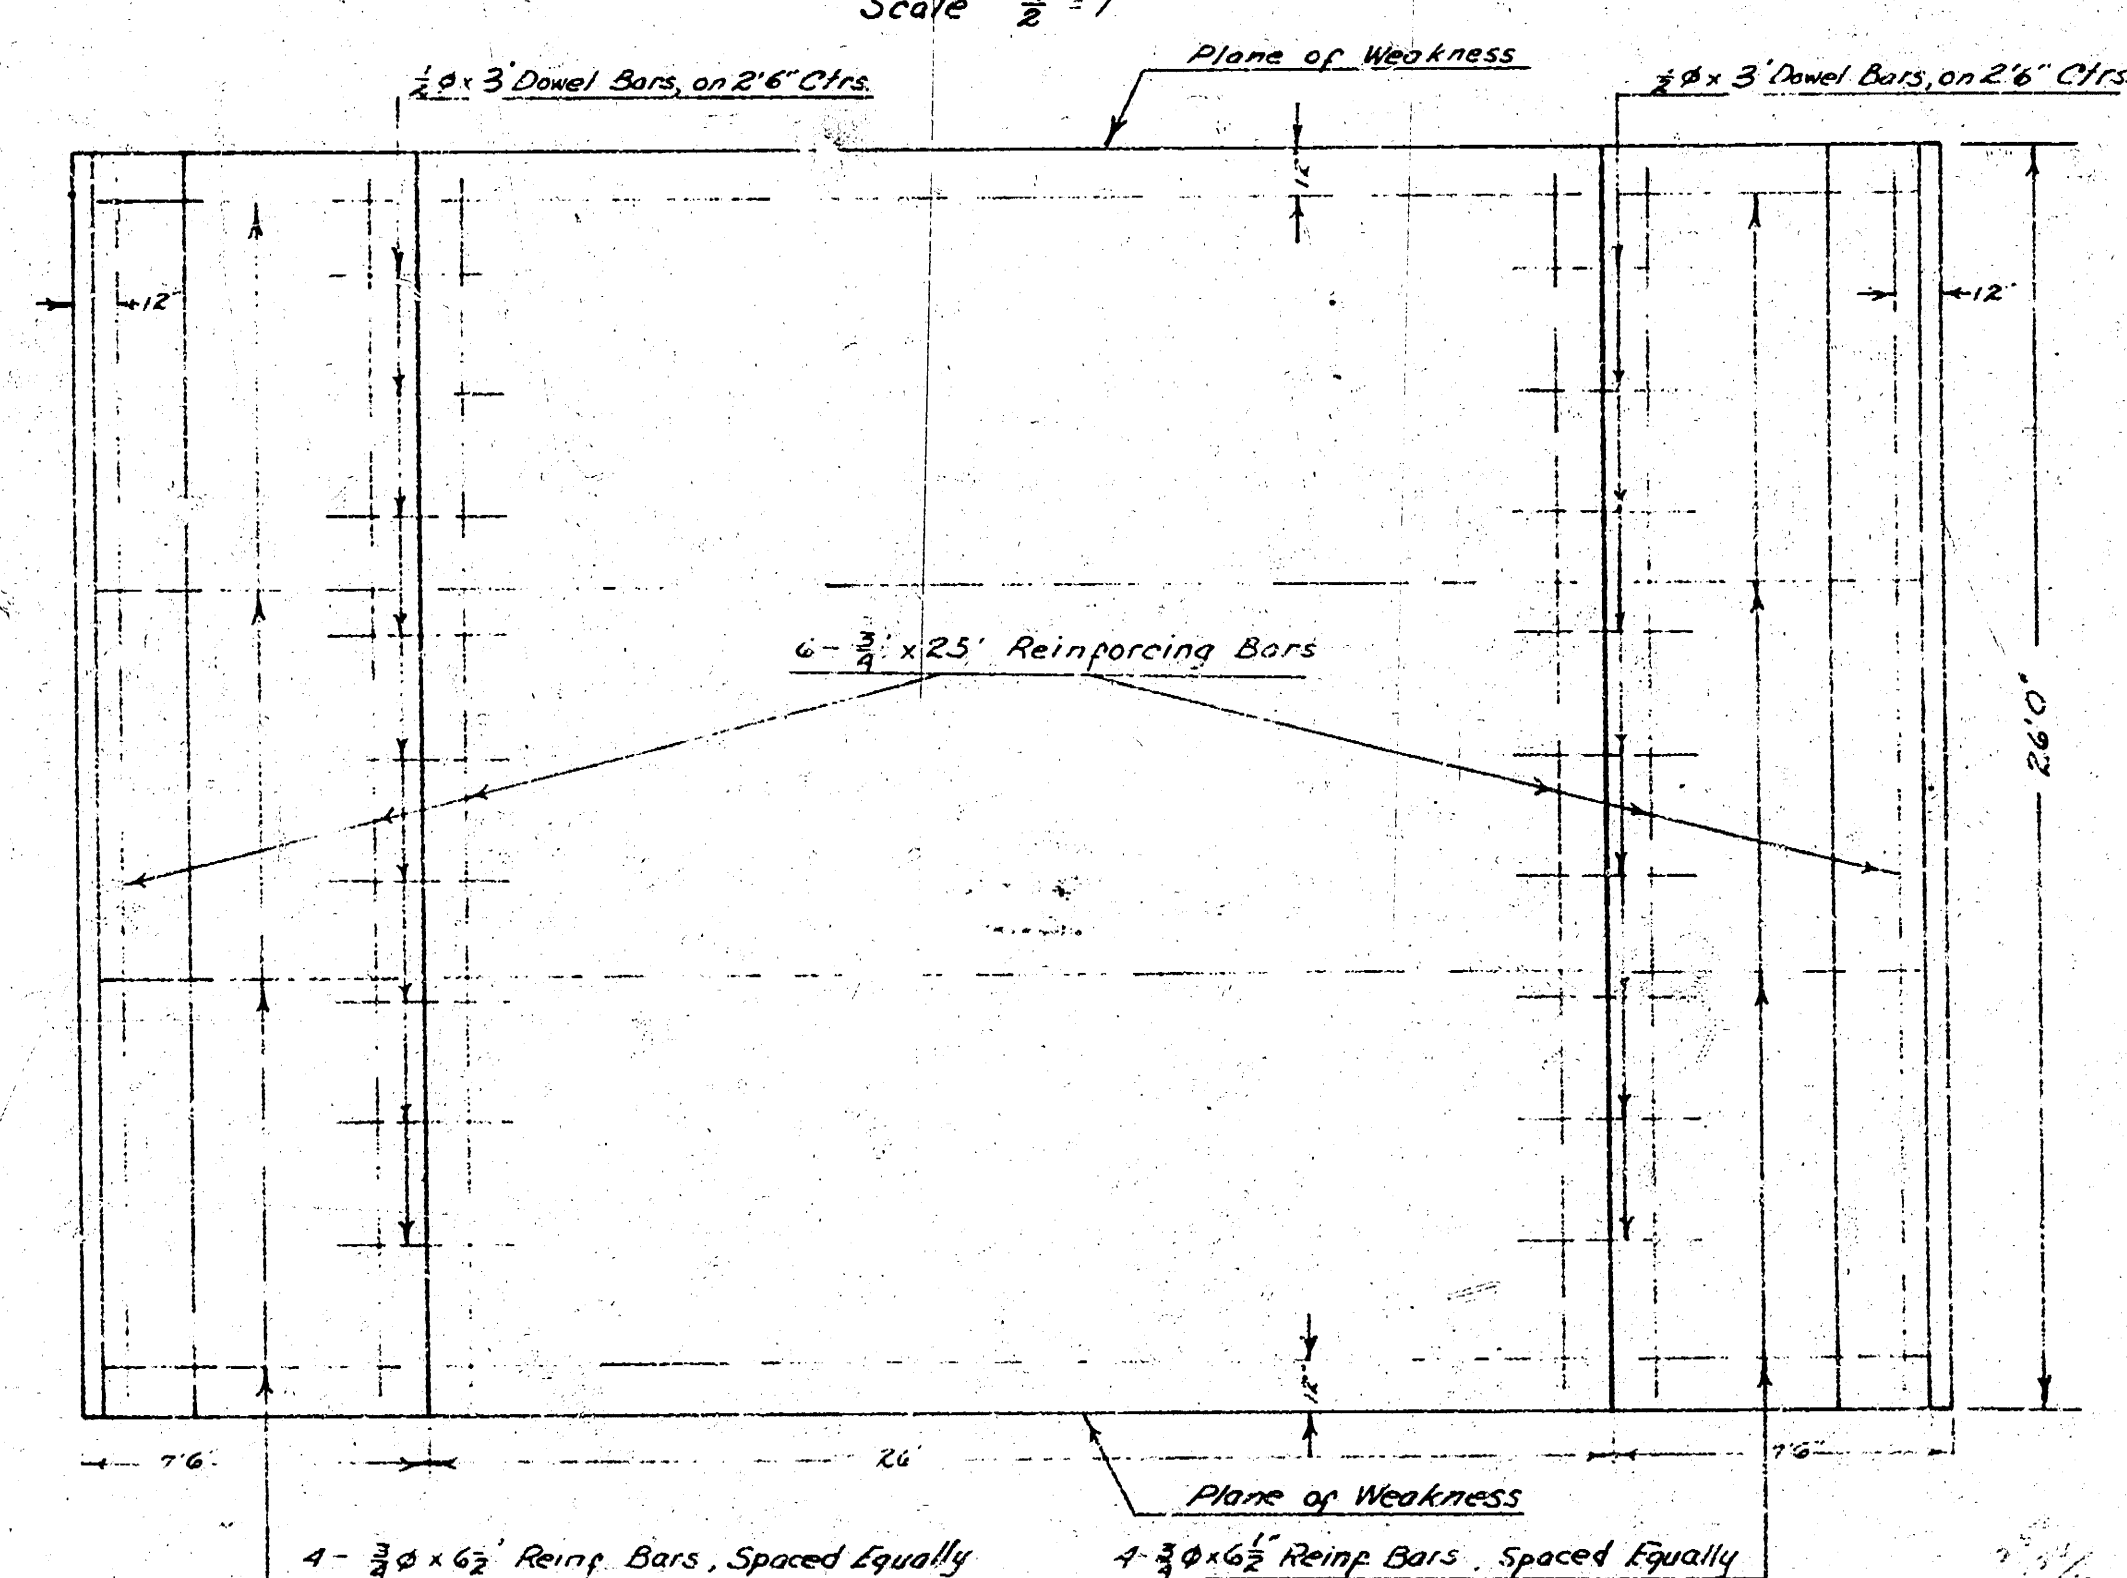

STEEL PATTERN



Scale 1"

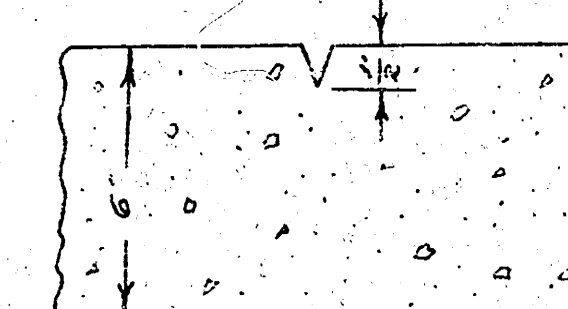

*Detail Plane of Weakness
Plane of Weakness to Be Cut With
Double-Edge Groover to Depth As
Shown in a Straight Line From
Curb to Curb 26" Ctr. to Ctr.*


B.M. 95.43- HYDRAULIC NORTHERN 60" SINK L.S. PAUL S.E. CO.
B.M. 95.43- 12" IN RITCHIE S. END C. RETAIN KANSAS @ NORTHERN.

NOTE BASE LINE IS 6 KANSAS.

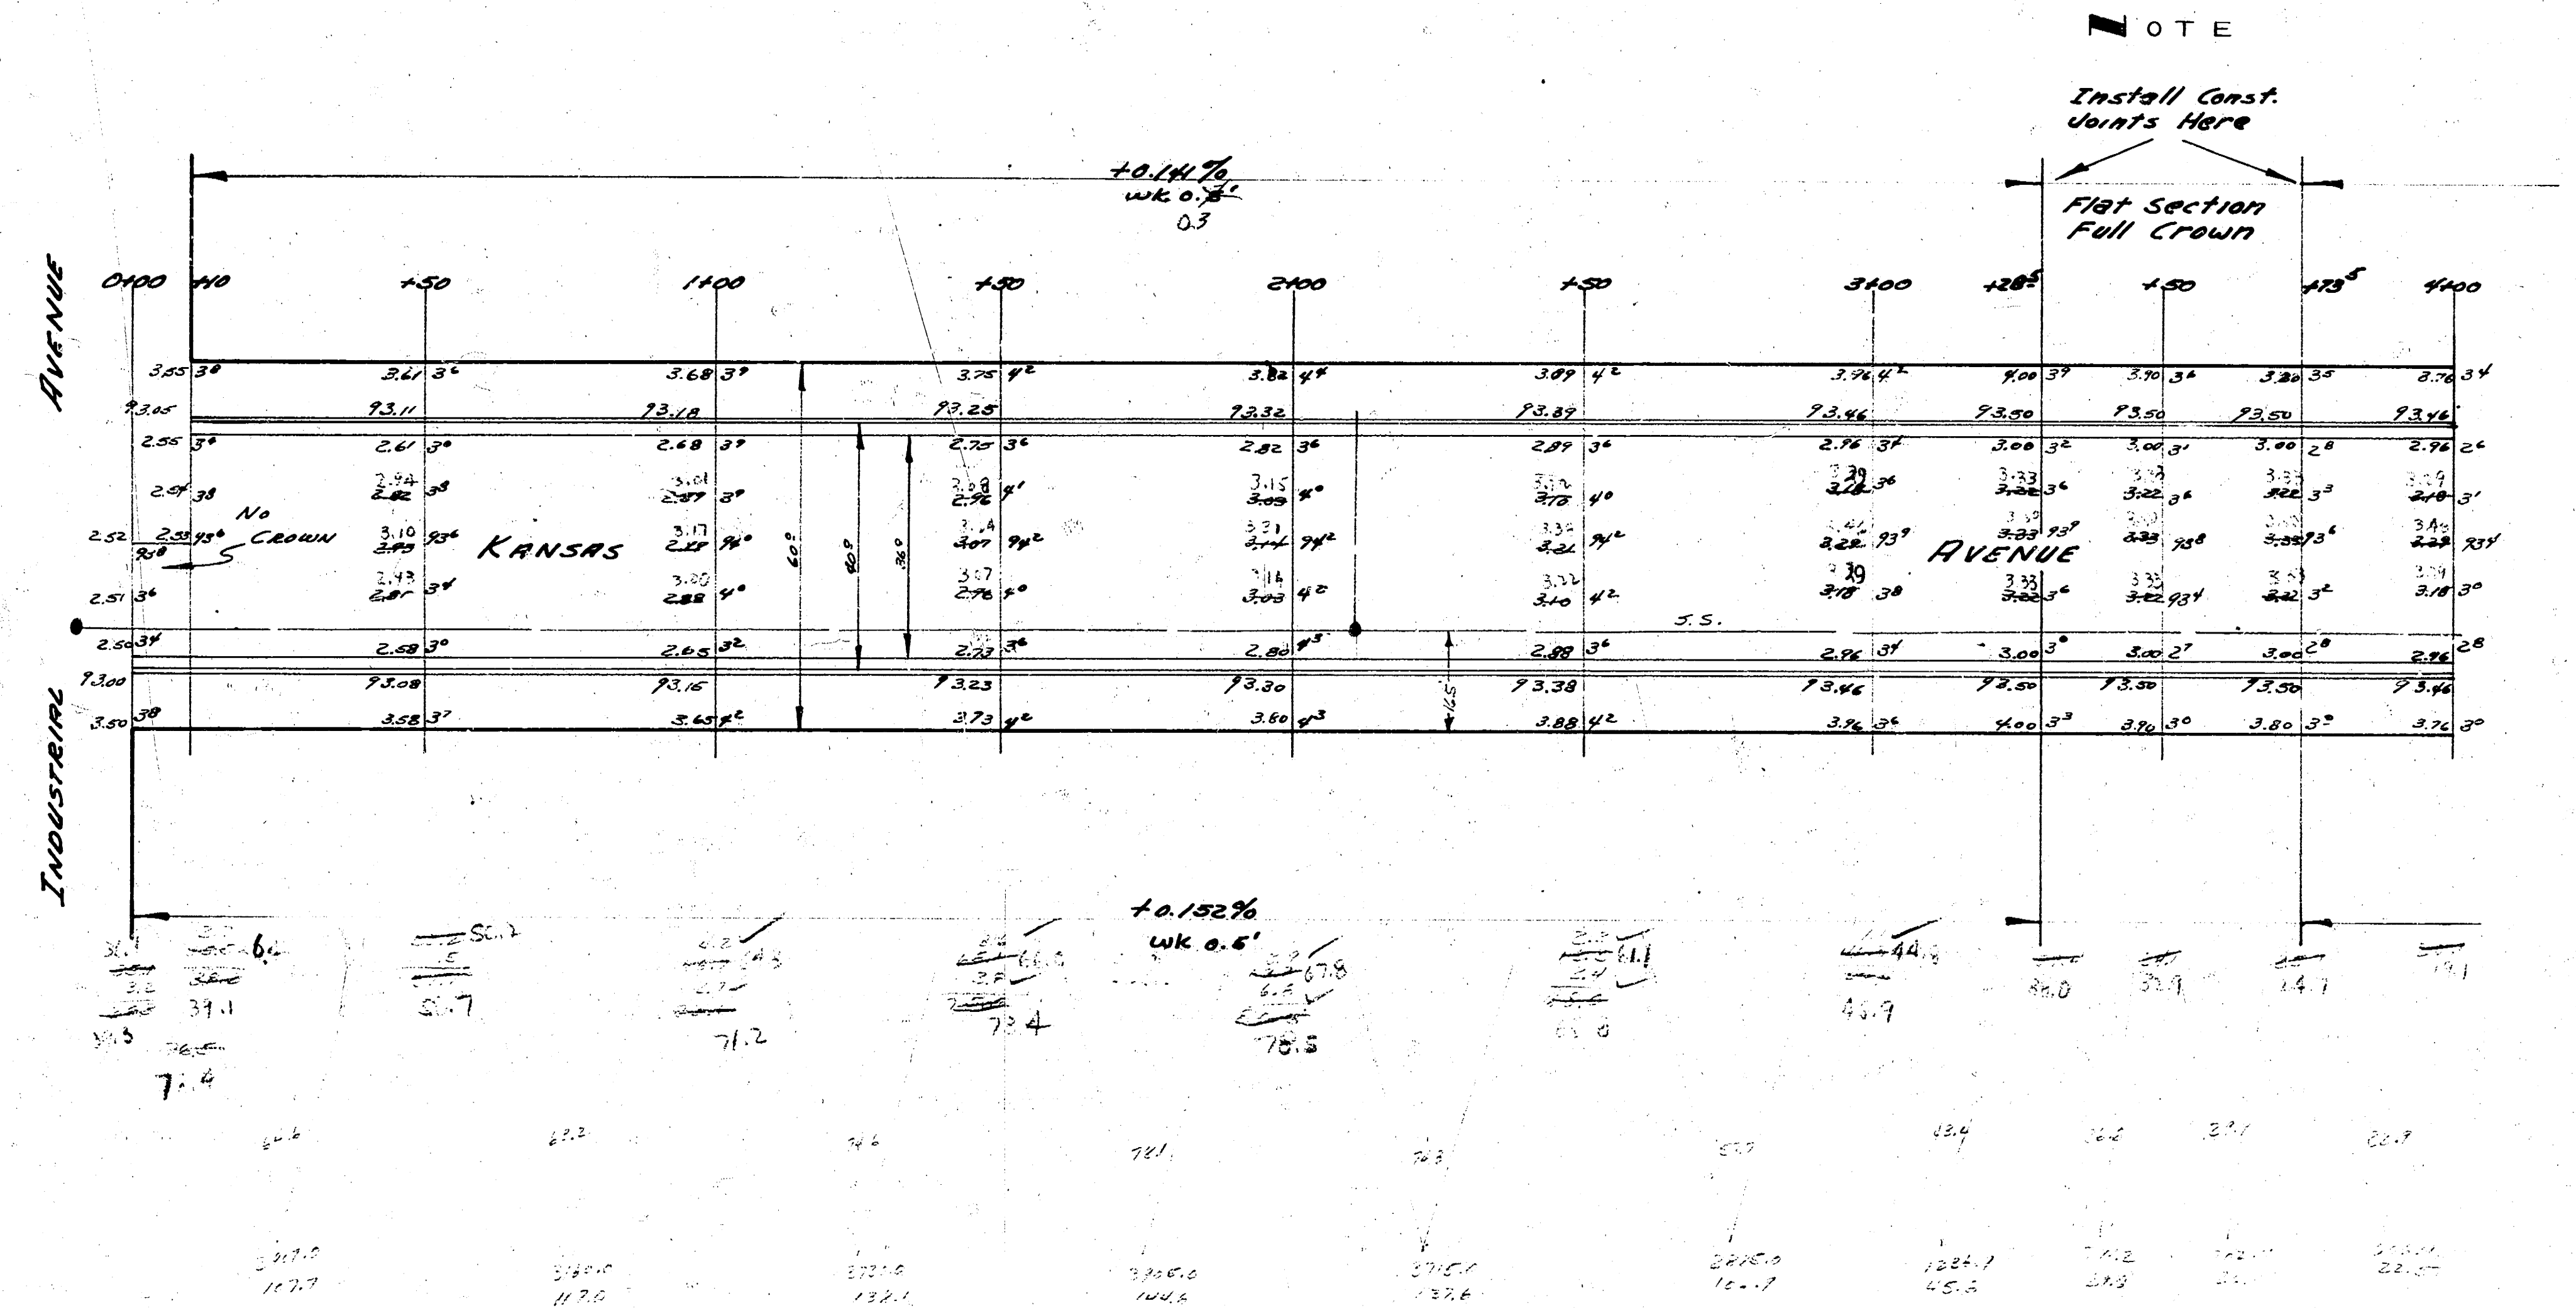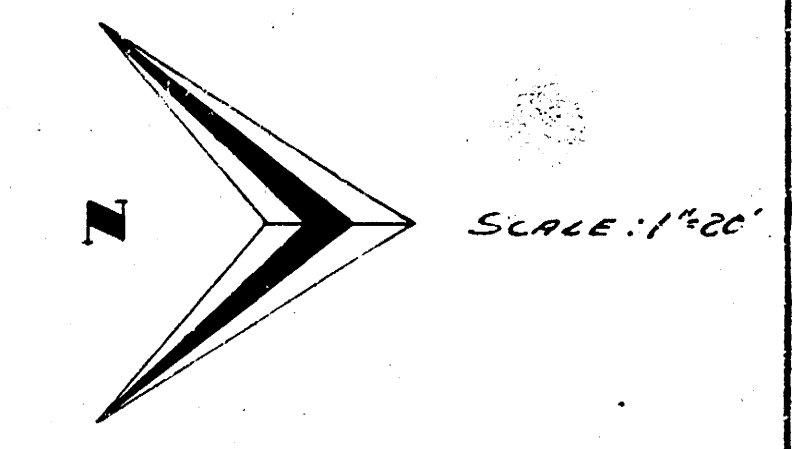



1/2

KANSAS
S.G. NORTHERN TO N.L. INDUSTRIAL
36-2-40 A.C.
CITY OF WICHITA, KANSAS
L.K. WHITE CITY ENGINEER
August 1952 Prod. No. C12-117

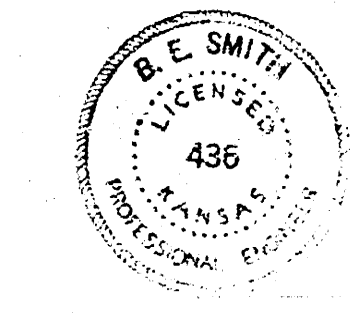

B.M. 12 1/2" R" IN RITCHIE S. END E. RETURN KANSAS / NORTHERN

NOTE: Base Line is @ KANSAS

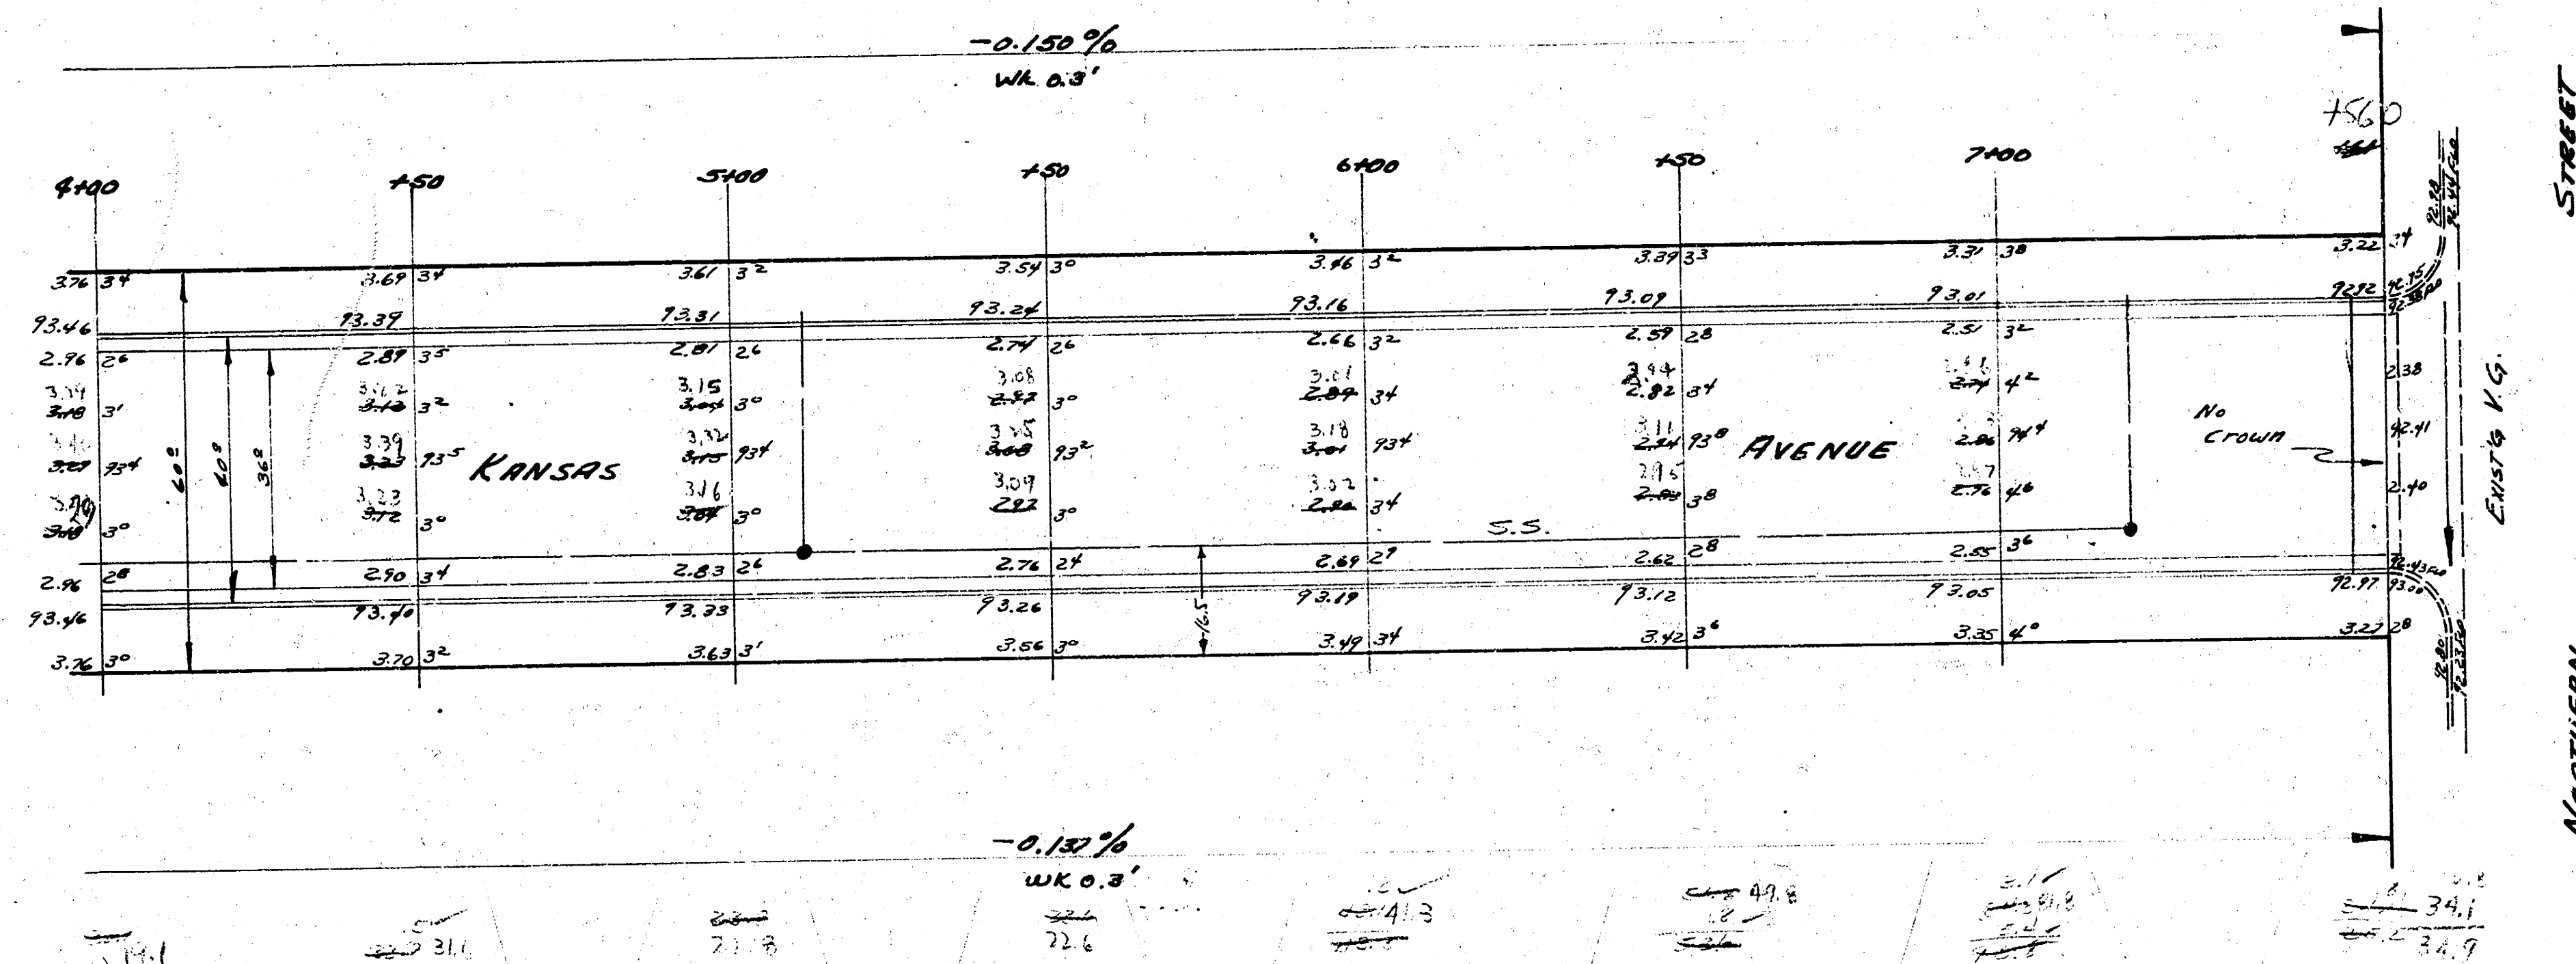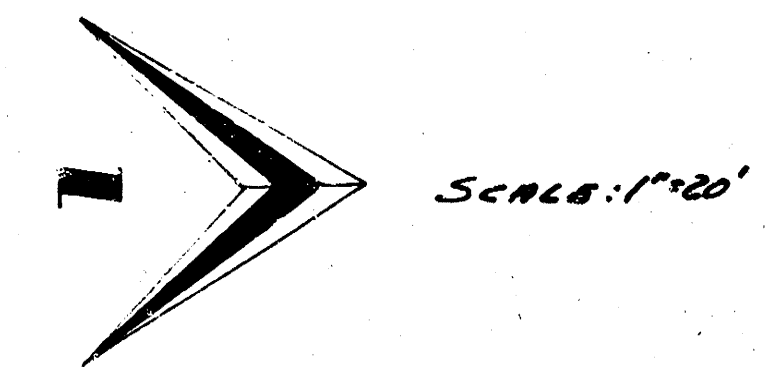

KANSAS AVENUE

