
5-6

BM 98.32 "G" in Globe S. end cb. N.E. cor. Minneapolis & NL Hodson.

22.8
19.4
19.0
17.0
19.0
19.3
19.1
22.6
158.2
175.9
334.1
34
368.1

SCALE 1"=20'

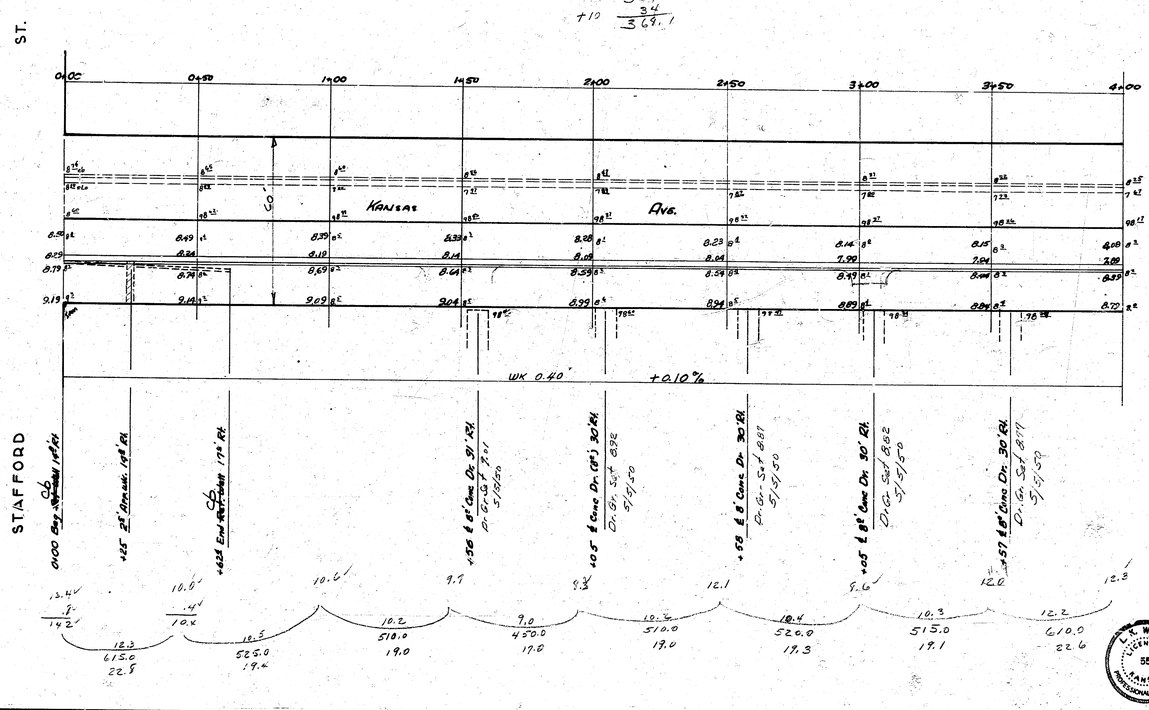


L.K. WHITE LICENSED 55 KANSAS PROFESSIONAL ENGINEER

1/2

KANSAS AVE., E. ½
NL STAFFORD ST. TO SL HODSON ST.
13-2-15 A.C.

CITY OF WICHITA, KANSAS
L.K. WHITE — CITY ENGINEER
OCT., 1951 — PROJ. NO. C 11-171

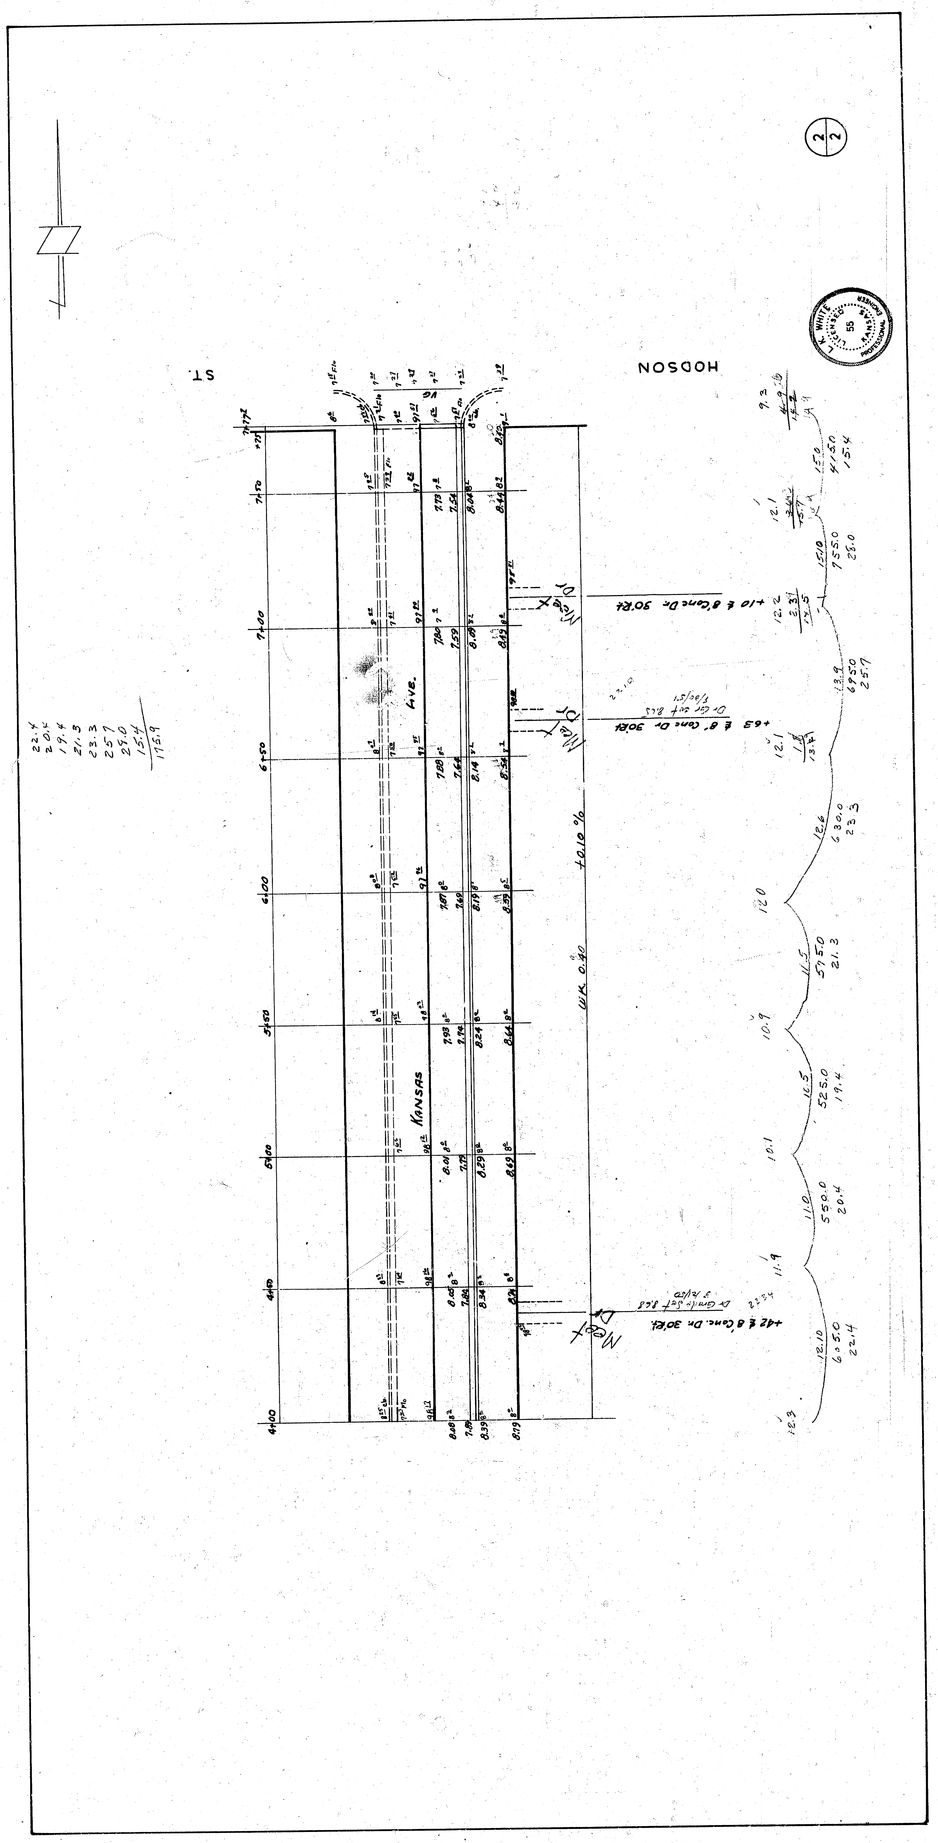
HODSON
ST.
KANSAS
AVE.
+10 ℄ 8' Conc. Dr. 30'R±
+63 ℄ 8' Conc. Dr. 30'R±
Gr. Cur. Left R±
+42 ℄ 8' Conc. Dr. 30'R±
Gr. Curb Left R±
+0.10 %
W.K. 0.30
2
2

B.M. 99.16 N.W. Corner conc. porch No.# 1731 SS. Stafford 2St w. of Kansas.
B.M. Book 39, p.64, 99.45 N.E. Cor. conc. porch, No. S.W. Kansas & Hodson.

N

-.10%
WK. 0.4

K A N S A S A V E.

STAFFORD

Property

	8.9
	10.0
	12.6
	6.9
	6.6
	2.2
	7.8
	13.3
	22.8
	24.0
	106.7
+10%	10.6
total	117.3

1/2

J.S. Bryan

W ½ KANSAS AVE.

SL. HODSON to NL. STAFFORD

13-2-15 A.C.

CITY of WICHITA, KANS.

Engineering Division

L.K. WHITE CITY ENGINEER

July 1947

443 (51)

(2/2)

