




394

NOTE:~
Any fill under pavement other than in sewer ditch is to be stabilized by mixing $\frac{1}{3}$ sand with $\frac{1}{3}$ dirt & compacting with sheepfoot roller.

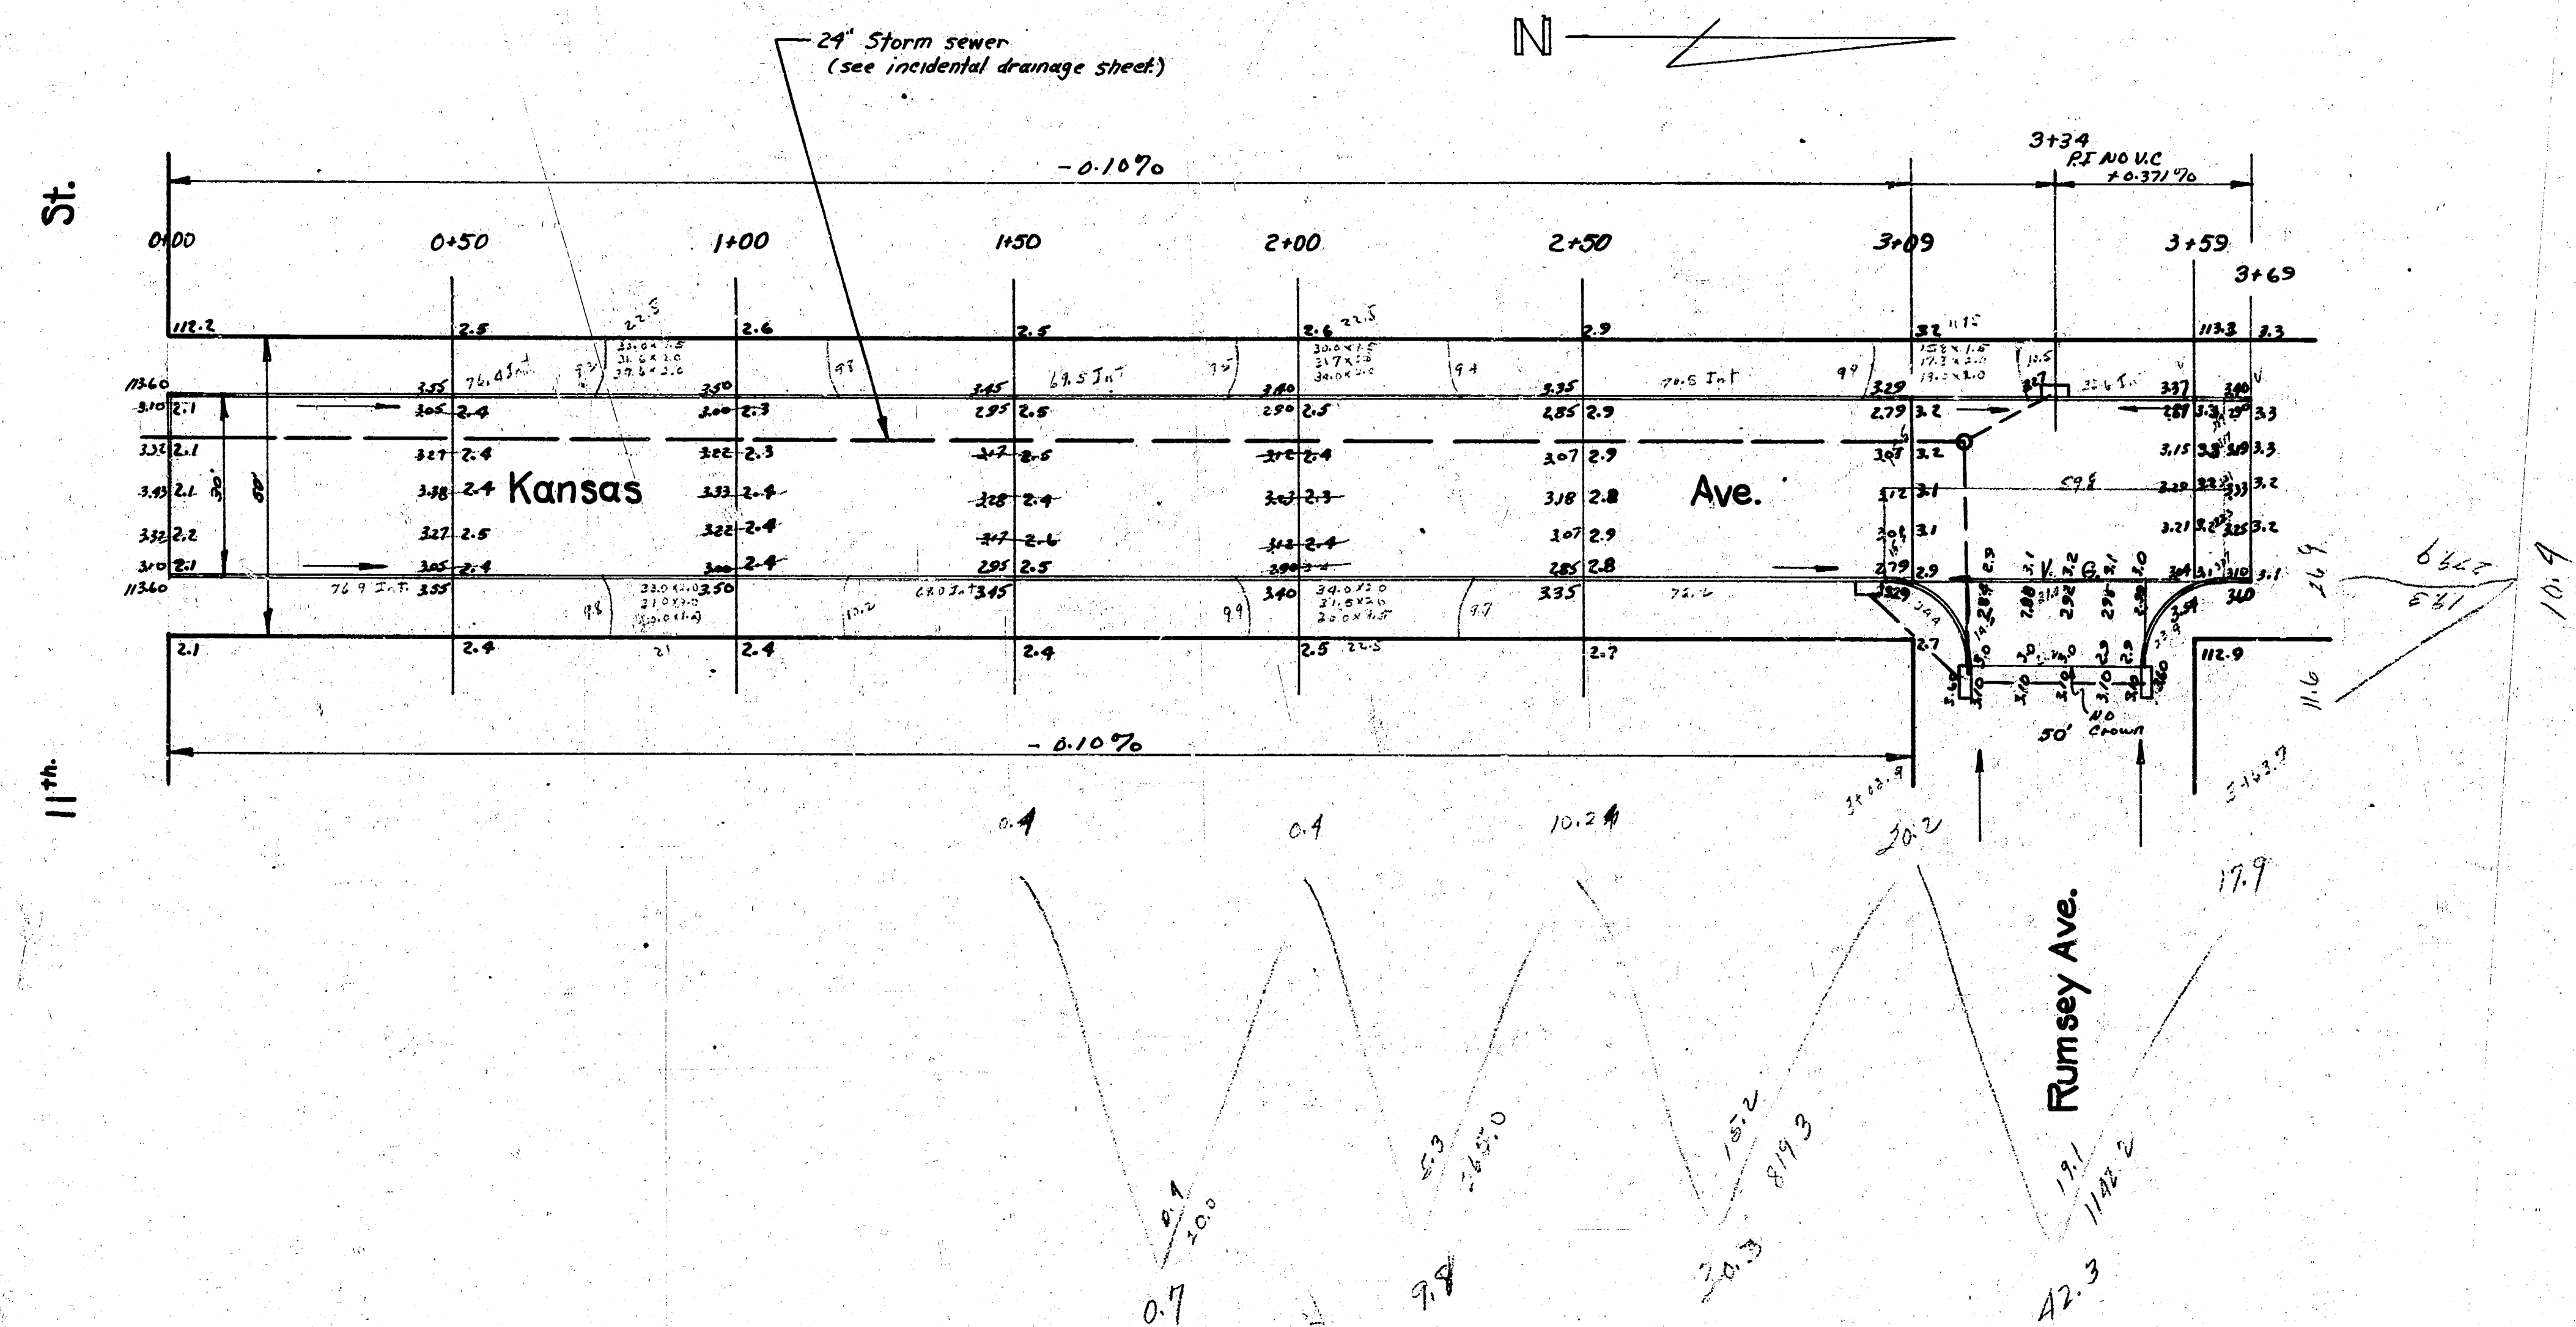

Kansas Ave.
N.L. 11th to 10th N. of N.L. Rumsey
30' conc. & curb
City of Wichita, Kansas
L. K. White ~ City Engineer
Oct. 1950 Private Job

B.M. 116.39 ~ Min. Mueller, fire hydr., N.W. corner Hydraulic & 11th

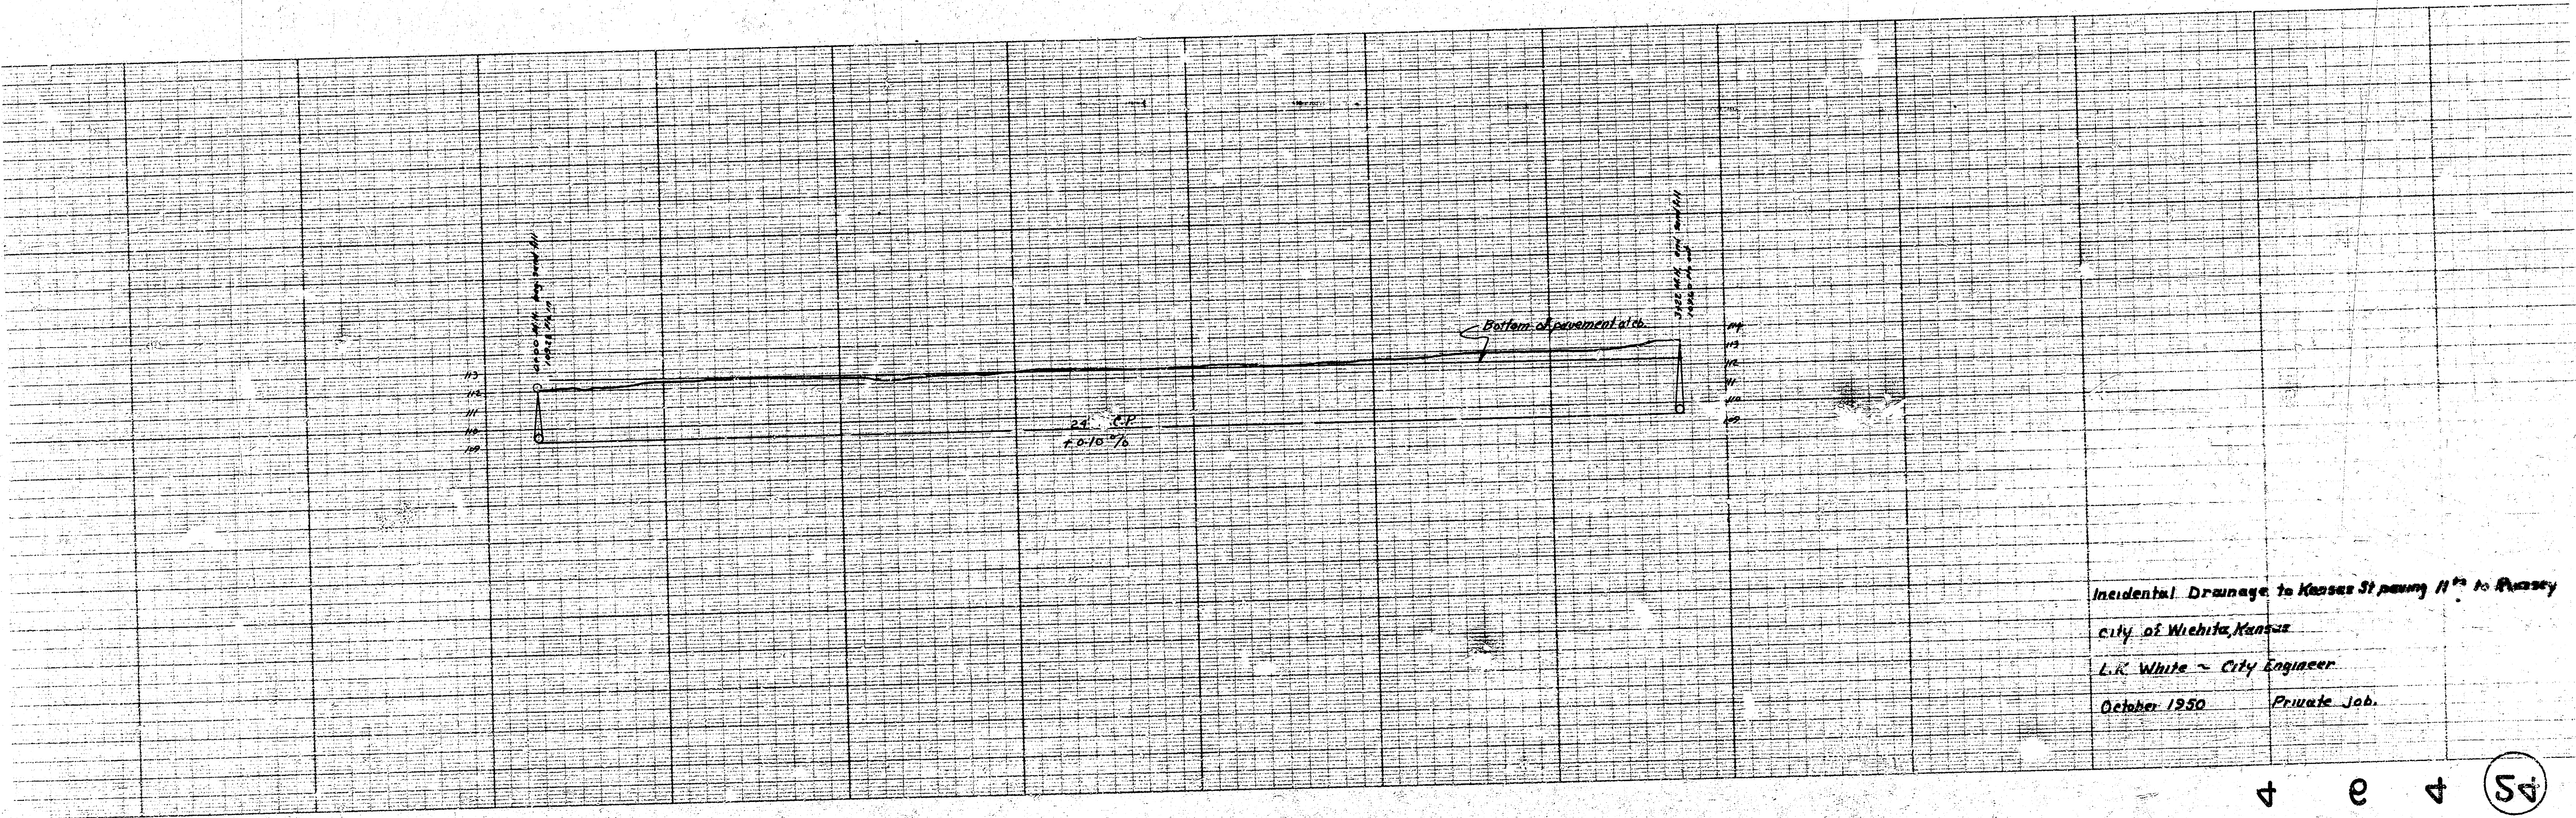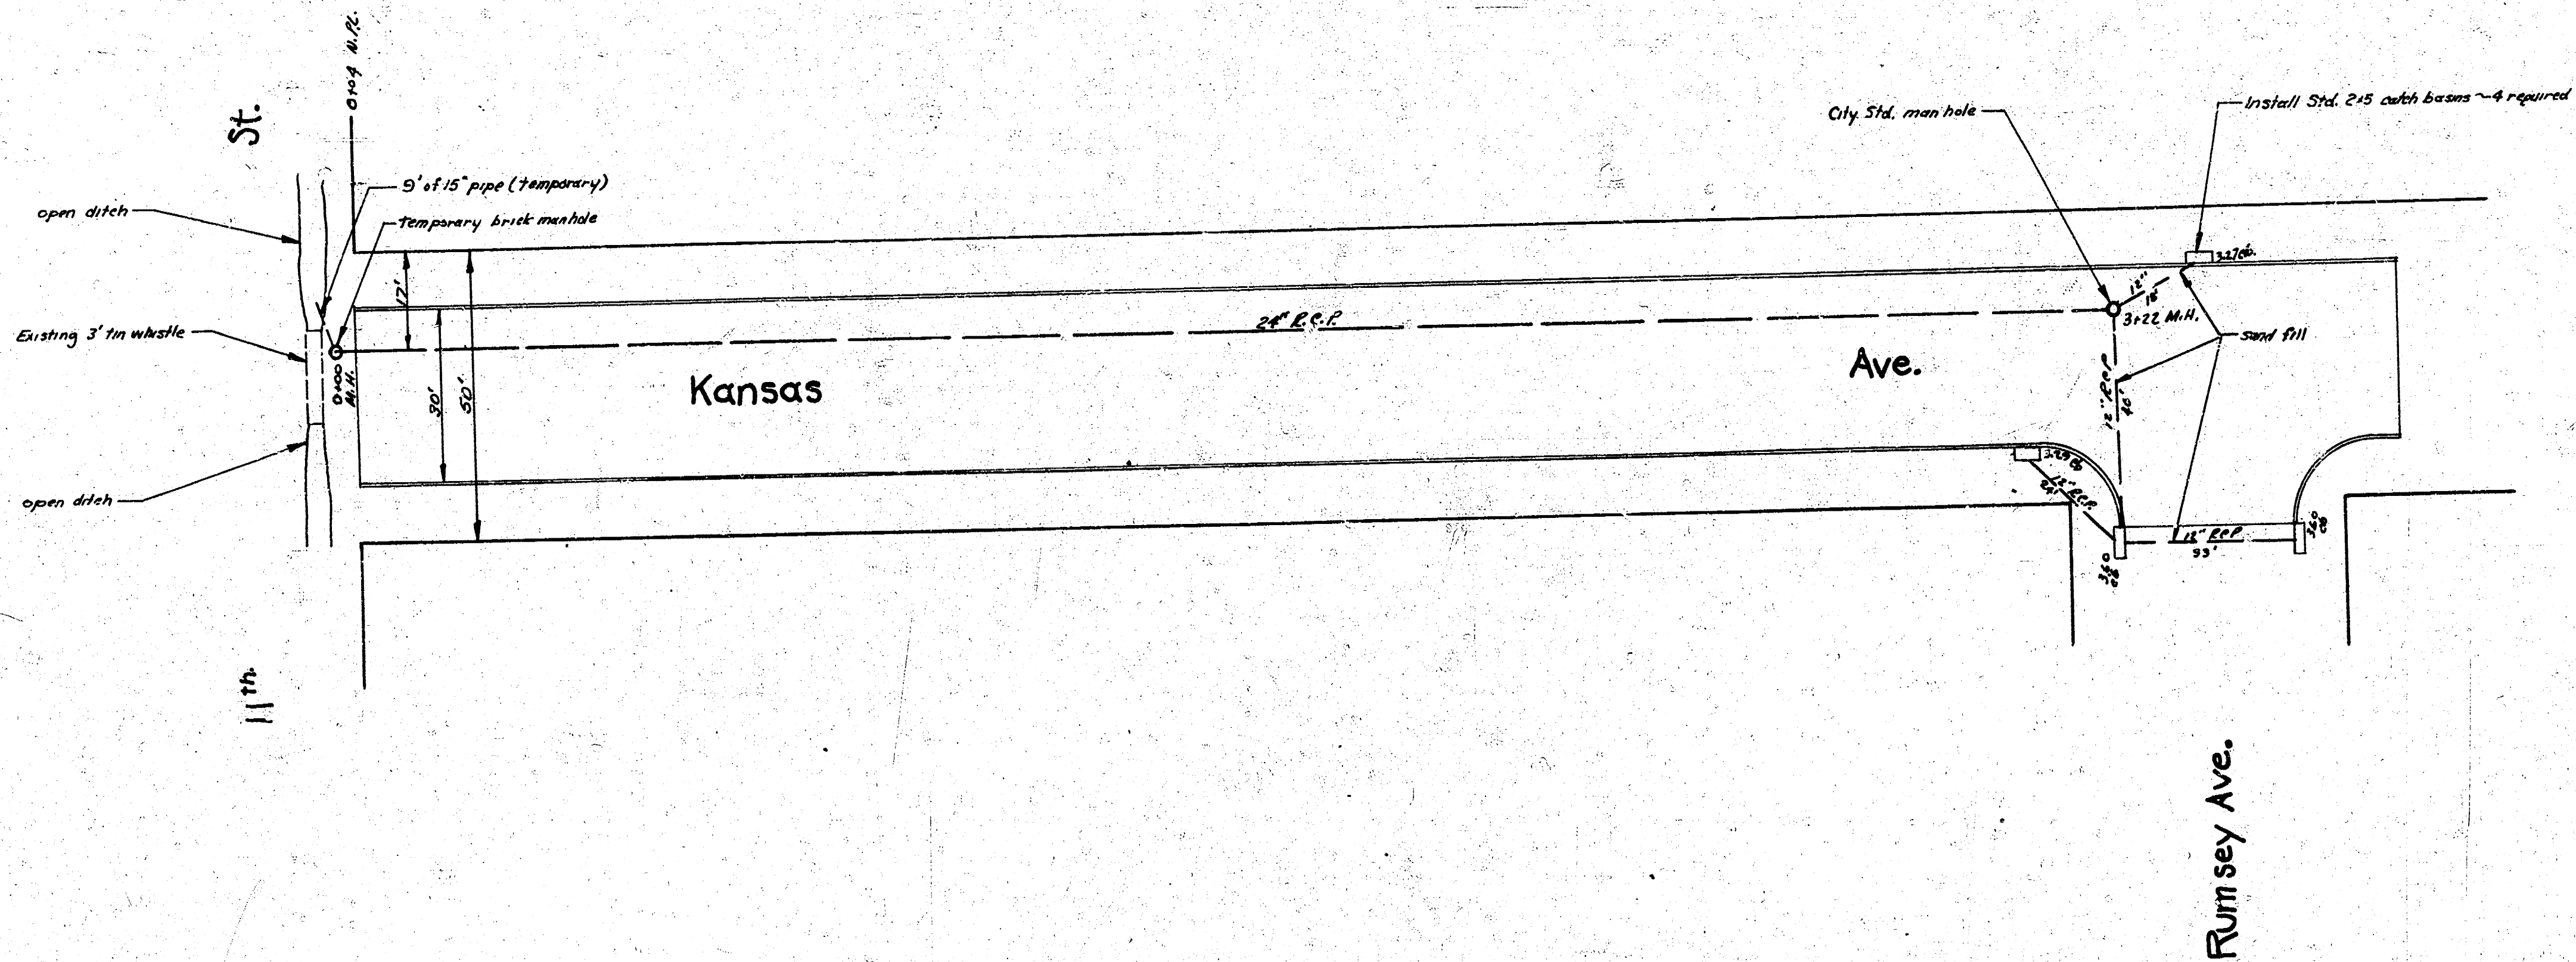

Incidental Drainage to Kansas St passing H^{rs} to Quarry
City of Wichita, Kansas
L.R. White ~ City Engineer.
October 1950 Private Job.