PUB. ROAD DIV. NO.	STATE	PROJECT NO.	FISCAL YEAR	SHEET NO.	TOTAL SHEETS
8	KANSAS		1969	6	13

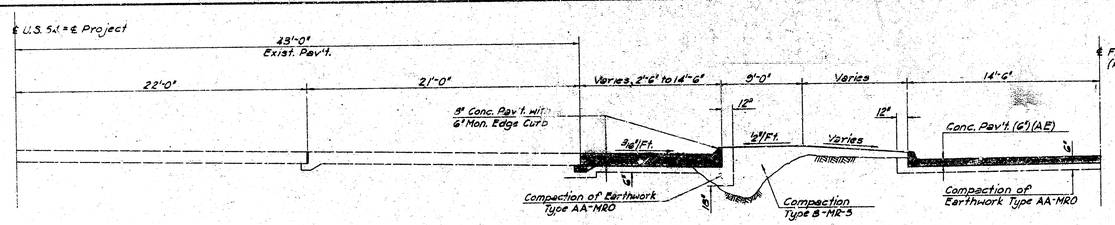

SCALE 1"=20

TYPICAL SECTION
STA. 153+22.6 TO STA. 160+95.0

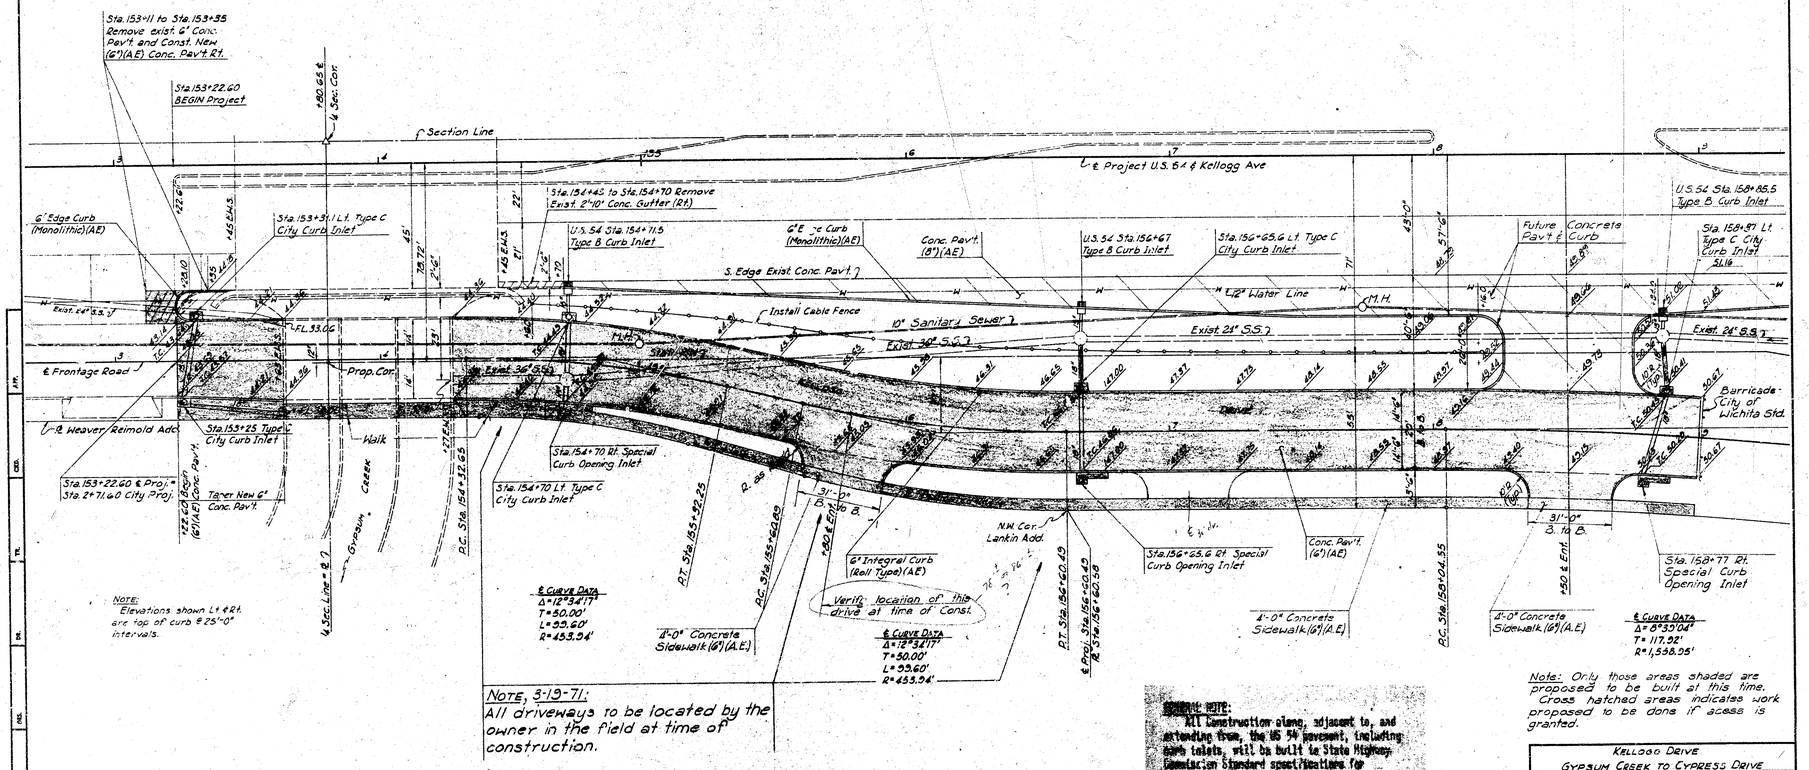

NOTE: Elevations shown Lt. & Rt. are top of curb @ 25'-0" intervals.

NOTE, 3-19-71:
All driveways to be located by the owner in the field at time of construction.

SPECIAL NOTE:
All Construction along, adjacent to, and extending from, the US 54 pavement, including curb inlets, will be built to State Highway Commission Standard specifications for materials and construction; all construction on Kellogg Drive will be in accordance with City of Wichita standards.

Note: Only those areas shaded are proposed to be built at this time. Cross hatched areas indicates work proposed to be done if acess is granted.

NO.	BY	DATE	REVISION
1	CEL	4-5-70	Added Sidewalk Details.

KELLOGG DRIVE
GYPSUM CREEK TO CYPRESS DRIVE

PAVEMENT DETAILS

R. S. DELAMATER
CONSULTING ENGINEER
WICHITA, KANSAS

DATE: Dec. 1969
SCALE
DWG. NO. 231-A-6

SUB ROAD DIV. NO.	STATE	PROJECT NO.	FISCAL YEAR	SHEET NO.	TOTAL SHEETS
5	K- 156-7		1969	7	13

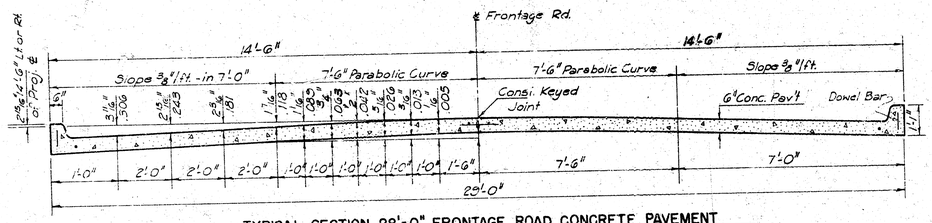

TYPICAL SECTION 28'-0" FRONTAGE ROAD CONCRETE PAVEMENT

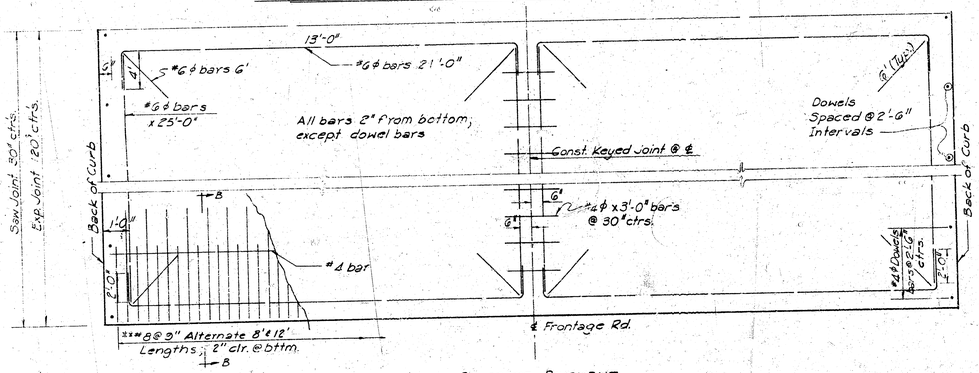

CONCRETE PAVEMENT STEEL PATTERN

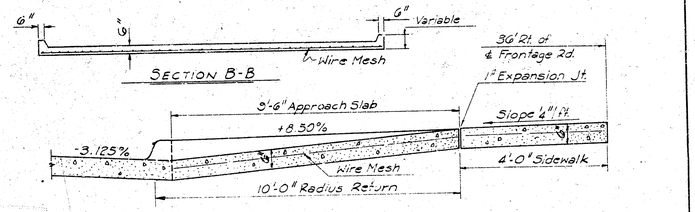

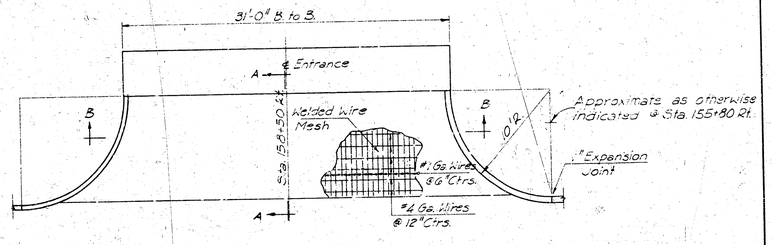

TYPICAL PLAN FOR CONCRETE ENTRANCE PAVEMENT

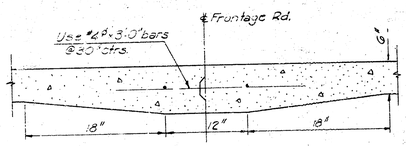

KEYED JOINT DETAIL

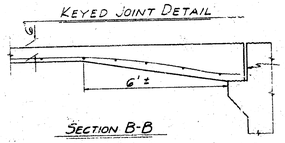

SECTION B-B

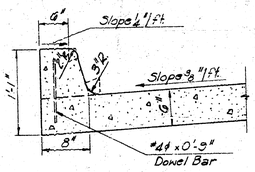

TYPICAL SECTION OF FRONTAGE ROAD INTEGRAL CURB (FULL CURB)

SUMMARY OF QUANTITIES

Item	Quan.	Unit

GENERAL NOTES:

CONCRETE: Class A Concrete (AE) shall be used throughout the Project, and shall confore to State Highway Standard Specifications (1965 Edition), Except (Section J 4-1(3)): Change percentage of wear loss from 50% to 40%.

REINFORCING STEEL: All reinforcing steel used on Inlets, Manholes and Storm Sewer shall confore to State Highway Standard Specifications (1966 Edition);
All reinforcing used in the construction of the Concrete Paving, Integral Curb & Entrance shall confore to current City of Wichita Specifications.

EXPANSION & CONTRACTION JOINTS: Expansion joints shall be 5" of premolded Expansion Joint Filler (nonextruding, Type B) and 1" of hot or cold poured Joint Sealing Compound at all locations as required by Engineer or Inspector.

The contraction and expansion joints shall be spaced to confore to current City of Wichita specifications.

WELDED WIRE MESH: Welded wire mesh shall not be paid for at unit, but shall be subsidiary to concrete pavement. Approx. weight of welded wire mesh = 61 Lbs. per 100 Sq. Ft.

No.	By	Date	Rev. Part details
2	C.E.L.	10-11	

KELLOGG DRIVE
GYPSUM CREEK TO CYPRESS DRIVE

CONCRETE PAVEMENT
AUXILIARY DETAILS
KELLOGG DRIVE

R. S. DELAMATER
CONSULTING ENGINEER
WICHITA, KANSAS

DATE Oct. 12, 19 68
SCALE —
D-
24-12-7