B.M. 82.34 S.E. corner conc. porch Ho. # 5245 S. Kansas

B.M. 80.00 R.R. Spike W. side wood street light pole, N.E. corner Kansas & Idlewild.


B.M. 80.99 S.W. corner bottom conc. step S. side S. Riverside Int. School, N.E. Cor. 51st St. S. & Kansas.

Scale: 1" = 20'

N

NOTE:
Contractor to clear right-of-way, grade parkings and compact Fill for proposed sidewalk. Sidewalk to be constructed by others.

NOTE:
Depress curb through driveways.

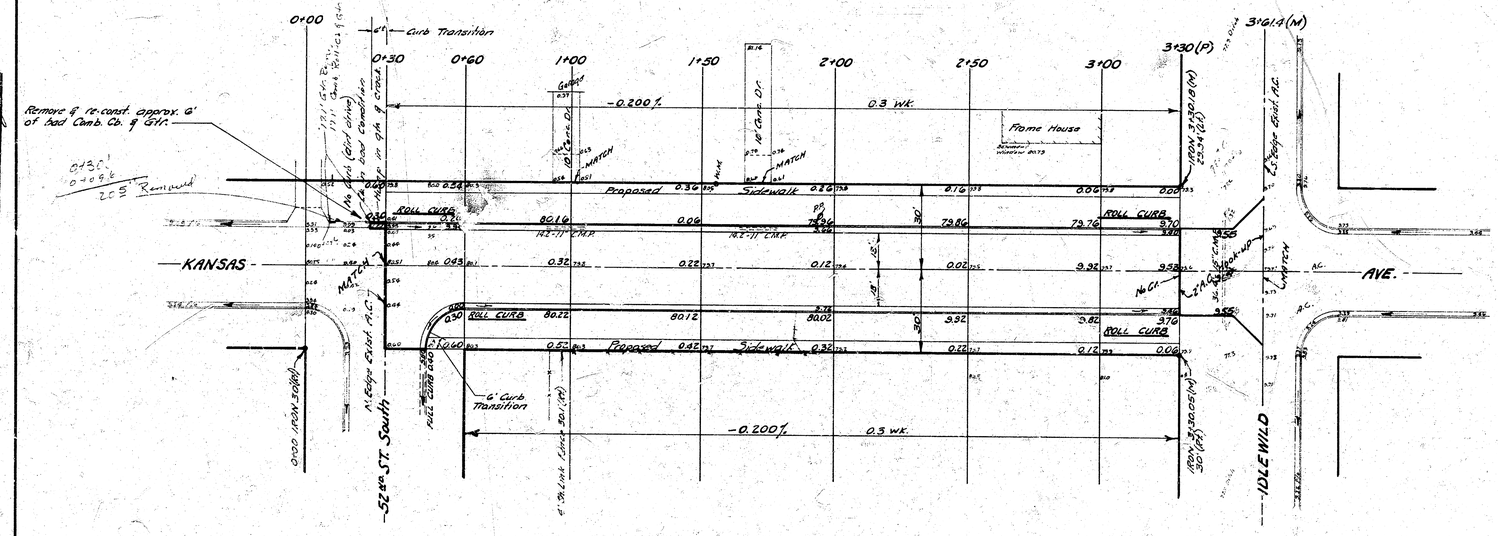

PROPERTY		CITY	
EXCAVATION	COMP. FILL	EXCAVATION	COMP. FILL
23 Cu.Yds.	77 Cu.Yds.	19 Cu.Yds.	5 Cu.Yds.
± 10% 2 "	8 "	2 "	
Totals 25 Cu.Yds.	85 Cu.Yds.	21 Cu.Yds.	5 Cu.Yds.

R. W. LINK 9294 REGISTERED PROFESSIONAL ENGINEER

JOHN ALLEN 821 KANSAS REGISTERED PROFESSIONAL ENGINEER

B. E. SMITH LICENSED 436 KANSAS PROFESSIONAL ENGINEER

1/2

KANSAS AVENUE
C.L. 52nd. STREET South to S.L. IDLEWILD
26-2-30 A.C. (Asph. Base)
B.E. SMITH CITY ENGINEER
CITY OF WICHITA KANSAS
Date: Aug. 1968
Project No. C18-78