Crane St. – E.L. Bluff. to W.L. Broadview

BM. Elev. 165.35 X on W.E. curb radius S.W. cor Fountain & Crane
~~164.43~~ E end curb rad. S.E. cor Crane & Broadview
164.43

Note: Add 60' to Elevations.

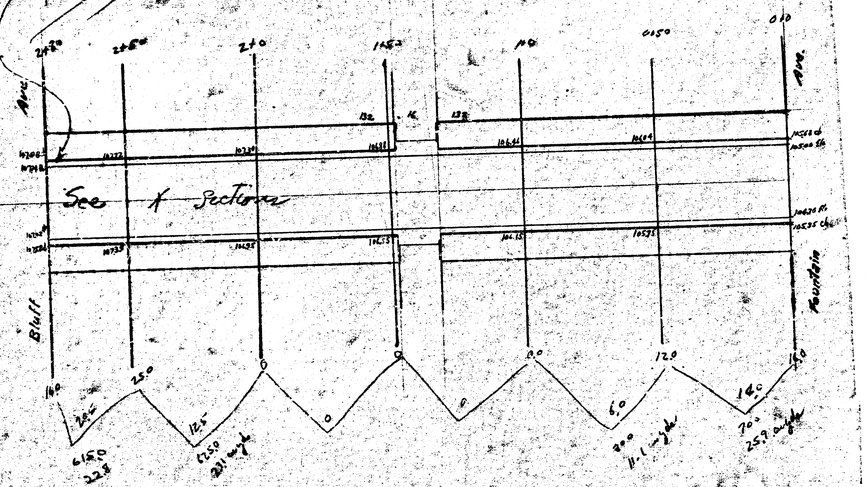

Prop: 82.9
604.1
687.0 + 6.9 = 754.0

Cut – 60.8 + 6.0 = 66.8
822.8 cu yds

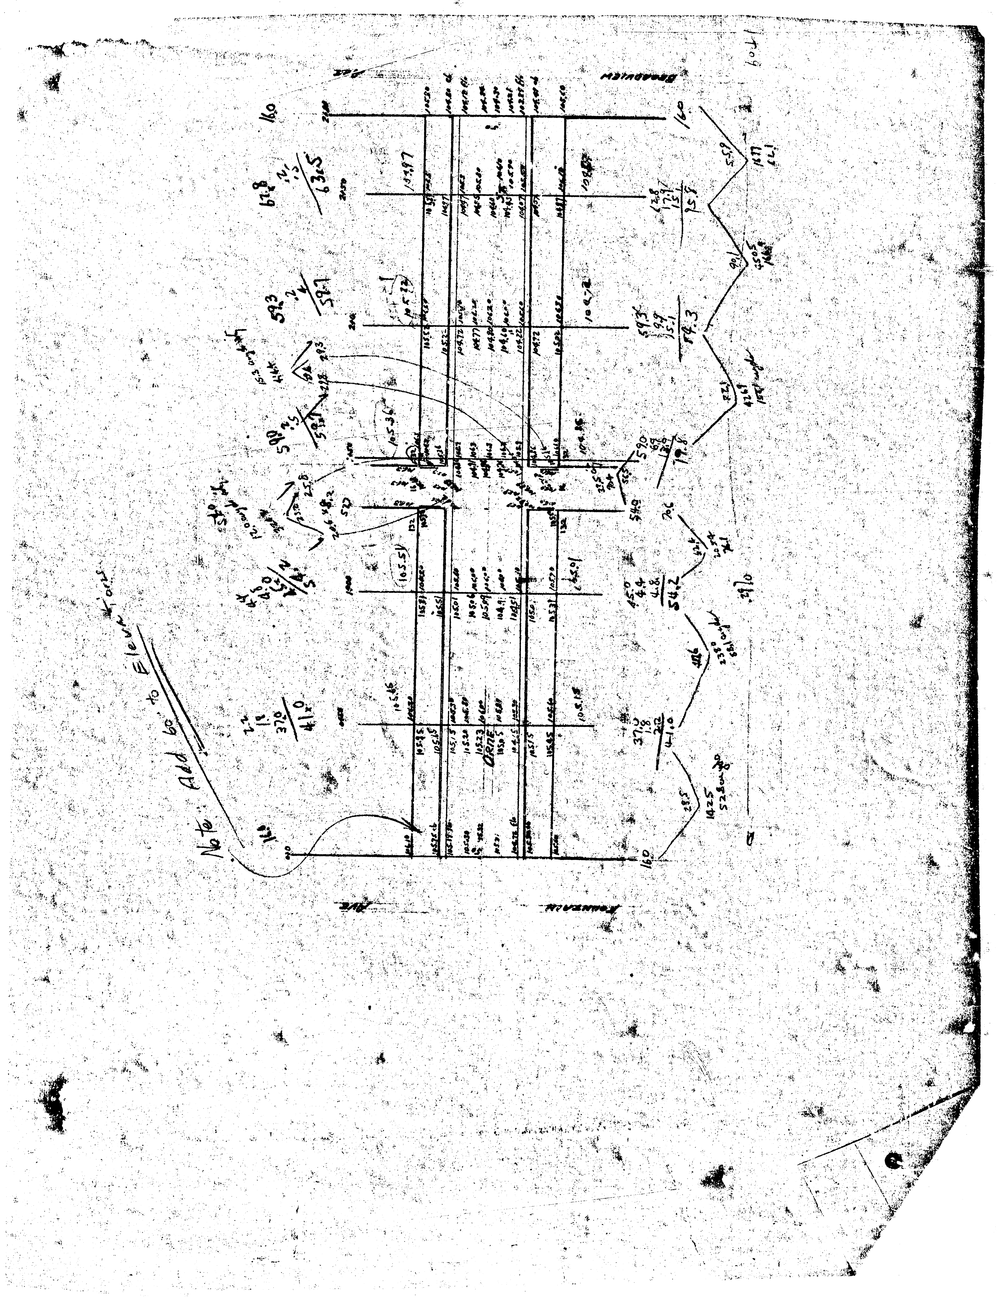
Note: Add 60' to Elevations
