


B.M. Elev. 106.09 N in front of 1st d. W. Co.
 107.42 E. end of rd. A.E. Estelle + Orme

Orme St. - E.L. Estelle to W.L. Volusia

26 - 2 - 30 Concrete

Final figures for excavation

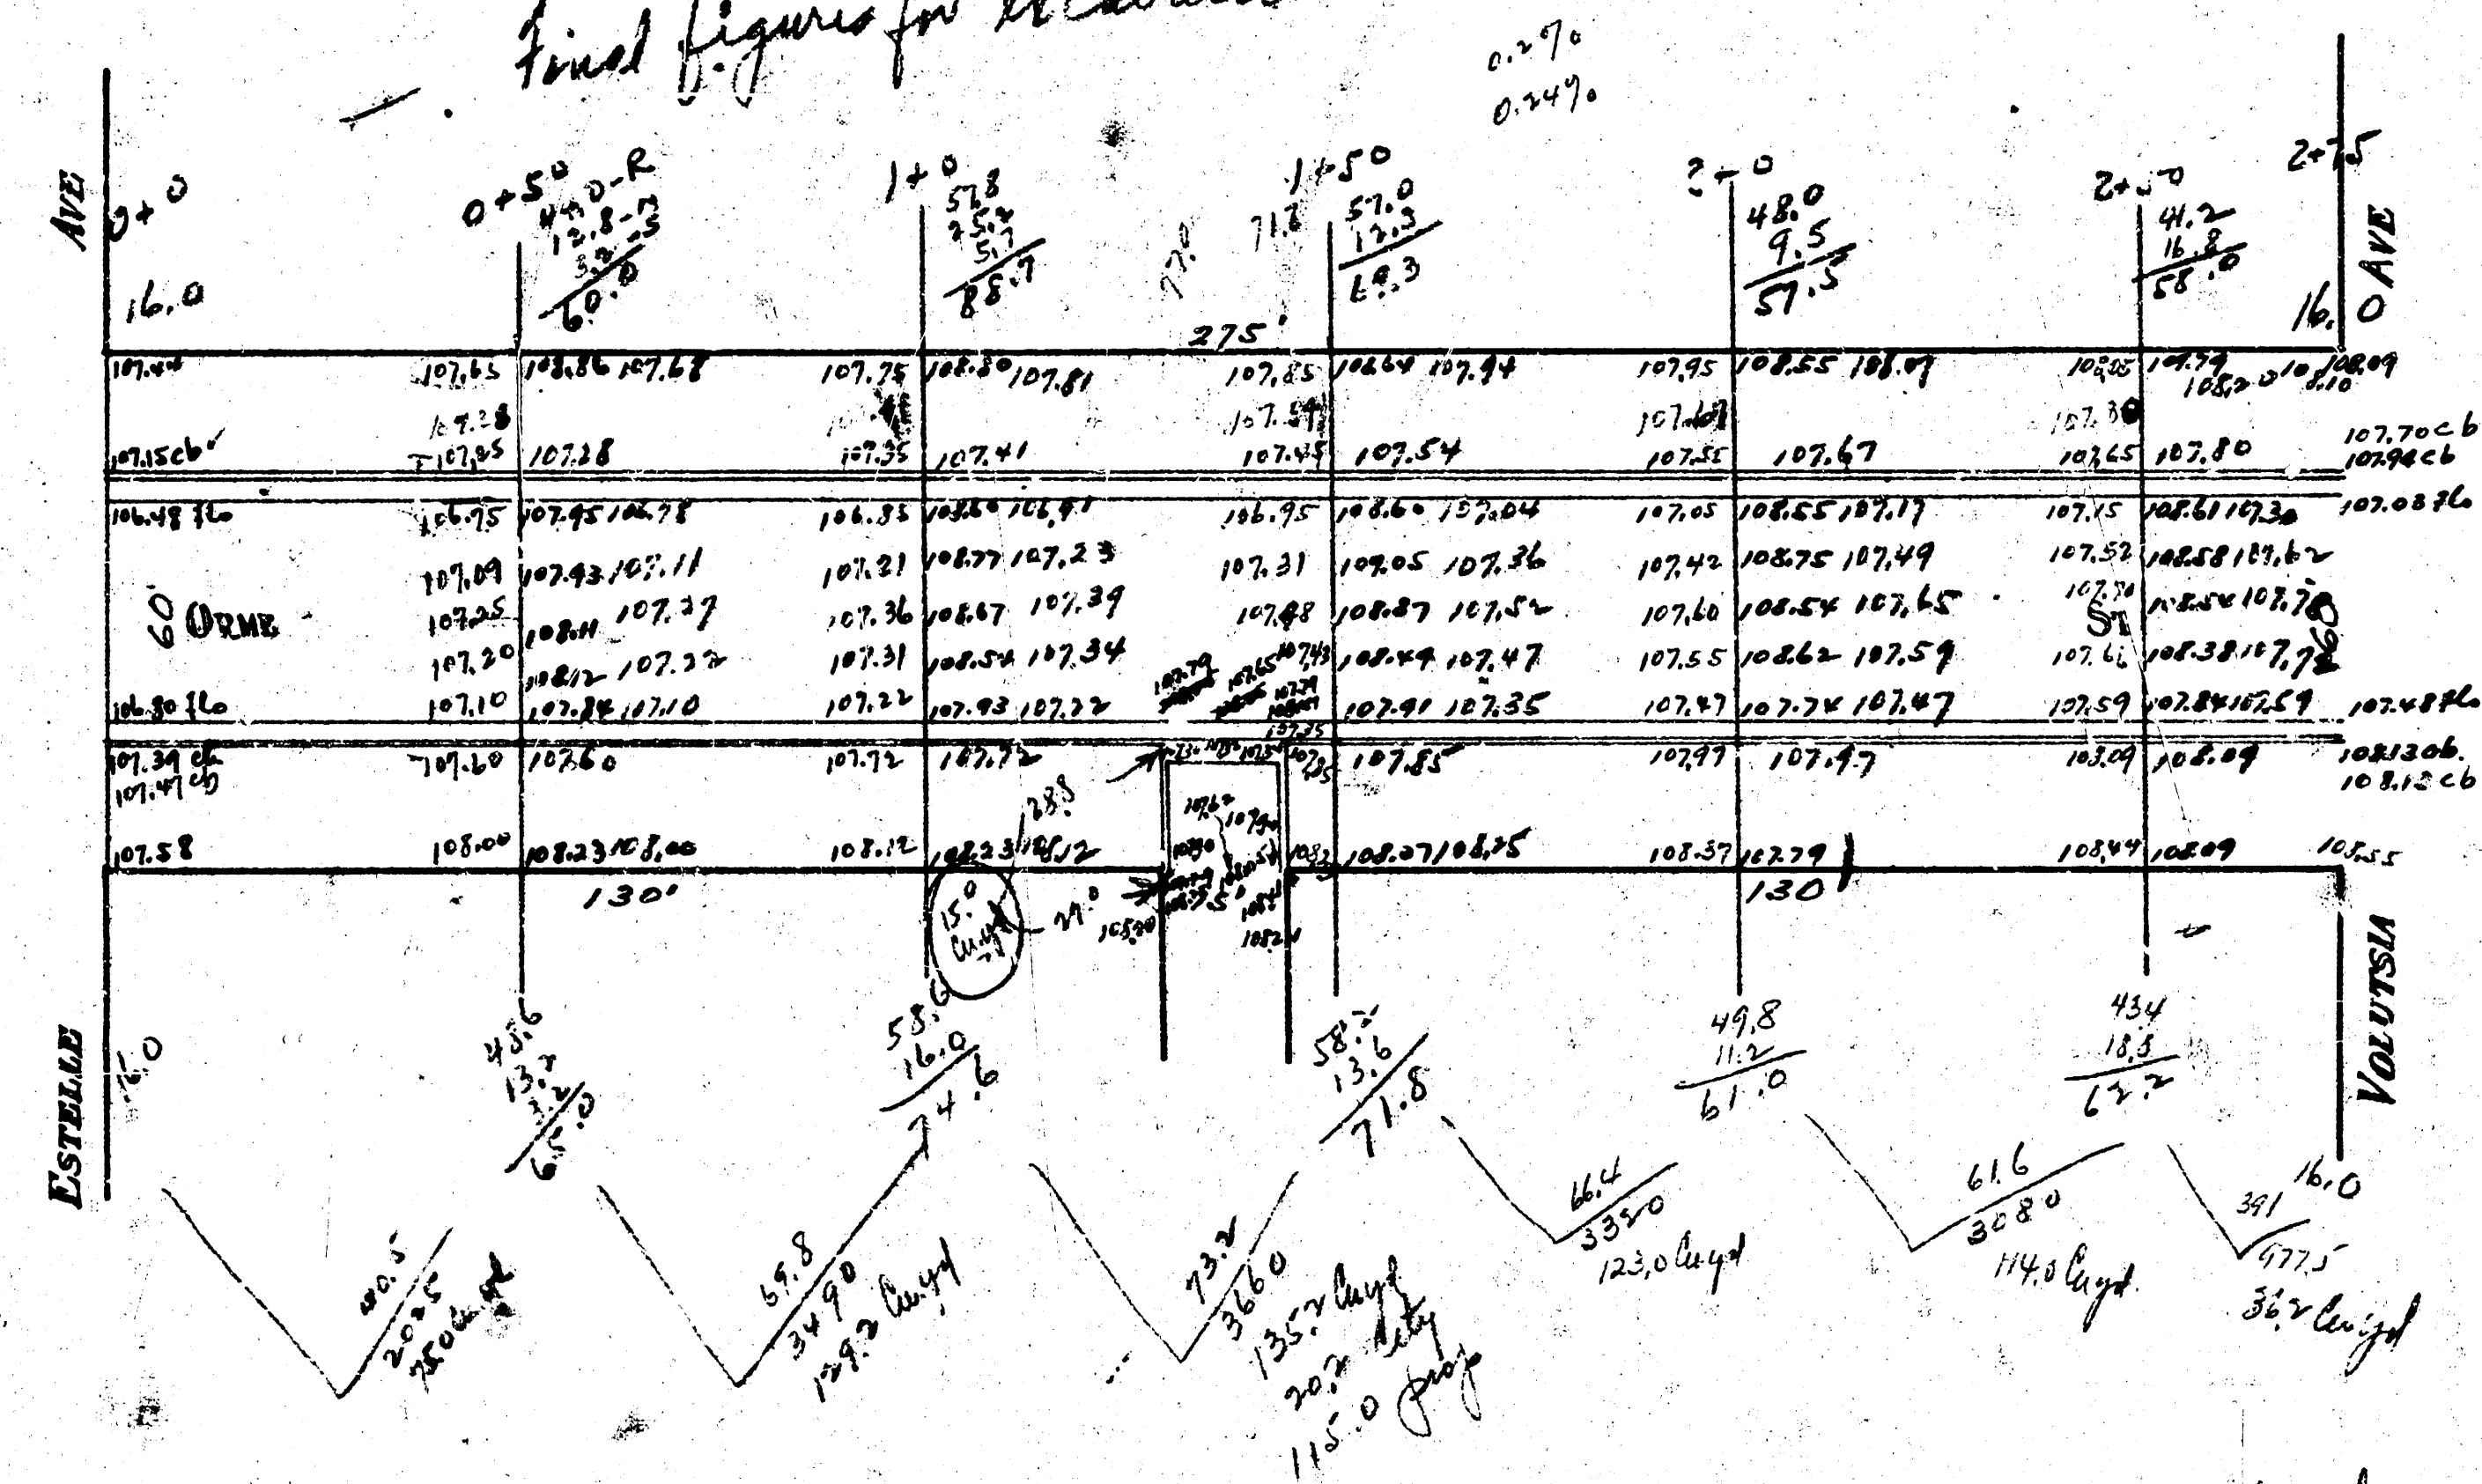

$$P.W.P. = 59.24 + 10.0 = 69.24 \text{ cu yd}$$

$$cut = 25.7 + 10.0 = 35.7 \text{ cu yd}$$

Paving Plan
 1937
 Orme St
 E.L. Estelle
 W.L. Volusia