


B.M. 157.13 6" in Globe on Rod. N.W. Cor. Beverly Dr. & Orme
 B.M. 160.11 6" in Globe on E. End Rod. S.E. Cor. Marcilena Terrace & Orme

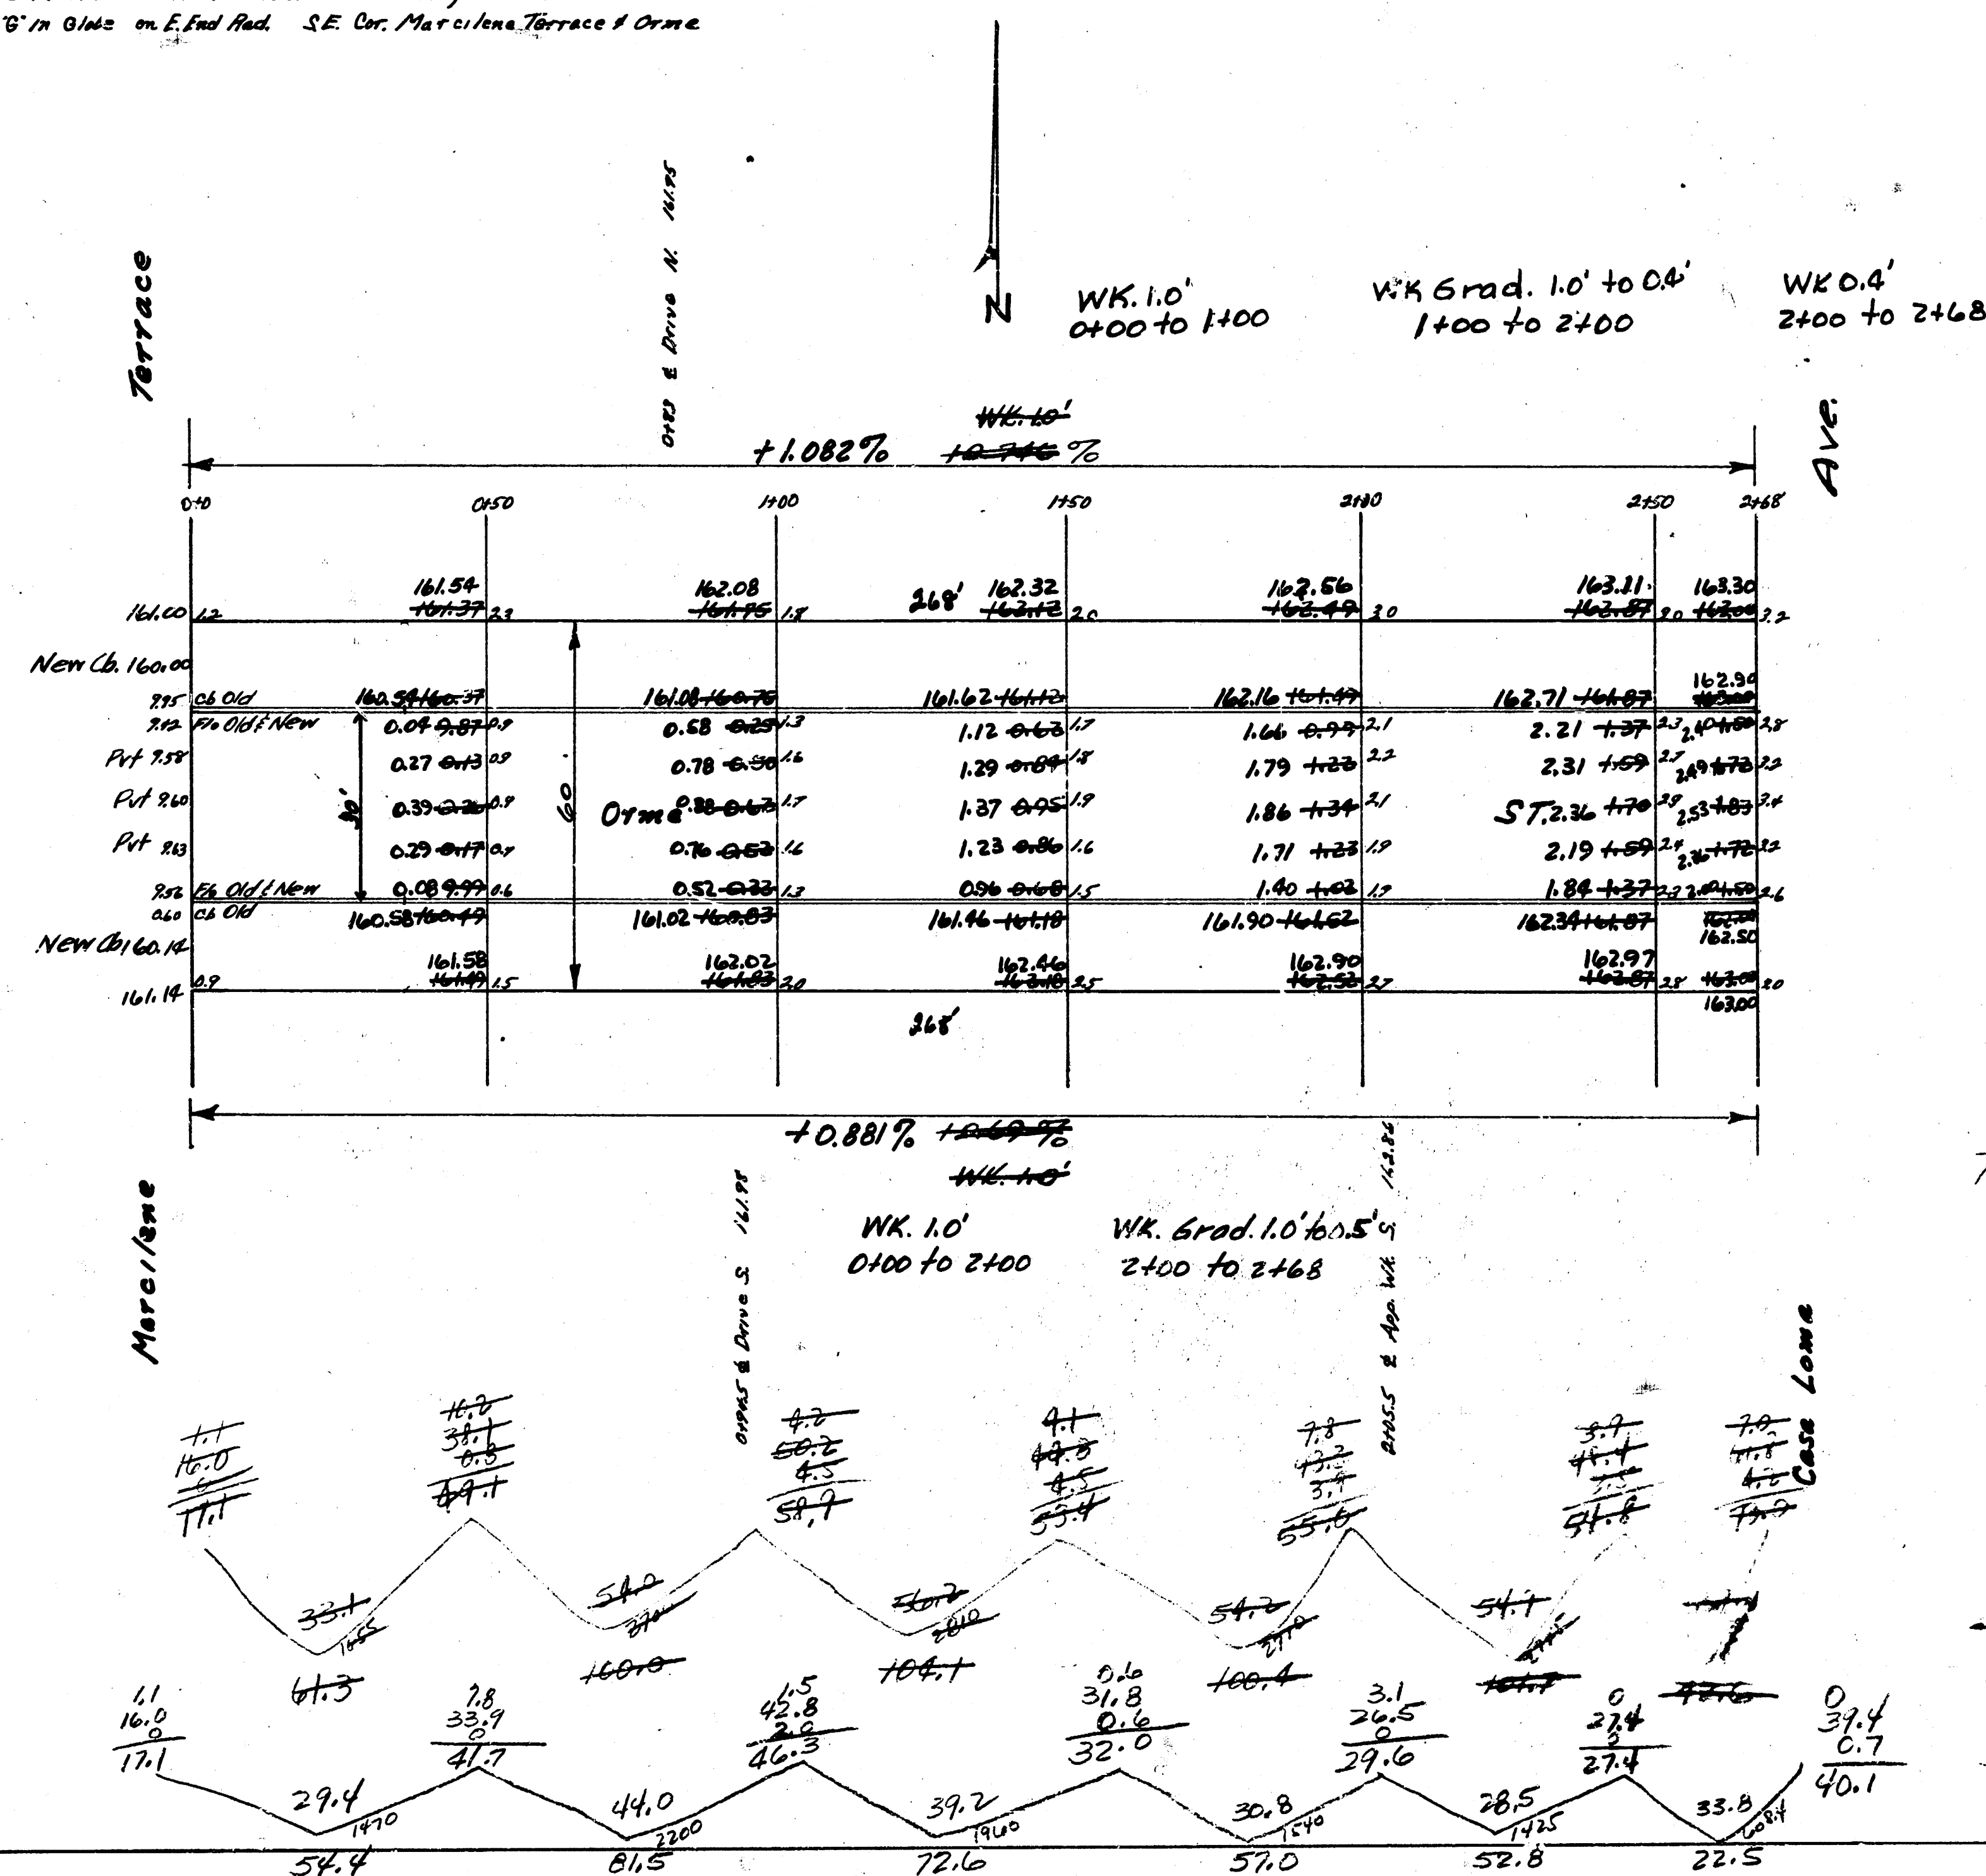

Prop
 54.4
 81.5
 72.6
 57.0
 52.8
 22.5
 340.8
 +10.1
 total 374.9 cu. yds.

Prop.
 51.8
 120.0
 15.4
 16.4
 16.7
 42.6
 510.1
 +10.1
 Total 561.1 cu. yds.

Orme St.
 E.L. Marcilena Terrace - W.L. Casa Loma
 30' Conc. Cb.
 City of Wichita, Kansas
 L.H. White City Engineer
 May 1948 Project C-18-72