



N
Scale: 1"=20'

B.M. 148.93 "B" on curb S.L.
Gilbert on W. curb Eastern.

B.M. 142.78 "B" cut top W. curb
Eastern @ E. Orme Street, E.

NOTE:

Contractor to clear right-of-way and grade
parking for proposed sidewalk. Sidewalk to
be constructed by others.


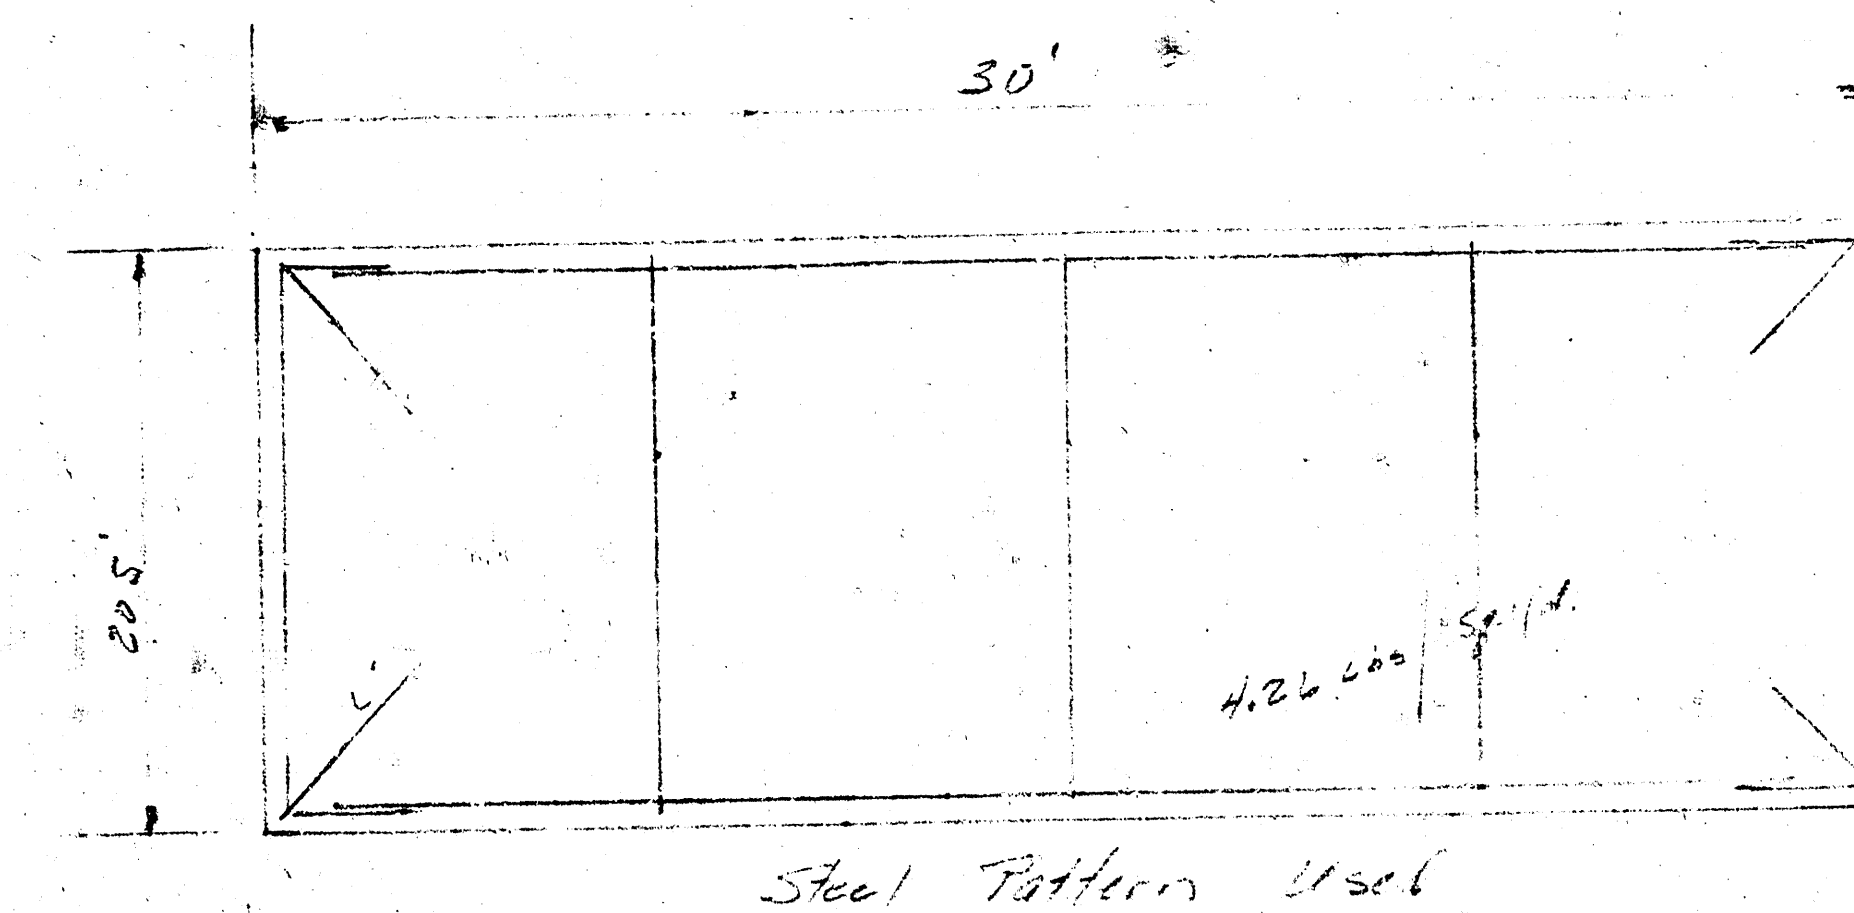
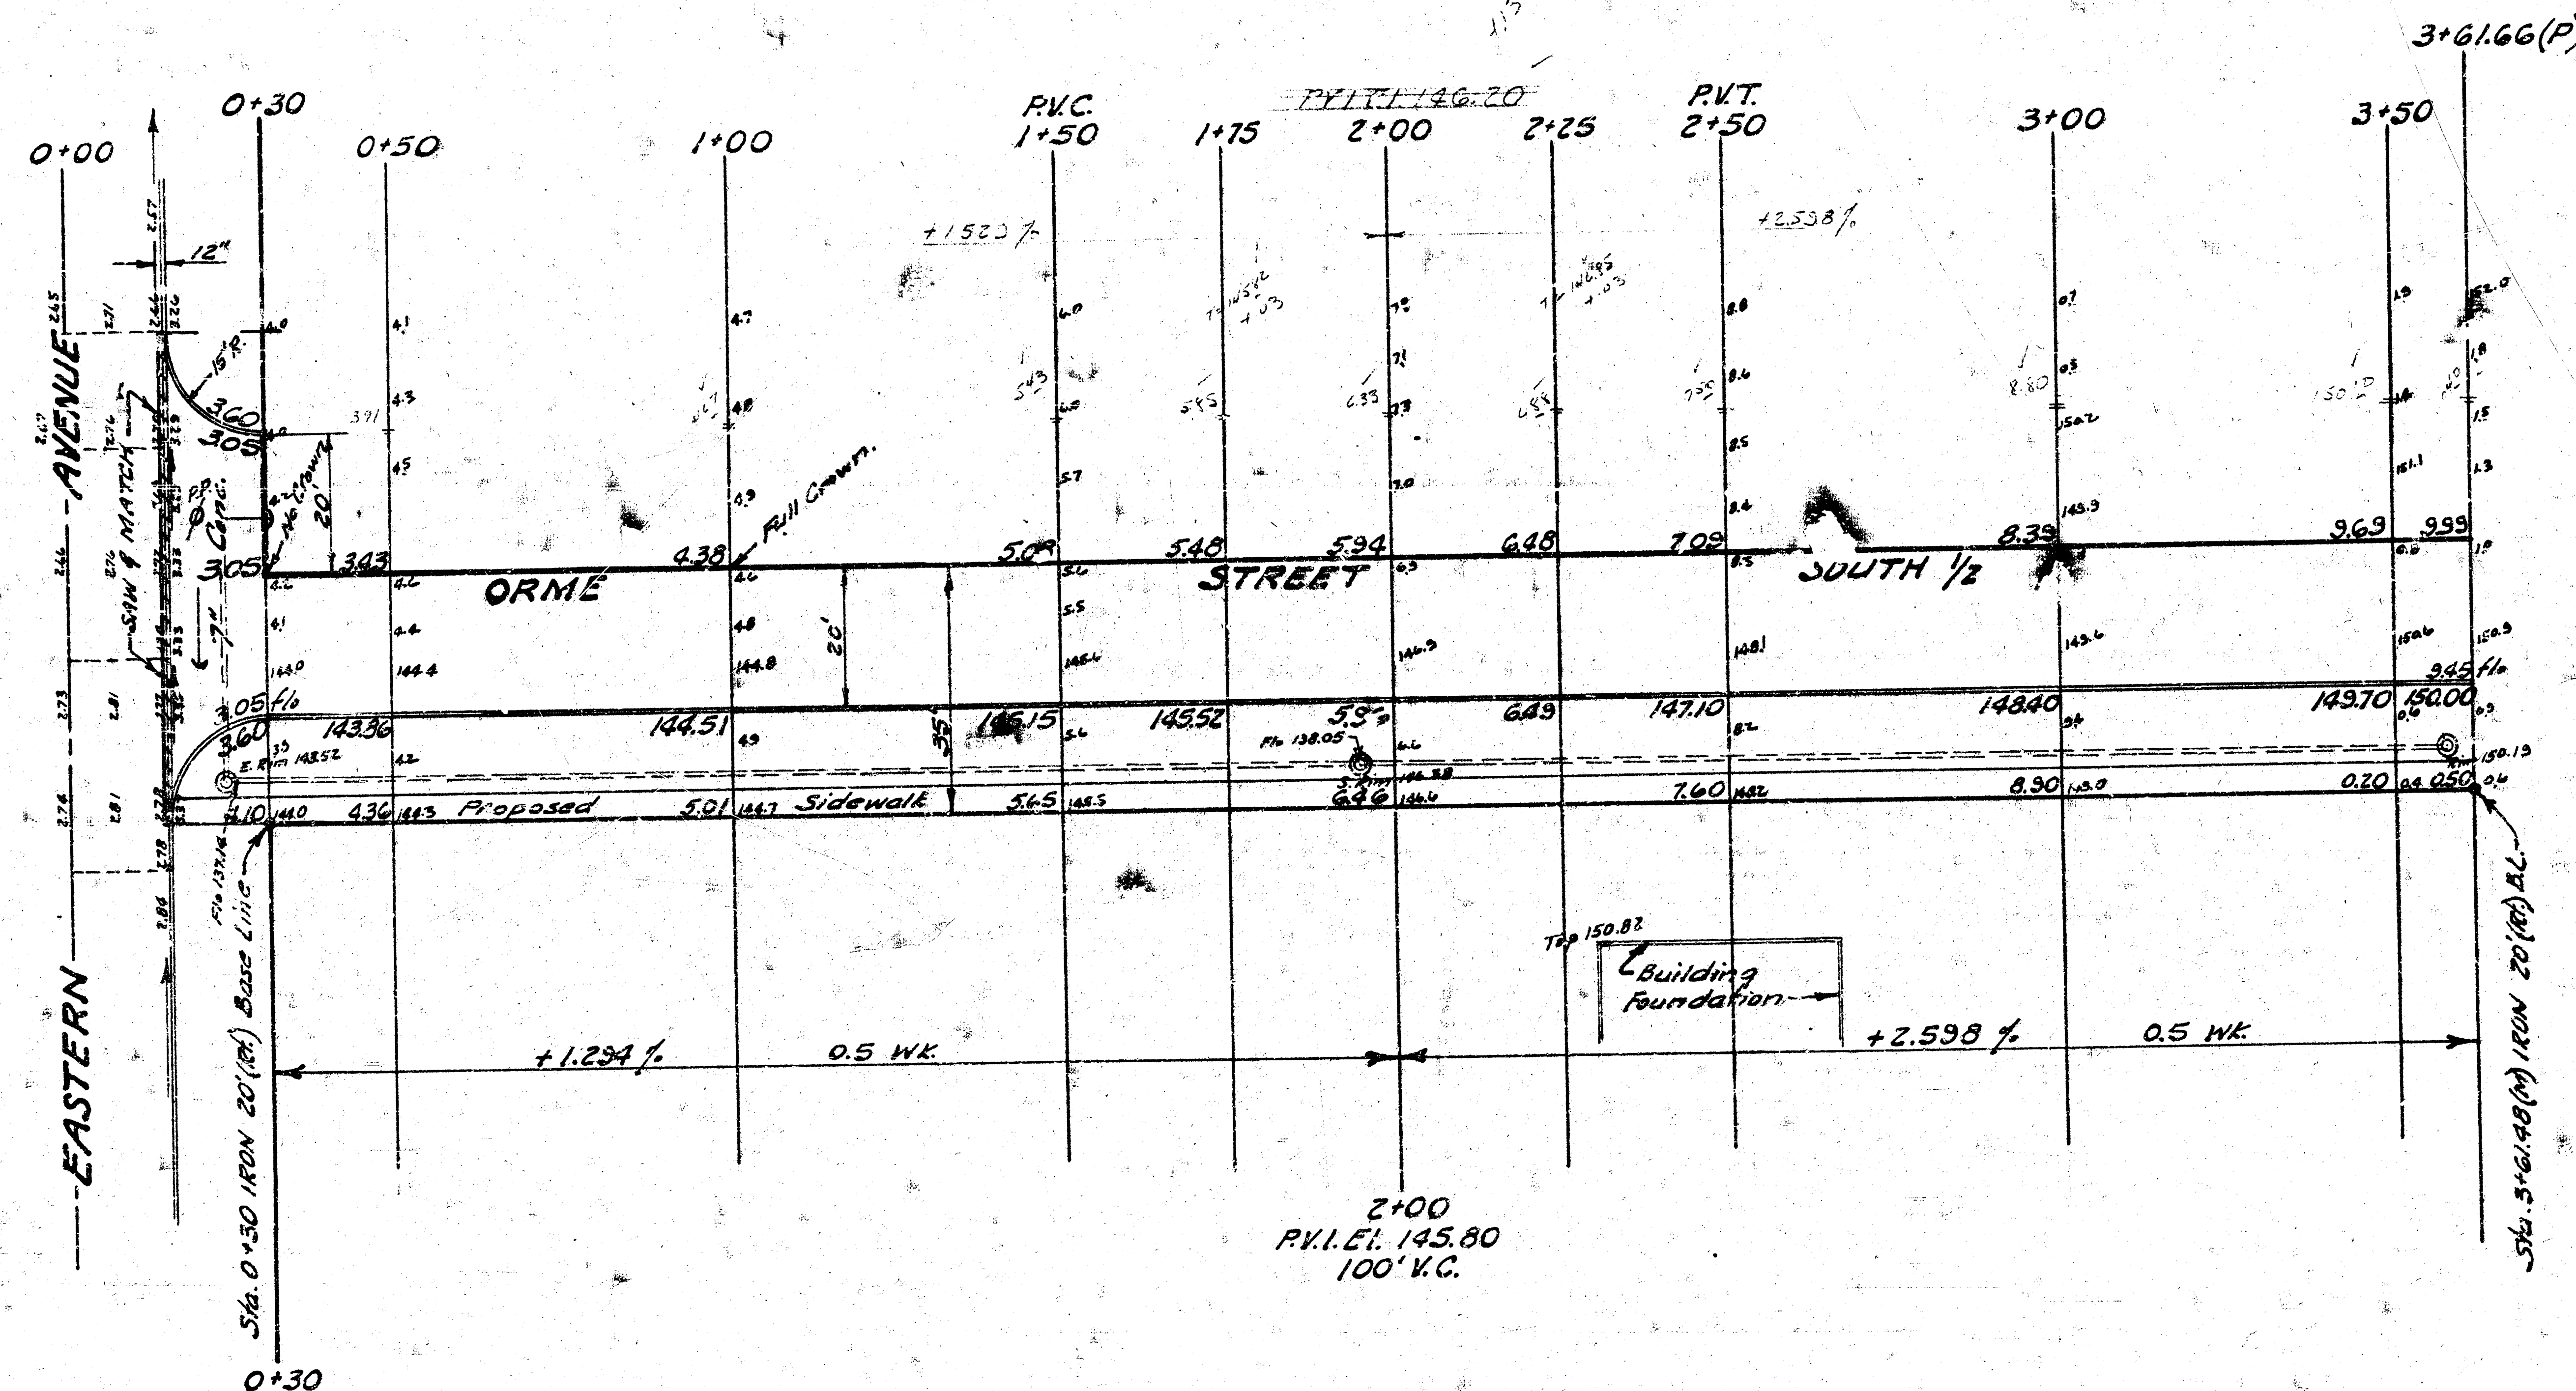


2.5
2.3
2.1
1.9
1.7
1.5
1.4
1.3

50
24.5
21.5
60.0
131

EXCAVATION

PROPERTY	CITY
495 Cu. Yds.	39 Cu. Yds.
+10 % 49 "	4 "
Totals 544 Cu. Yds.	42 Cu. Yds.

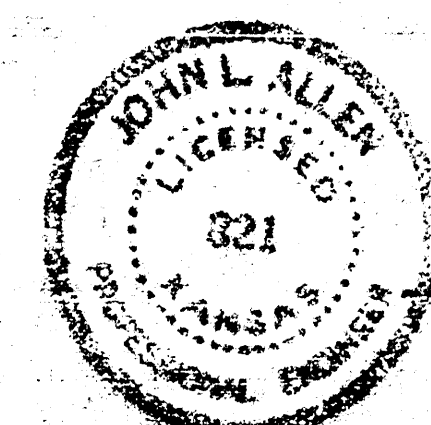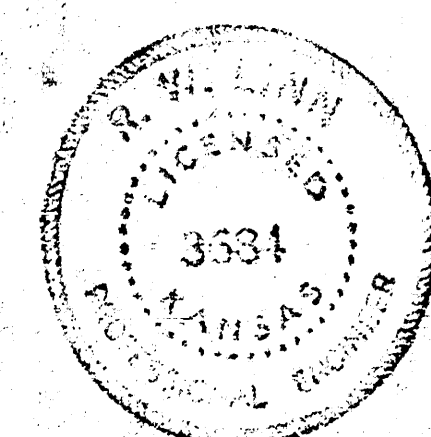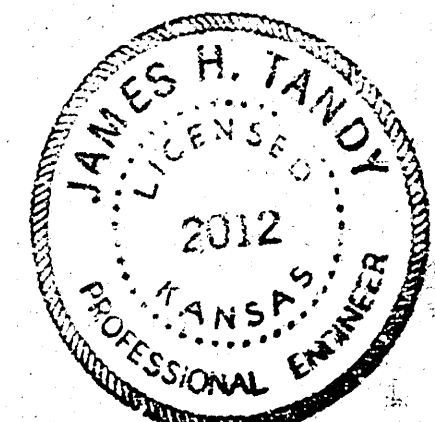

Final
June 24, 1968

1/2

ORME STREET S. 1/2
E.L. EASTERN AVE. to
E.L. MANSON-CUMMINGS ADD.
20'-7" Conc. & Int. Curb
B.E. SMITH CITY ENGINEER
CITY OF WICHITA, KANSAS
Date: Oct. 1968
Project No. C18-1

12-Engr
11-Inde