E-2

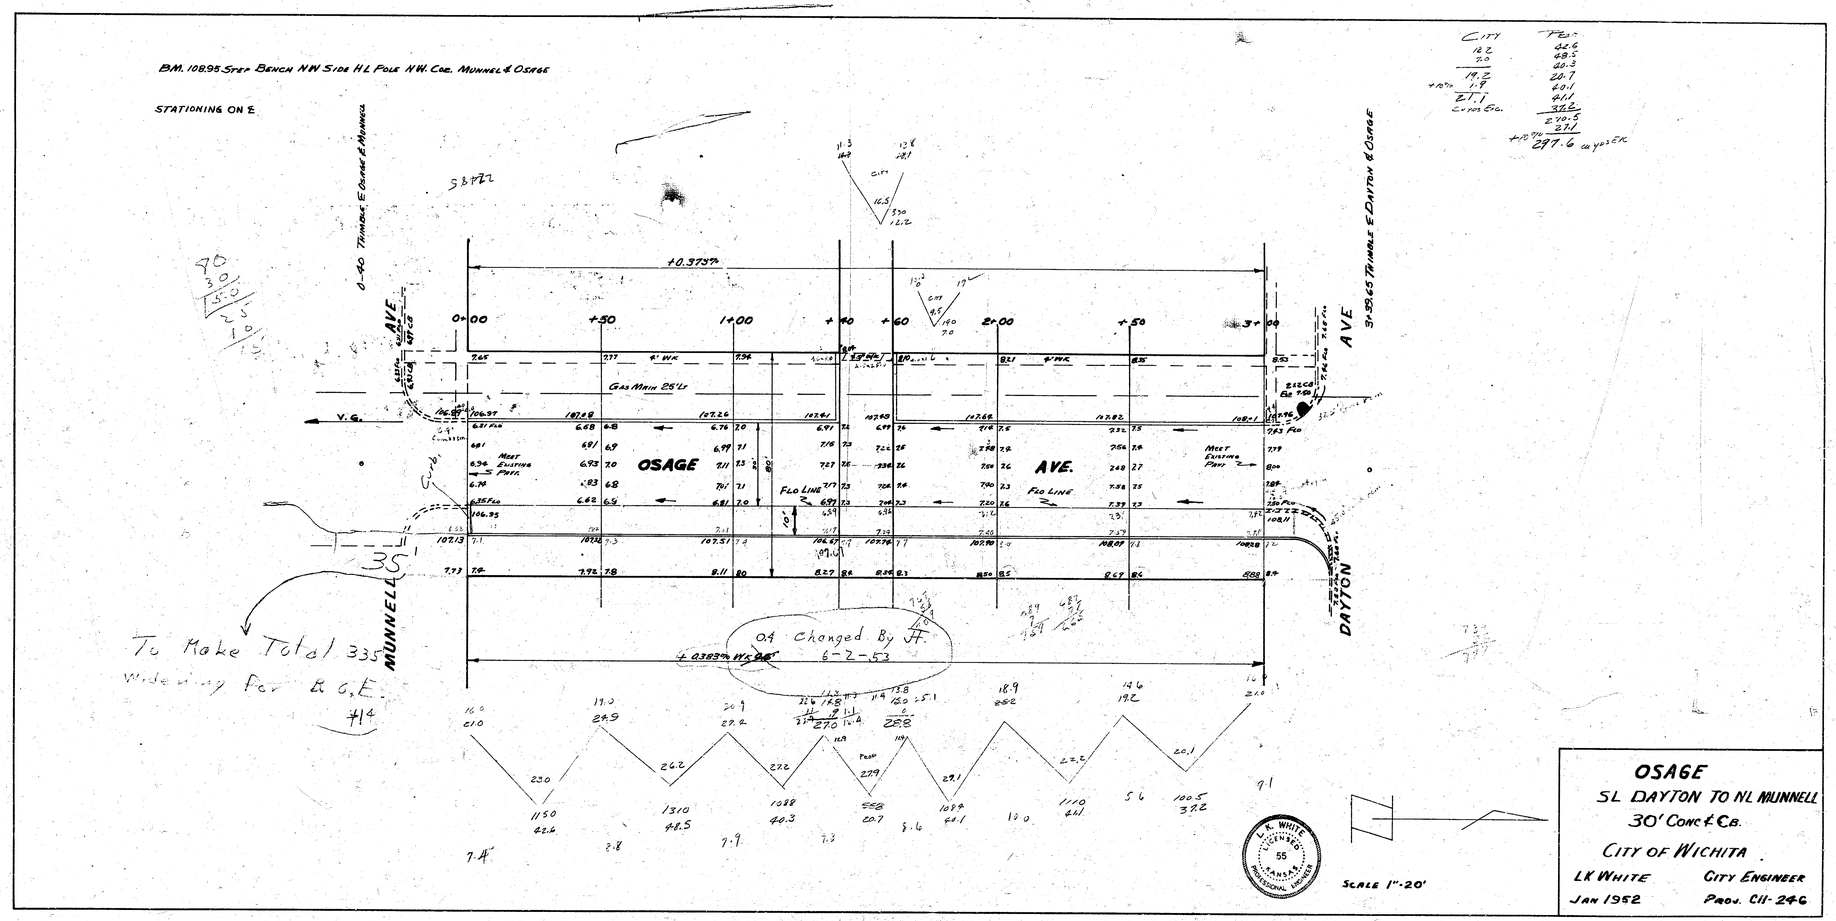

OSAGE

SL DAYTON TO NL MUNNELL

30' Conc & C.B.

CITY OF WICHITA

LK WHITE — CITY ENGINEER

JAN 1952 — PROJ. CII-246