
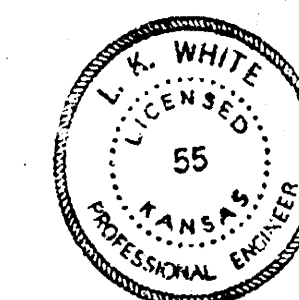


S-8

B.M. 100.76 G in GULCH S. End E. COR. ESTELLE & N. FUNSTON
B.M. 112.18 S.E. COR. CONC. POND. N. 1/2 1675 S. ESTELLE
B.M. 111.45 "M" in MUELLER TOP HYD. S.W. COR. GREEN & OSIE

SPANNING ON E

CITY	PROPERTY
2.3	22.2
1.9	27.3
9.5	25.5
13.7	37.0
+10.70	1.4
15.1	147.5
20.0	19.8
5.1	217.3
	CU YDS
	EXC.

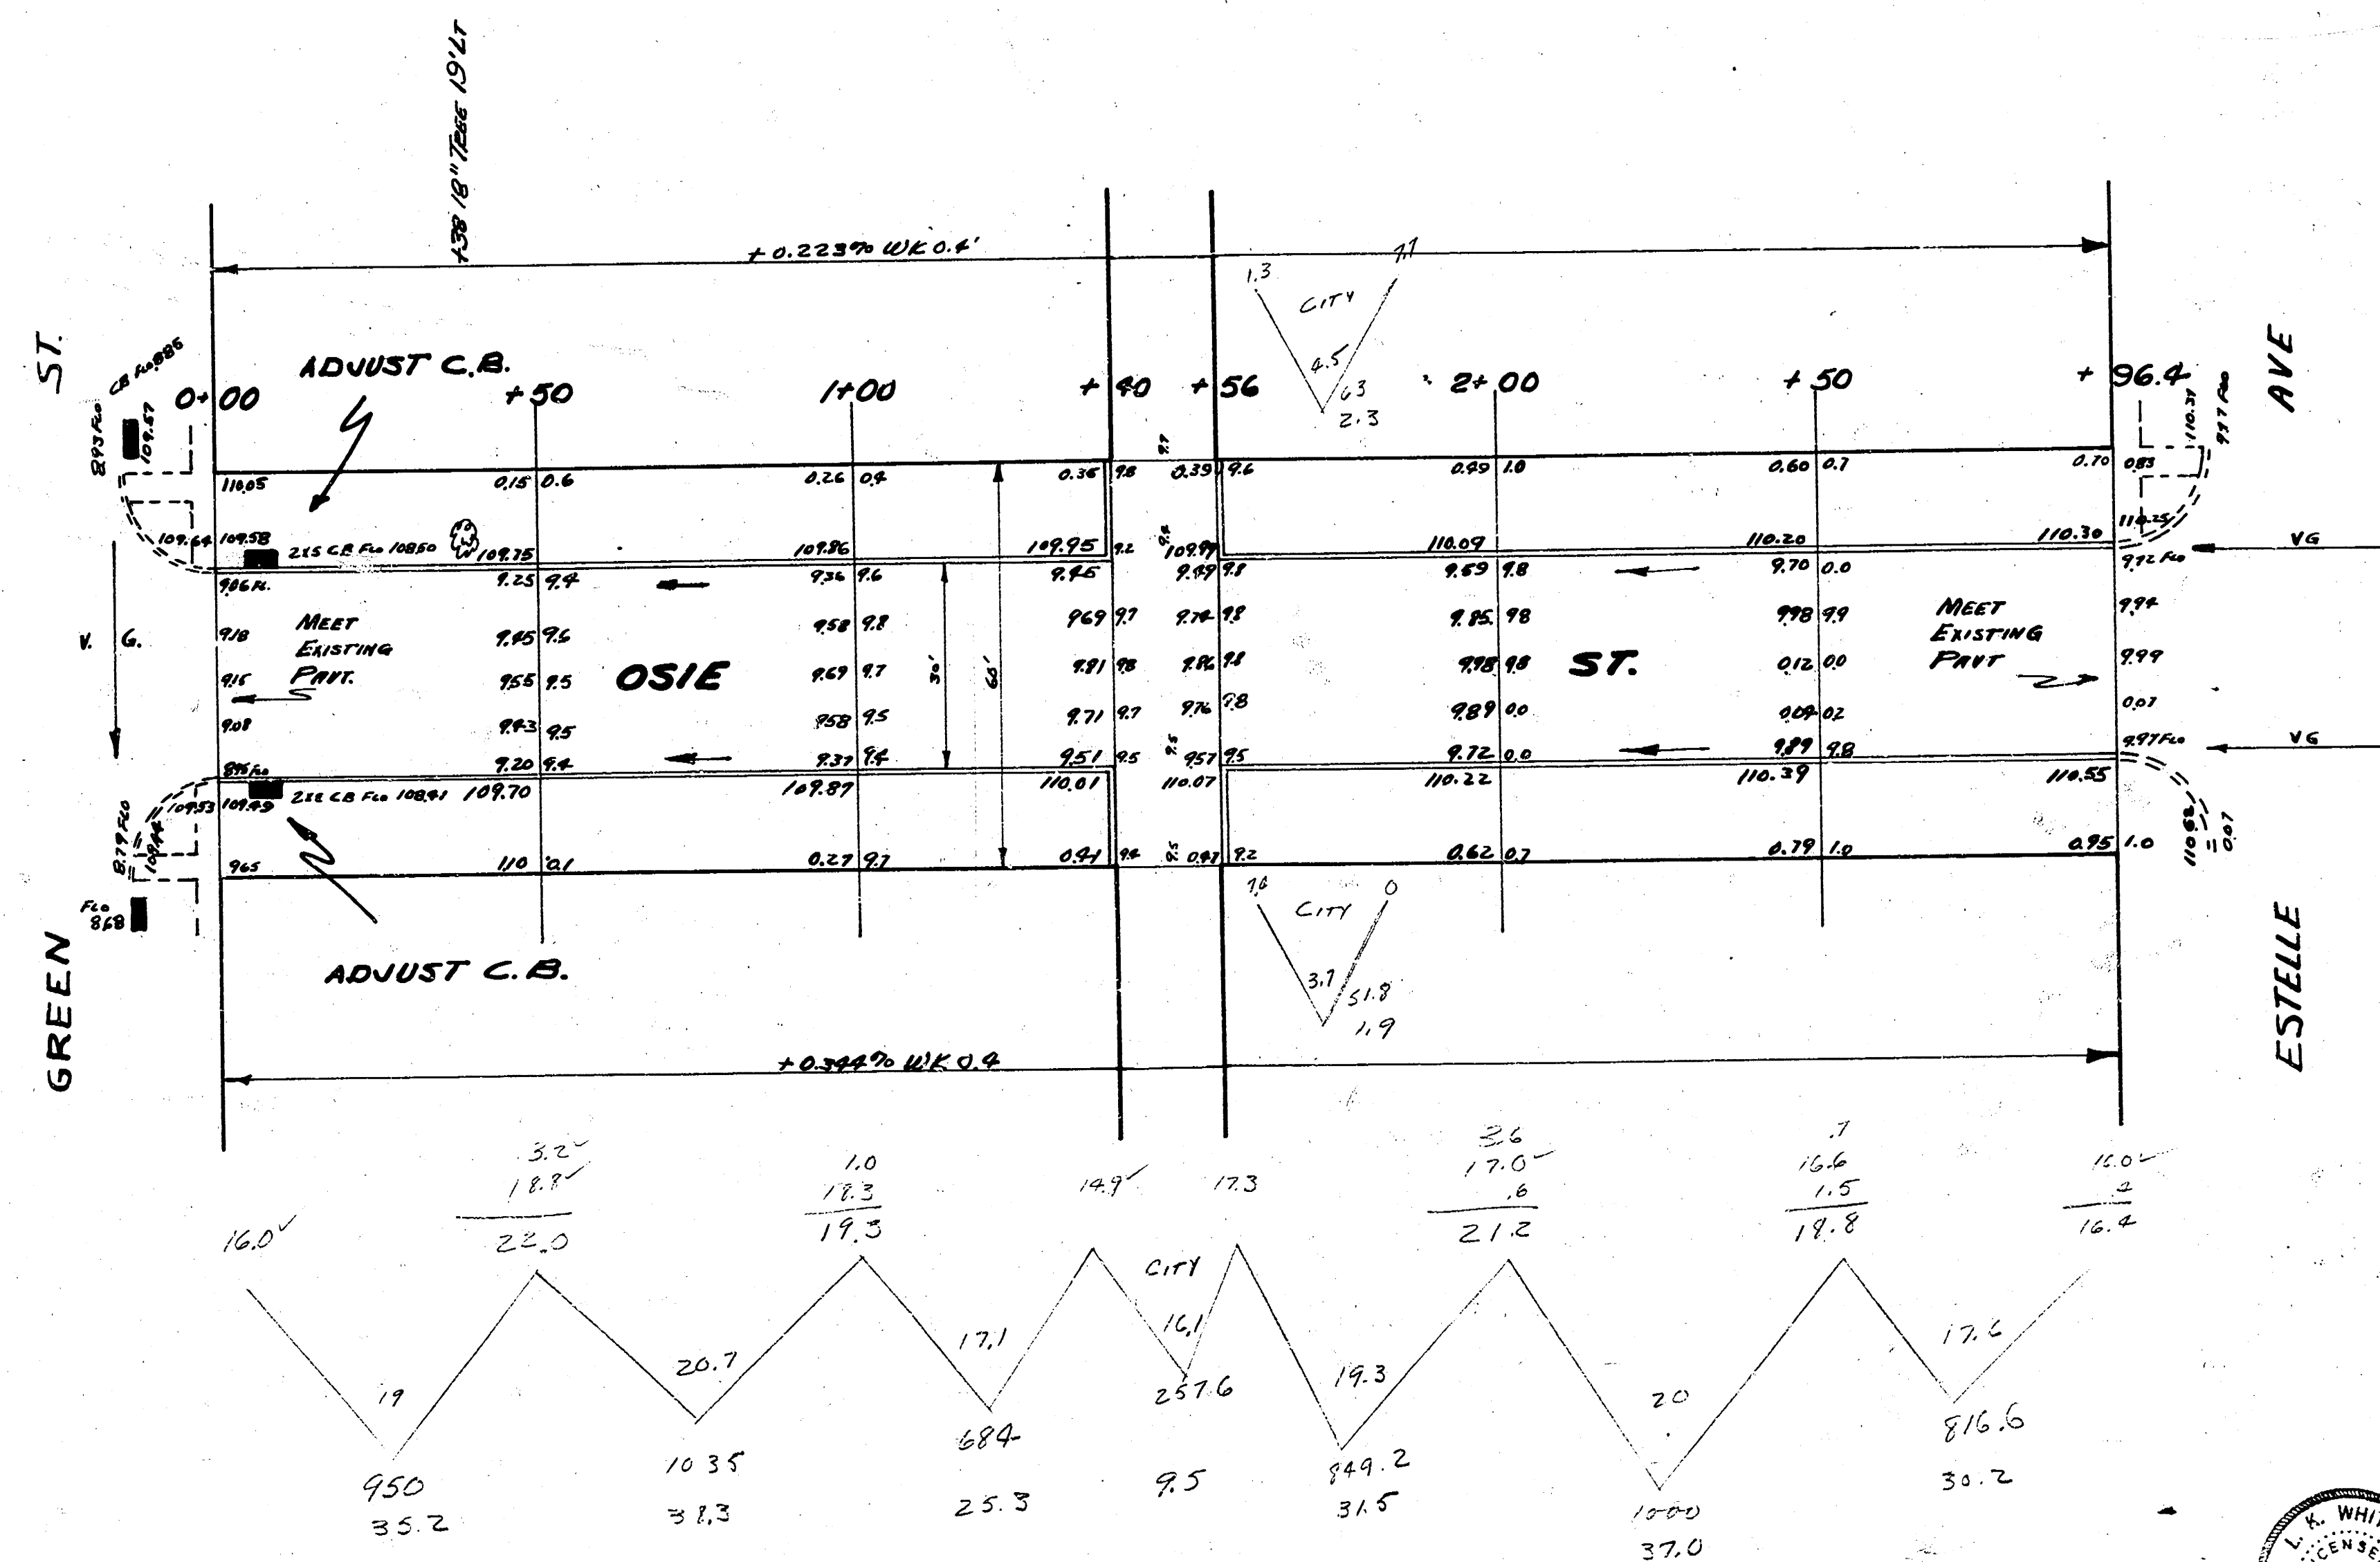


SCALE 1"=20'

OSIE
EL GREEN TO WL ESTELLE
30' CONC. & C.B.
CITY OF WICHITA
LK WHITE CITY ENGINEER
JAN 1952 PROJ. C11-244

X-SECTION 55 5-12-52 Plan, Green, Estelle, D.S. 6/1952


B.M. 102.41 S.E. COR. LOWER CONC. STEP 40.4' 1/4 SEC. 16.57 N.W. COR. GROVE & OSIE

Grand Totals
 Prop 807.2
 872.4
 1679.6 cu yds.
 City 421.0
 325.6
 746.6 cu yds.

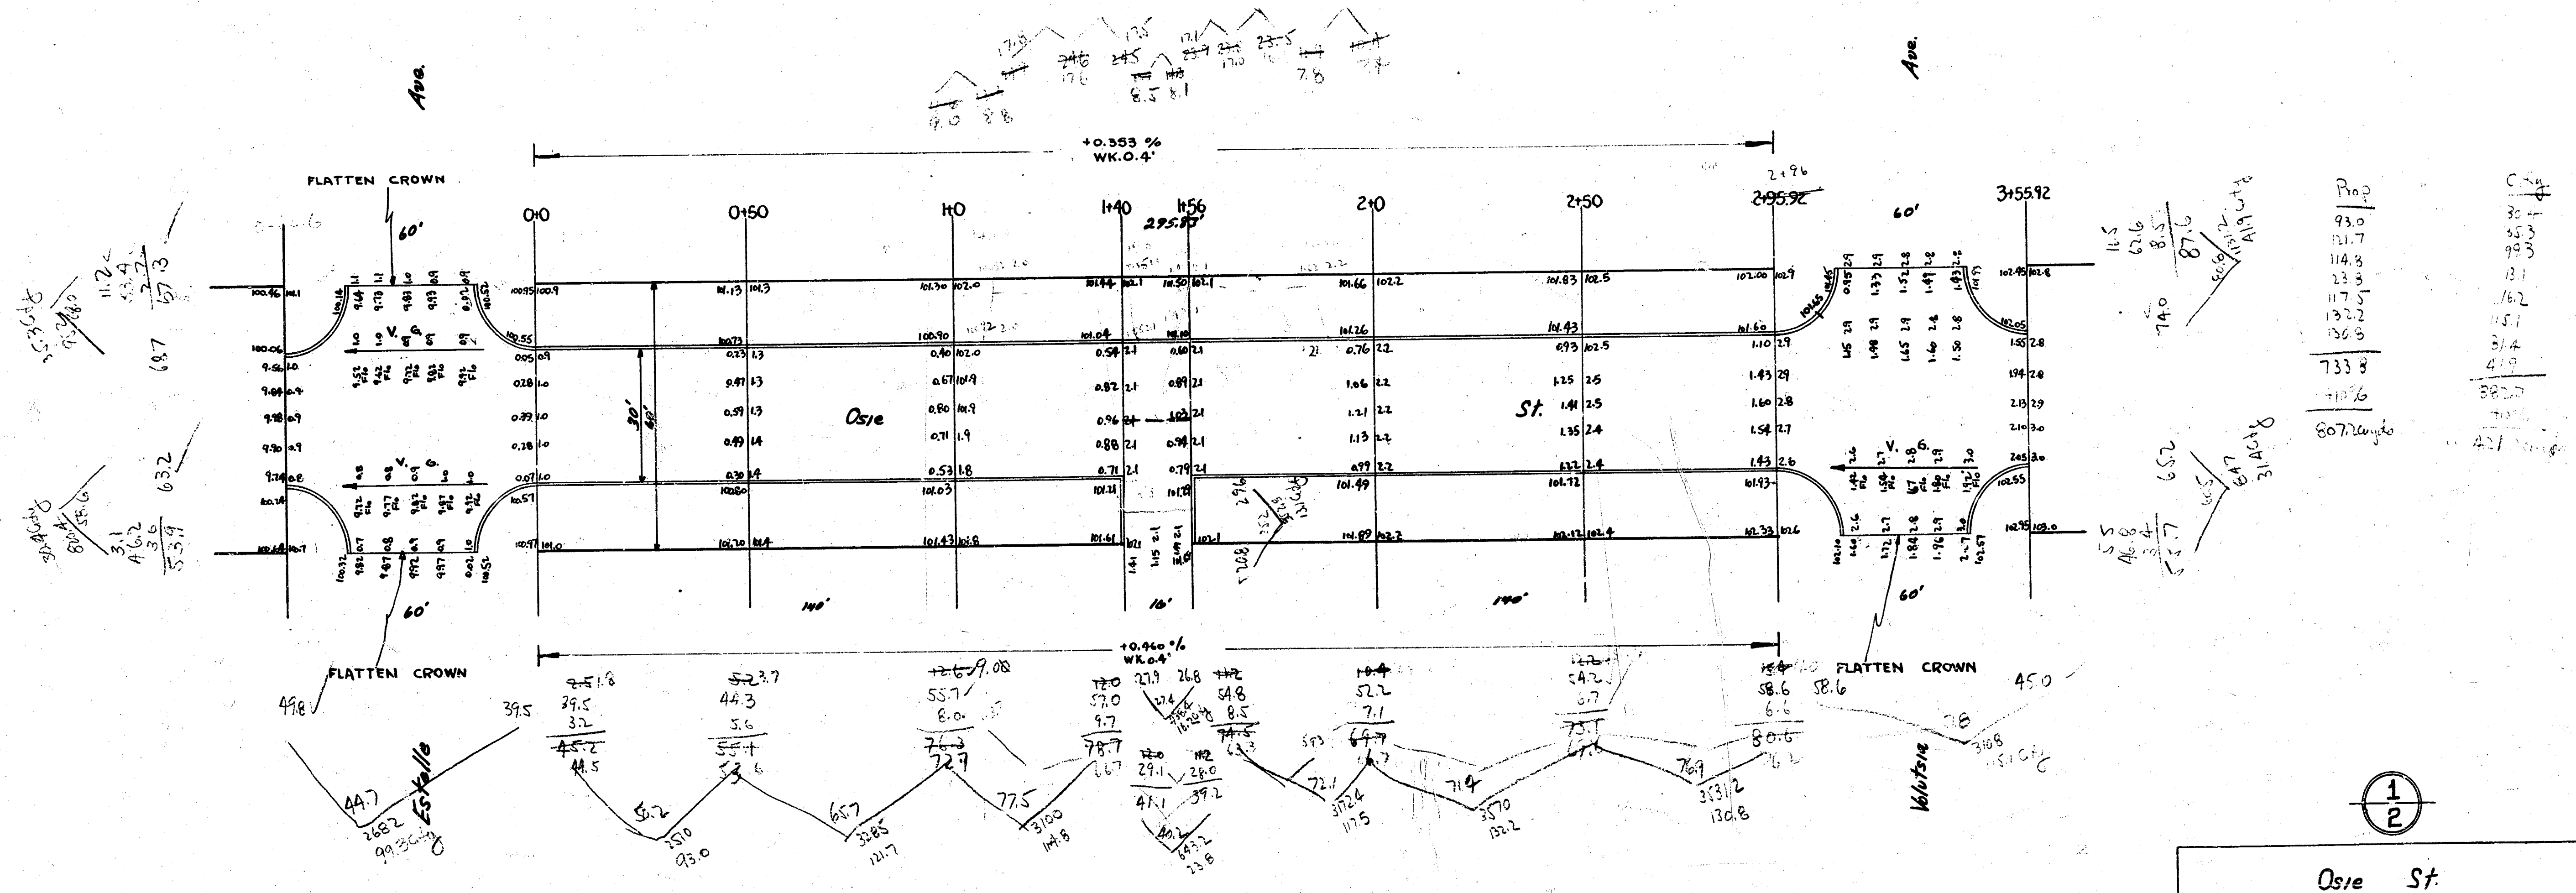



Prop	City
807.2	421.0
872.4	325.6
1679.6	746.6

Osie St.
 W. Estelle — E. L. Erre
 30' Conc. & Cb.
 City of Wichita, Kansas
 L. H. White City Engineer
 July 1949 Project C17-124

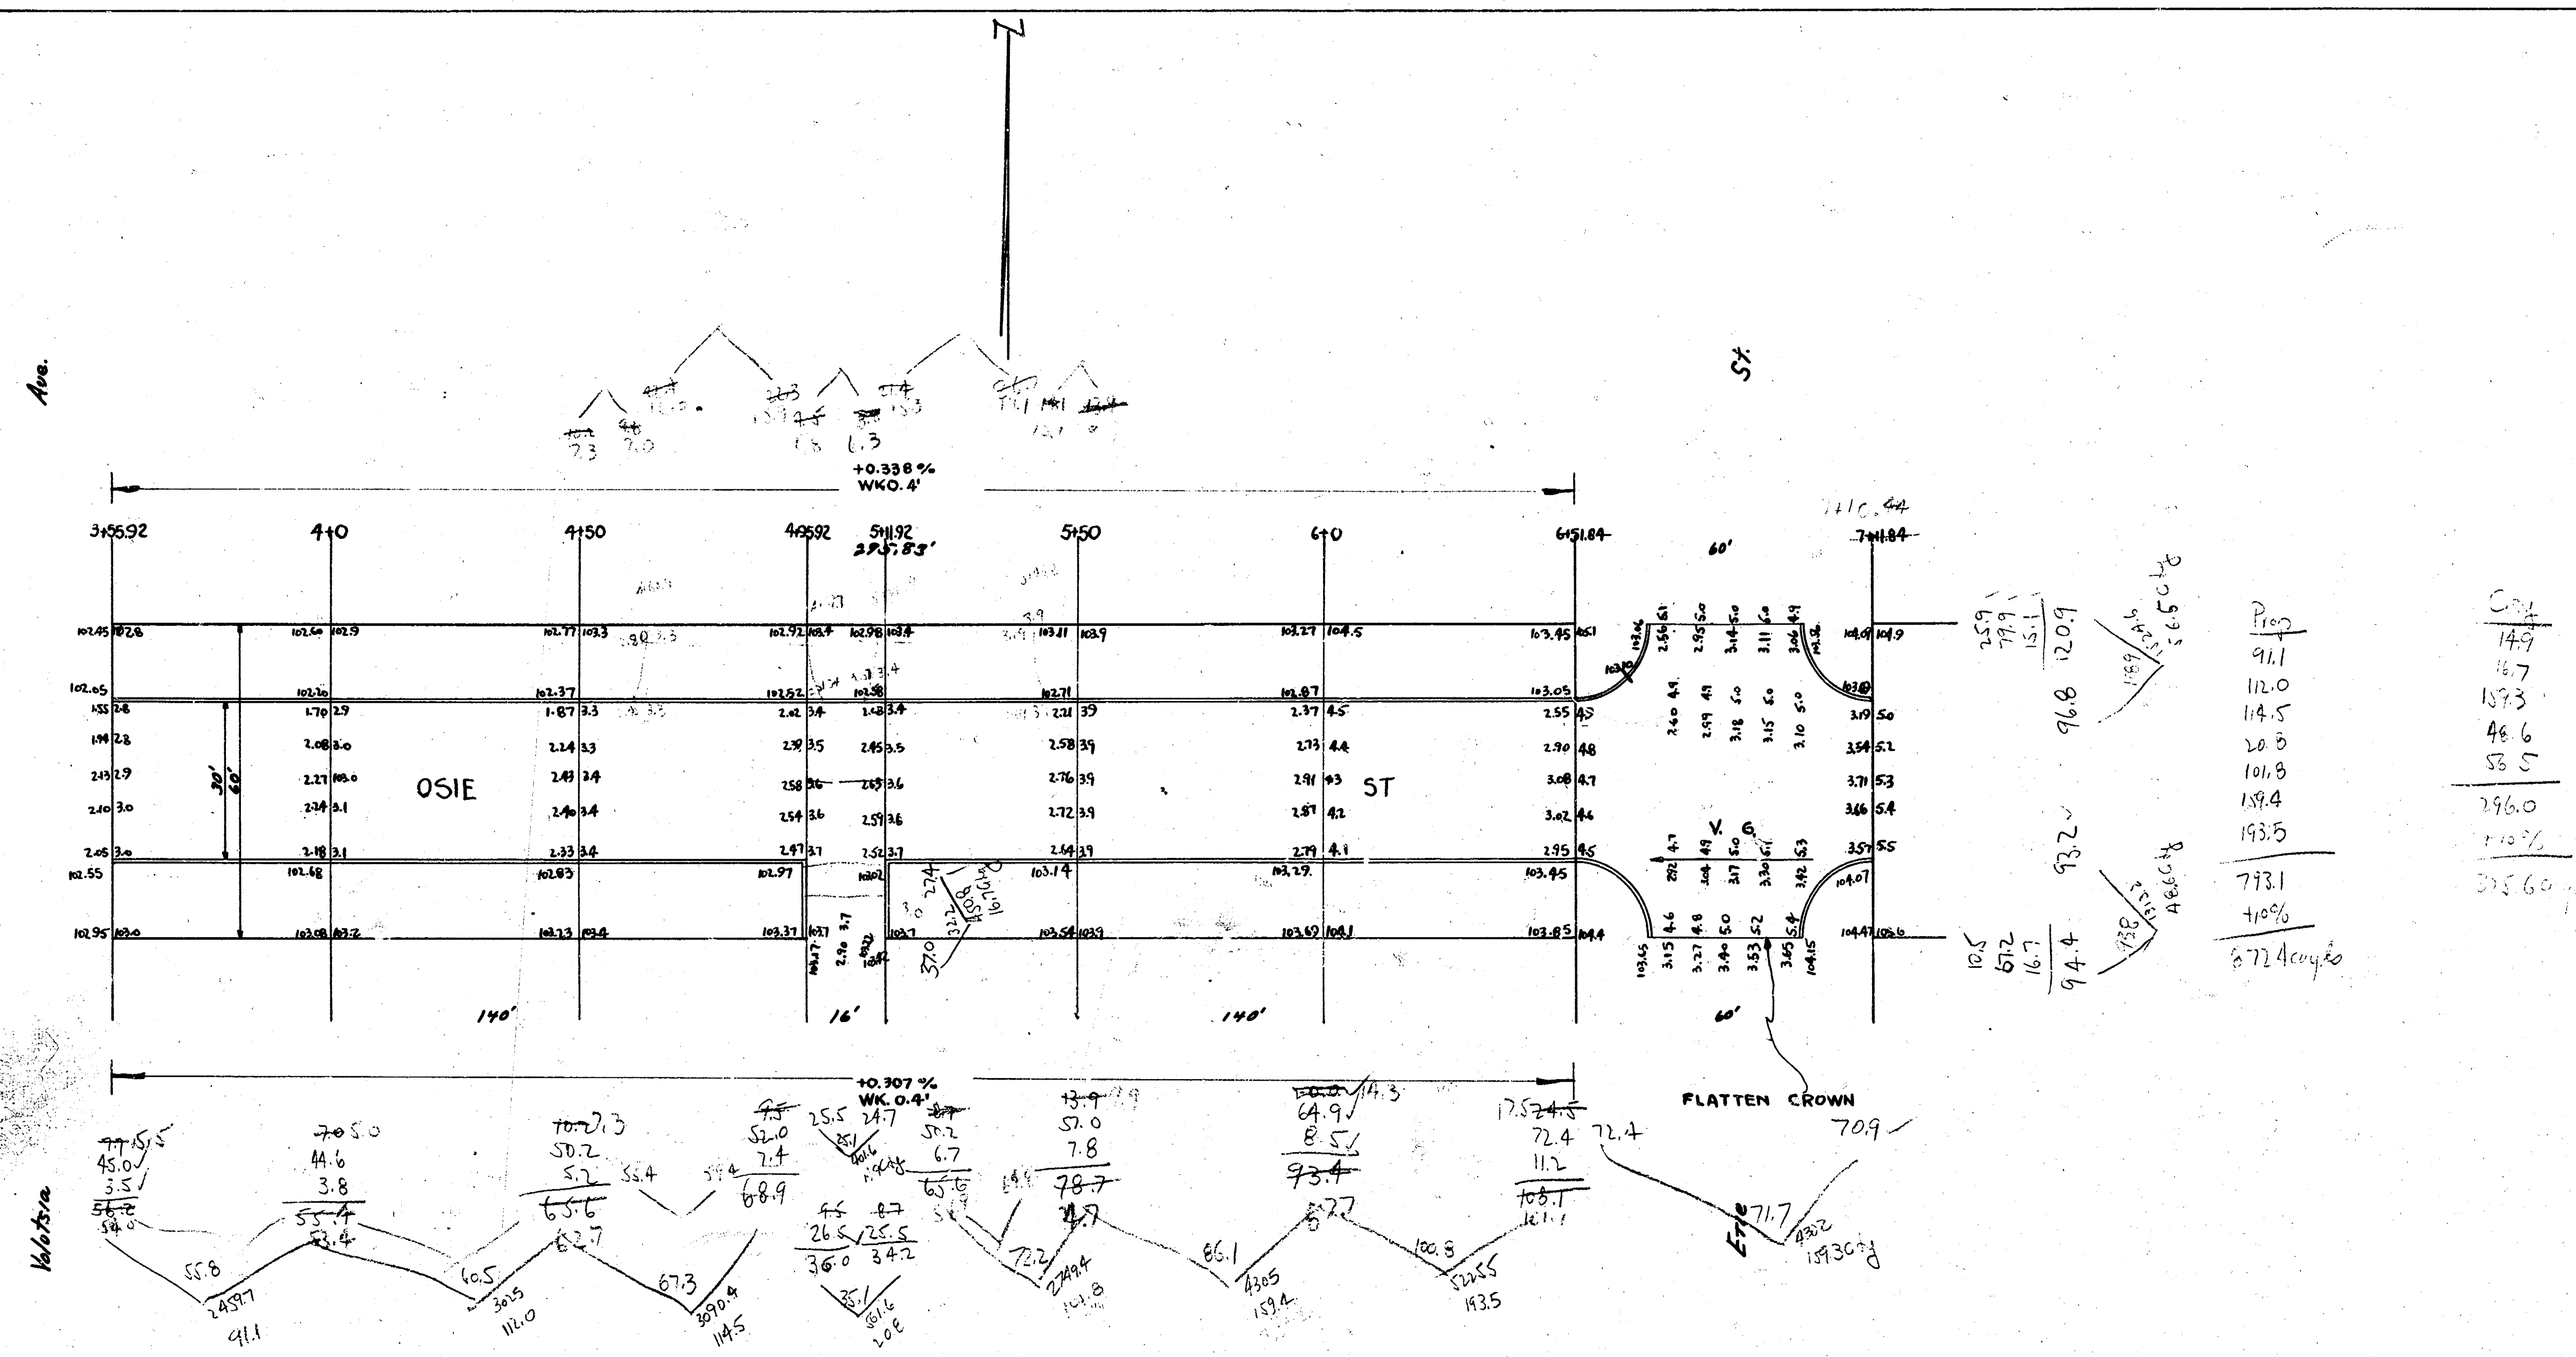

B.M. 100.53 'X' E. End Rd. SE Cor. Estelle & Harry
 B.M. 101.25 'X' Top Ch. SS. Harry — 8' W. of W.L. Fire S.

Prop.	City
47.2	19.1
50.5	36.9
62.9	12.4
63.5	27.7
67.8	35.0
64.8	30.8
50.5	-191.4
57.2	+107.0
60.9	
71.1	
87.4	
79.17	
+107.0	
818.9	cu. yds.

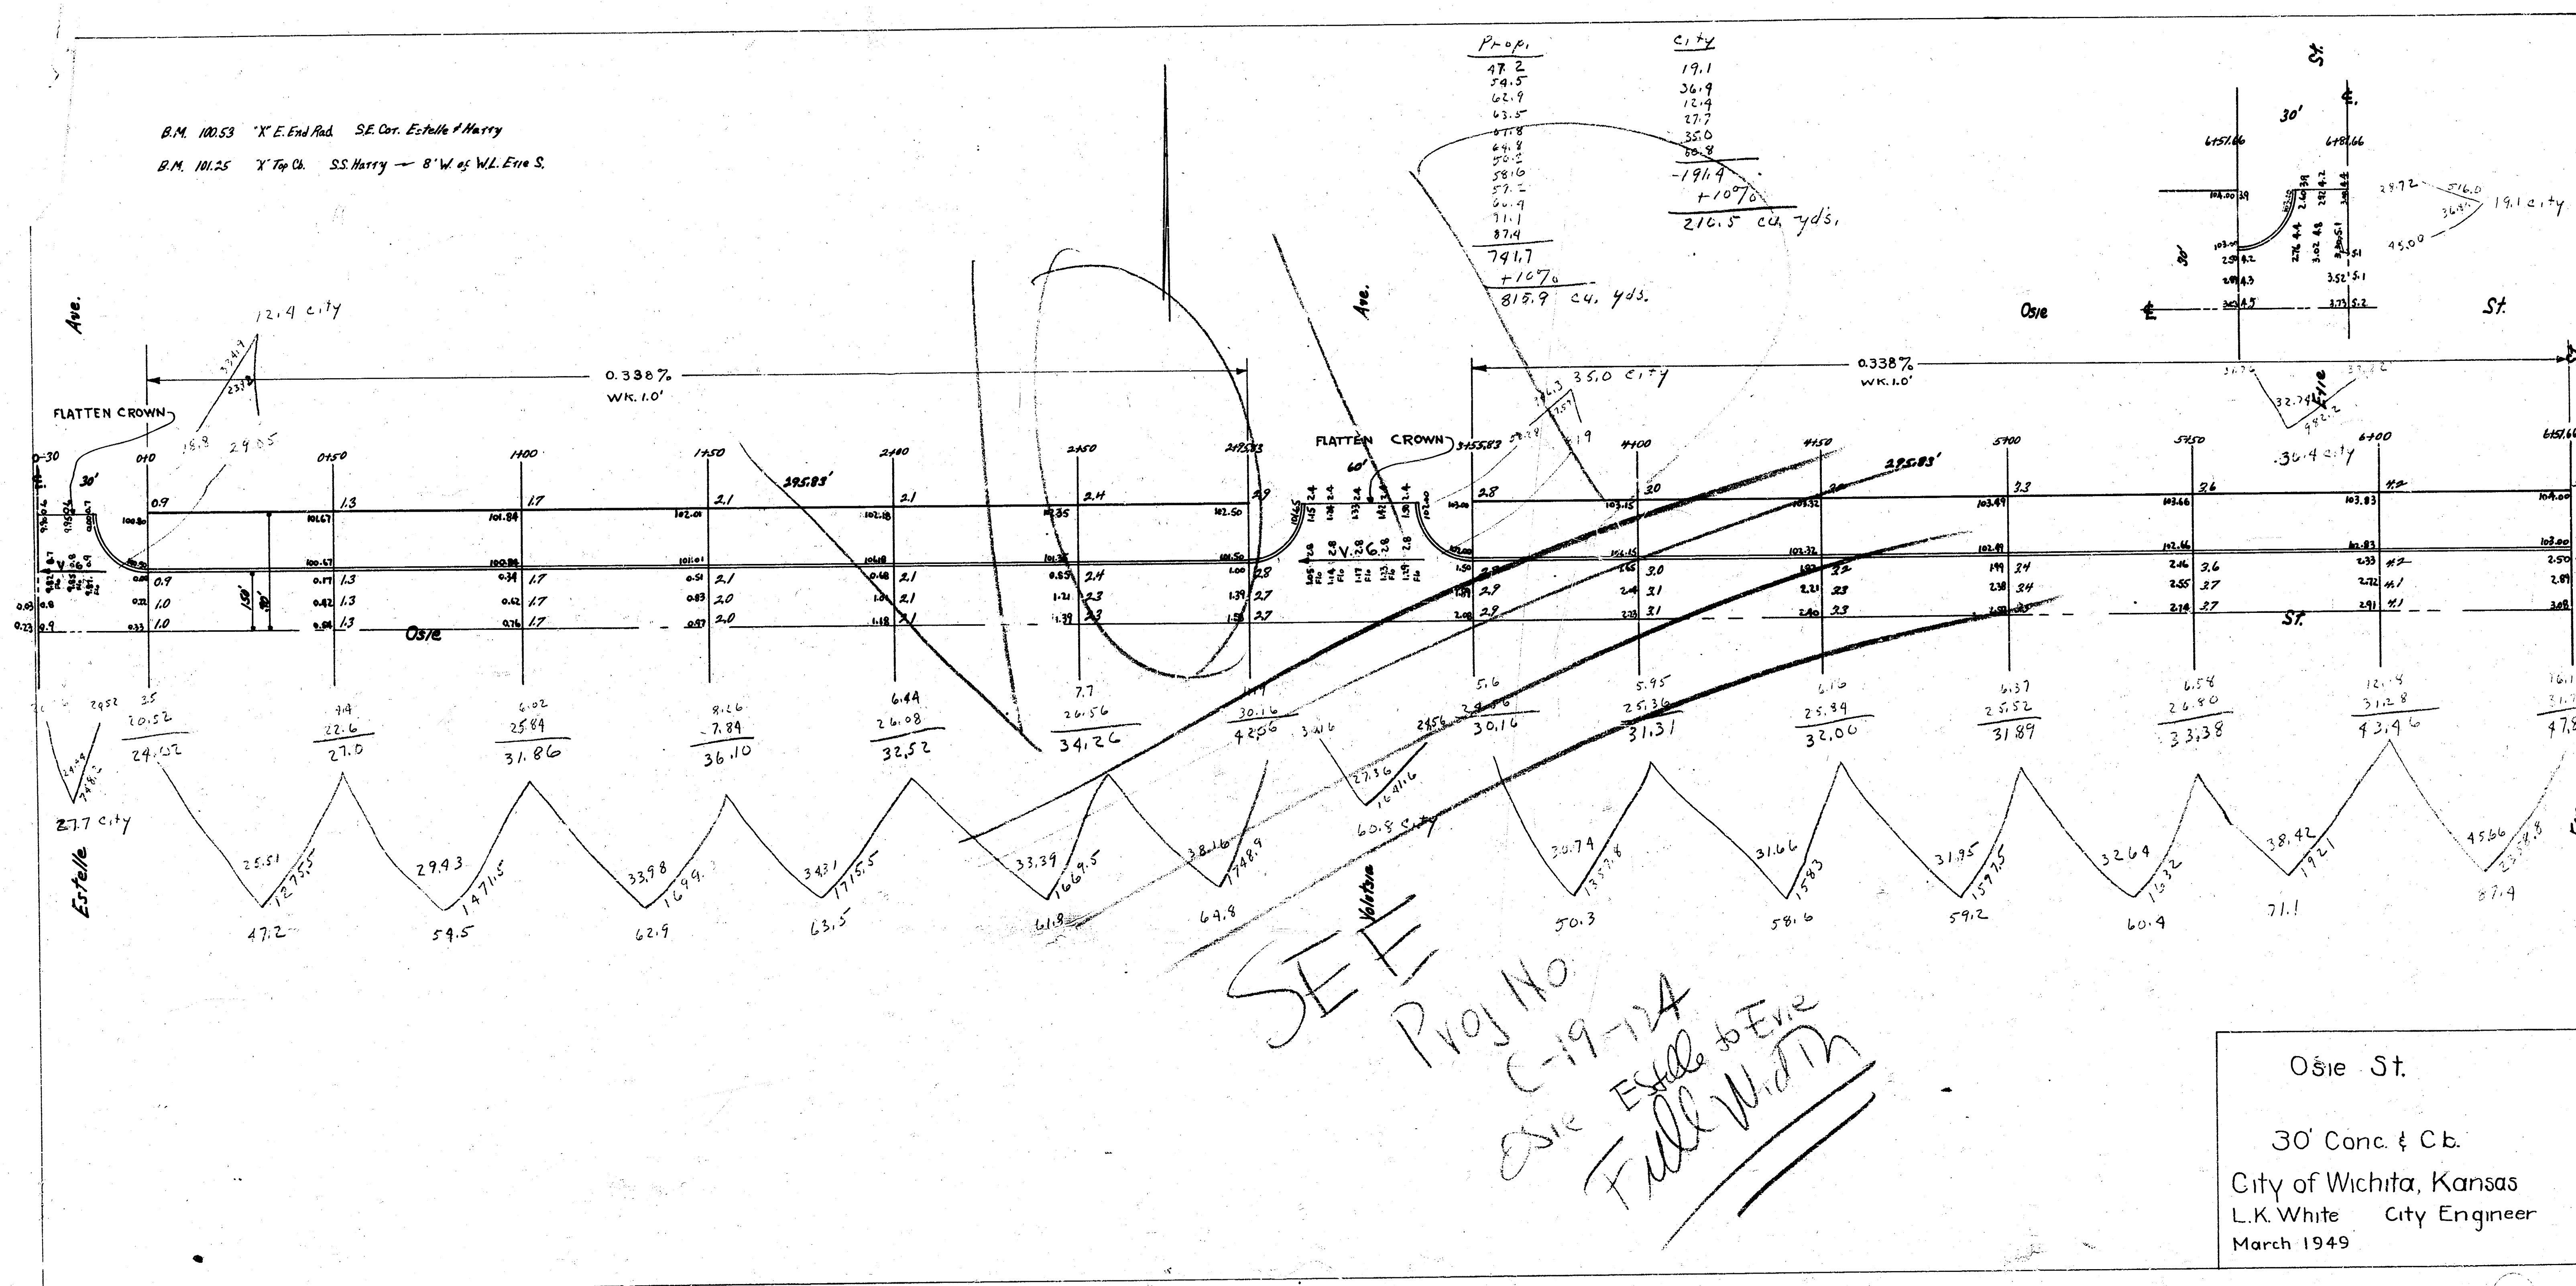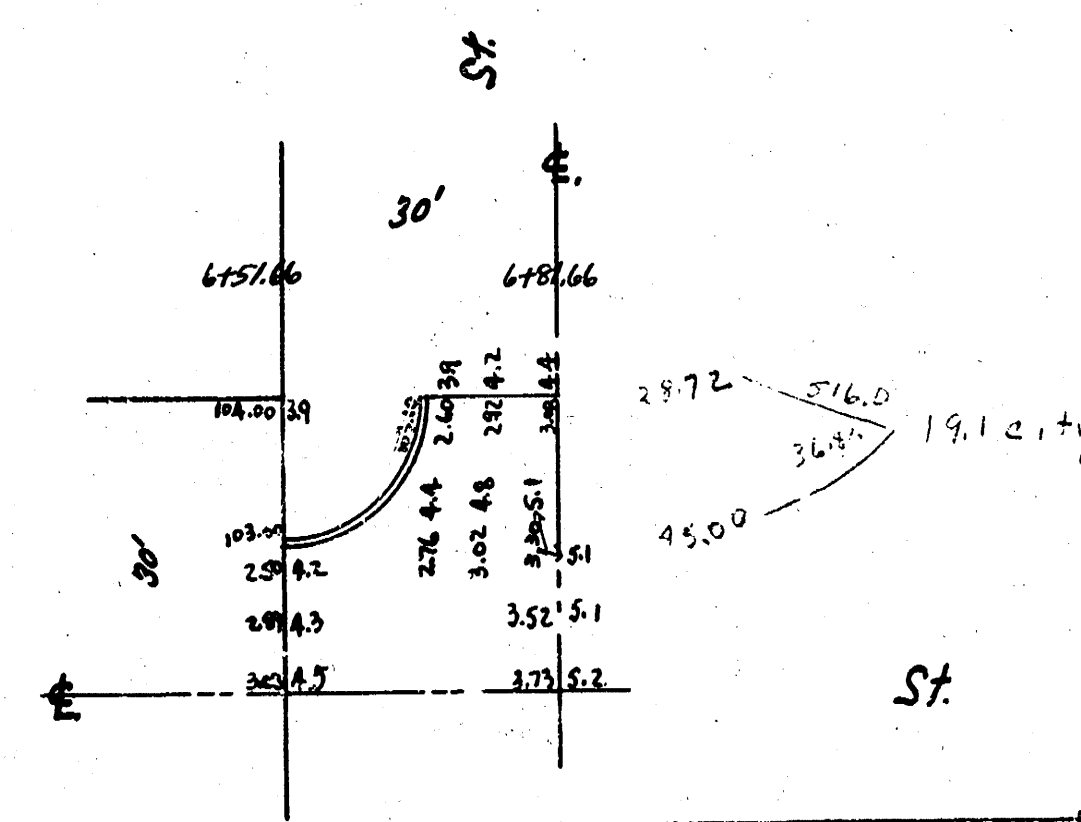

SEE
 Proj No
 C-19-124
 Esie Estelle & Fire
 Full Width

Osie St.
 30' Conc. & C.C.
 City of Wichita, Kansas
 L.K. White City Engineer
 March 1949