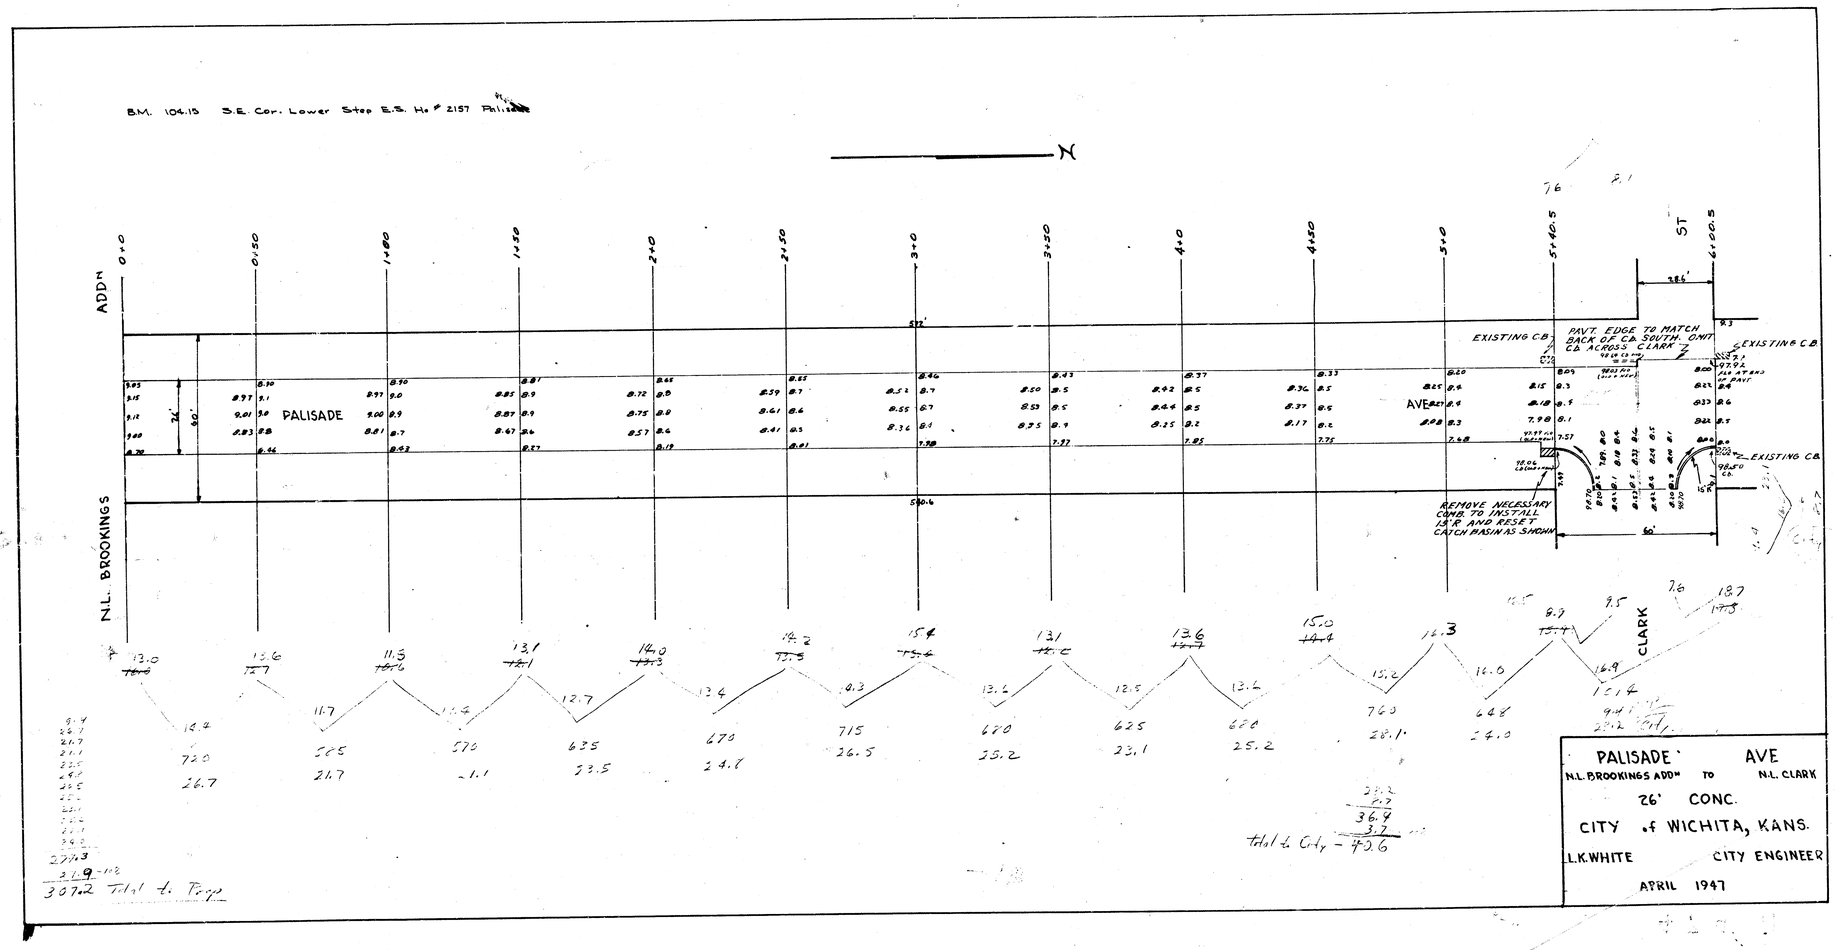
B.M. 104.15 S.E. Cor. Lower Step E.S. Hº # 2157 Palisade
N
ADDN
N.L. BROOKINGS
0+0
0+50
1+00
1+50
2+00
2+50
3+0
3+50
4+0
4+50
5+0
5+40.5
6+00.5
PALISADE
AVE
ST
CLARK
EXISTING C.B.
PAVT. EDGE TO MATCH BACK OF C.B. SOUTH. UNIT C.B. ACROSS CLARK
REMOVE NECESSARY COMB. TO INSTALL I.R. AND RESET CATCH BASIN AS SHOWN
572'
560.6
26'
60'
50'
Total L. City - 45.6
Total L. Pipe
PALISADE AVE
N.L. BROOKINGS ADDN TO N.L. CLARK
26' CONC.
CITY of WICHITA, KANS.
L.K. WHITE CITY ENGINEER
APRIL 1947