


PARKWOOD LANE N.L. 2ND to S.L. 3RD 26' CONC.

174' 6" H.E. 118.55 H.E. N.L. 2ND & N.L. 3RD 174'

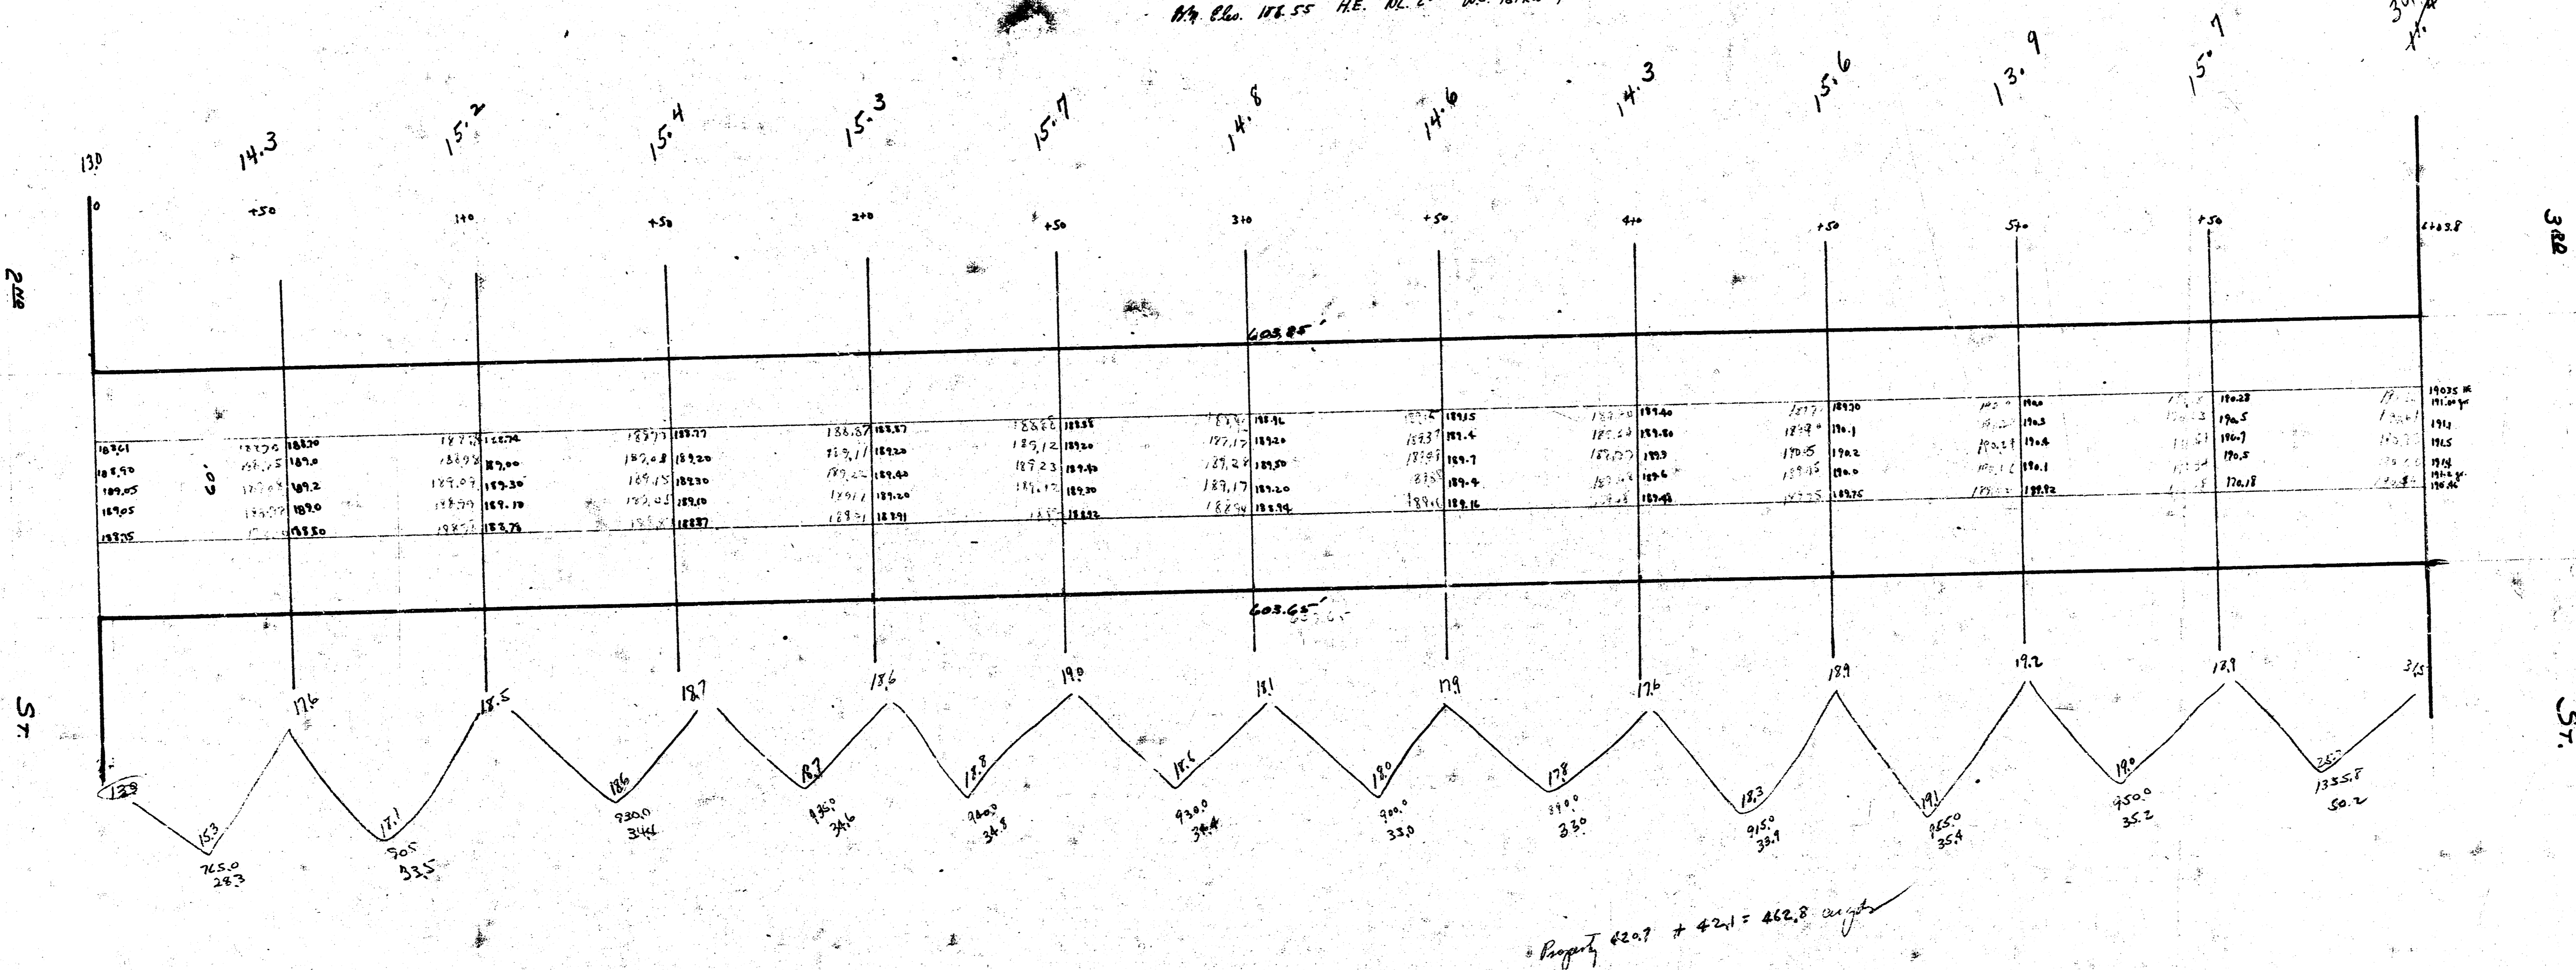

PARKWOOD LANE
N.L. 2ND
to
S.L. 3RD
1991