

$$\begin{array}{r} 8-043 \\ 1047 \\ 92.6 \\ 72.7 \\ 65.7 \\ 57.8 \\ 53.0 \\ 54.2 \\ 50.6 \\ 47.9 \\ 41.7 \\ 38.9 \\ 33.9 \\ \hline 706.3 \\ + 109.0 \\ \hline 776.9 \end{array}$$

Property


88.9
83.1
68.9
61.3
55.0
55.2
53.7
52.7
47.6
40.9
40.7
38.9

667.7
+ 107.0
774.7

7367 cu. yds.
with

costs

2.67
12.17
34.9
+ 107.0
377.8 cu. yds
w/ 11.9

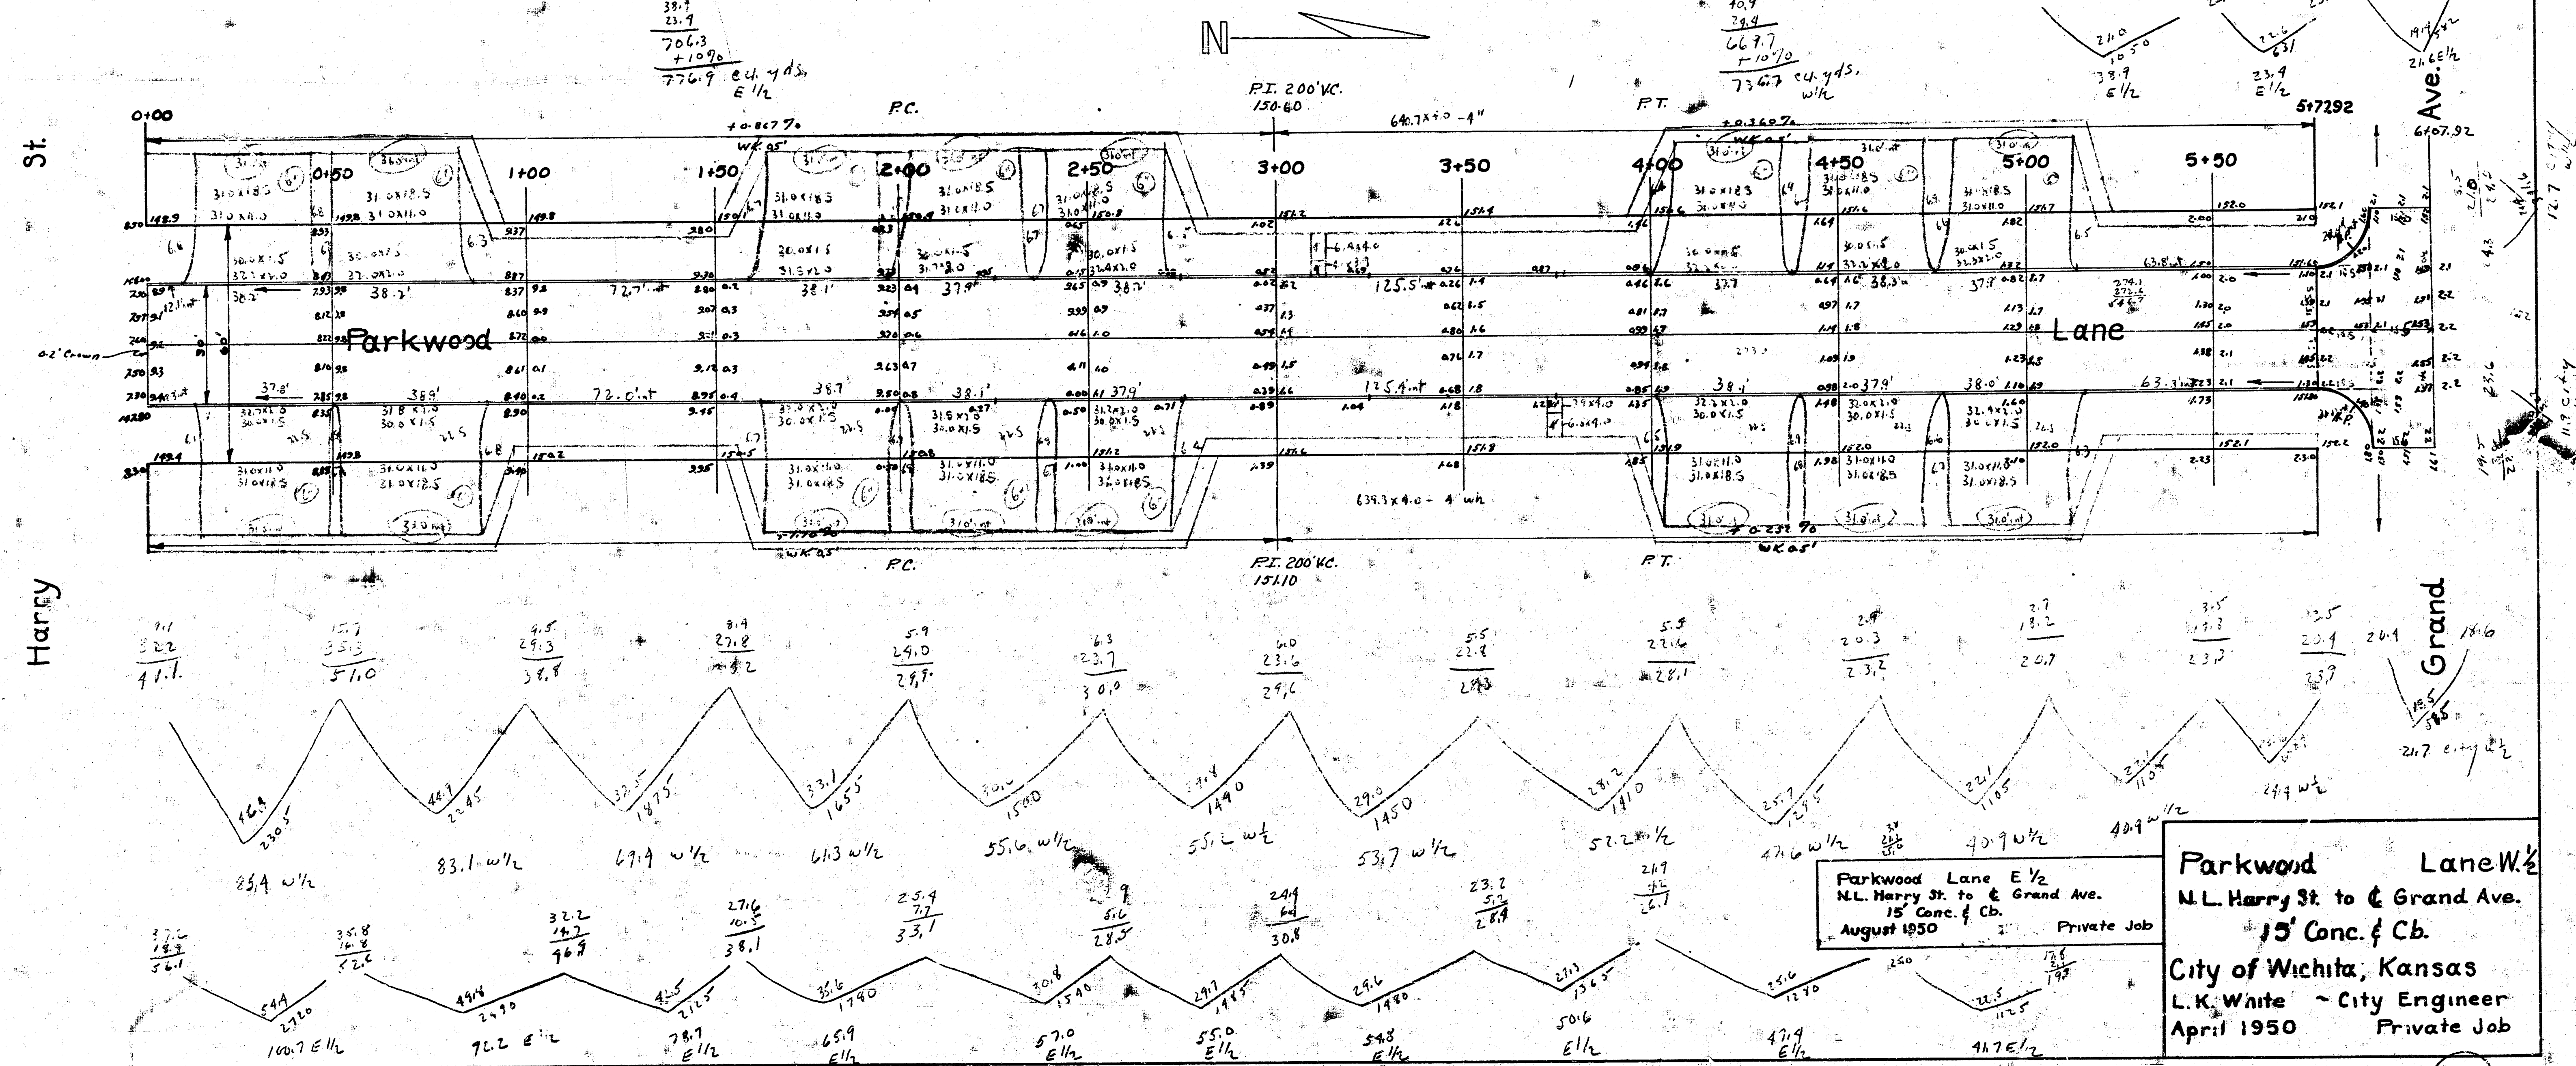

Parkwood Lane W. 1/2
N.L. Harry St. to E Grand Ave.
15' Conc. & Cb.
City of Wichita, Kansas
L.K. White - City Engineer
April 1950 Private Job