


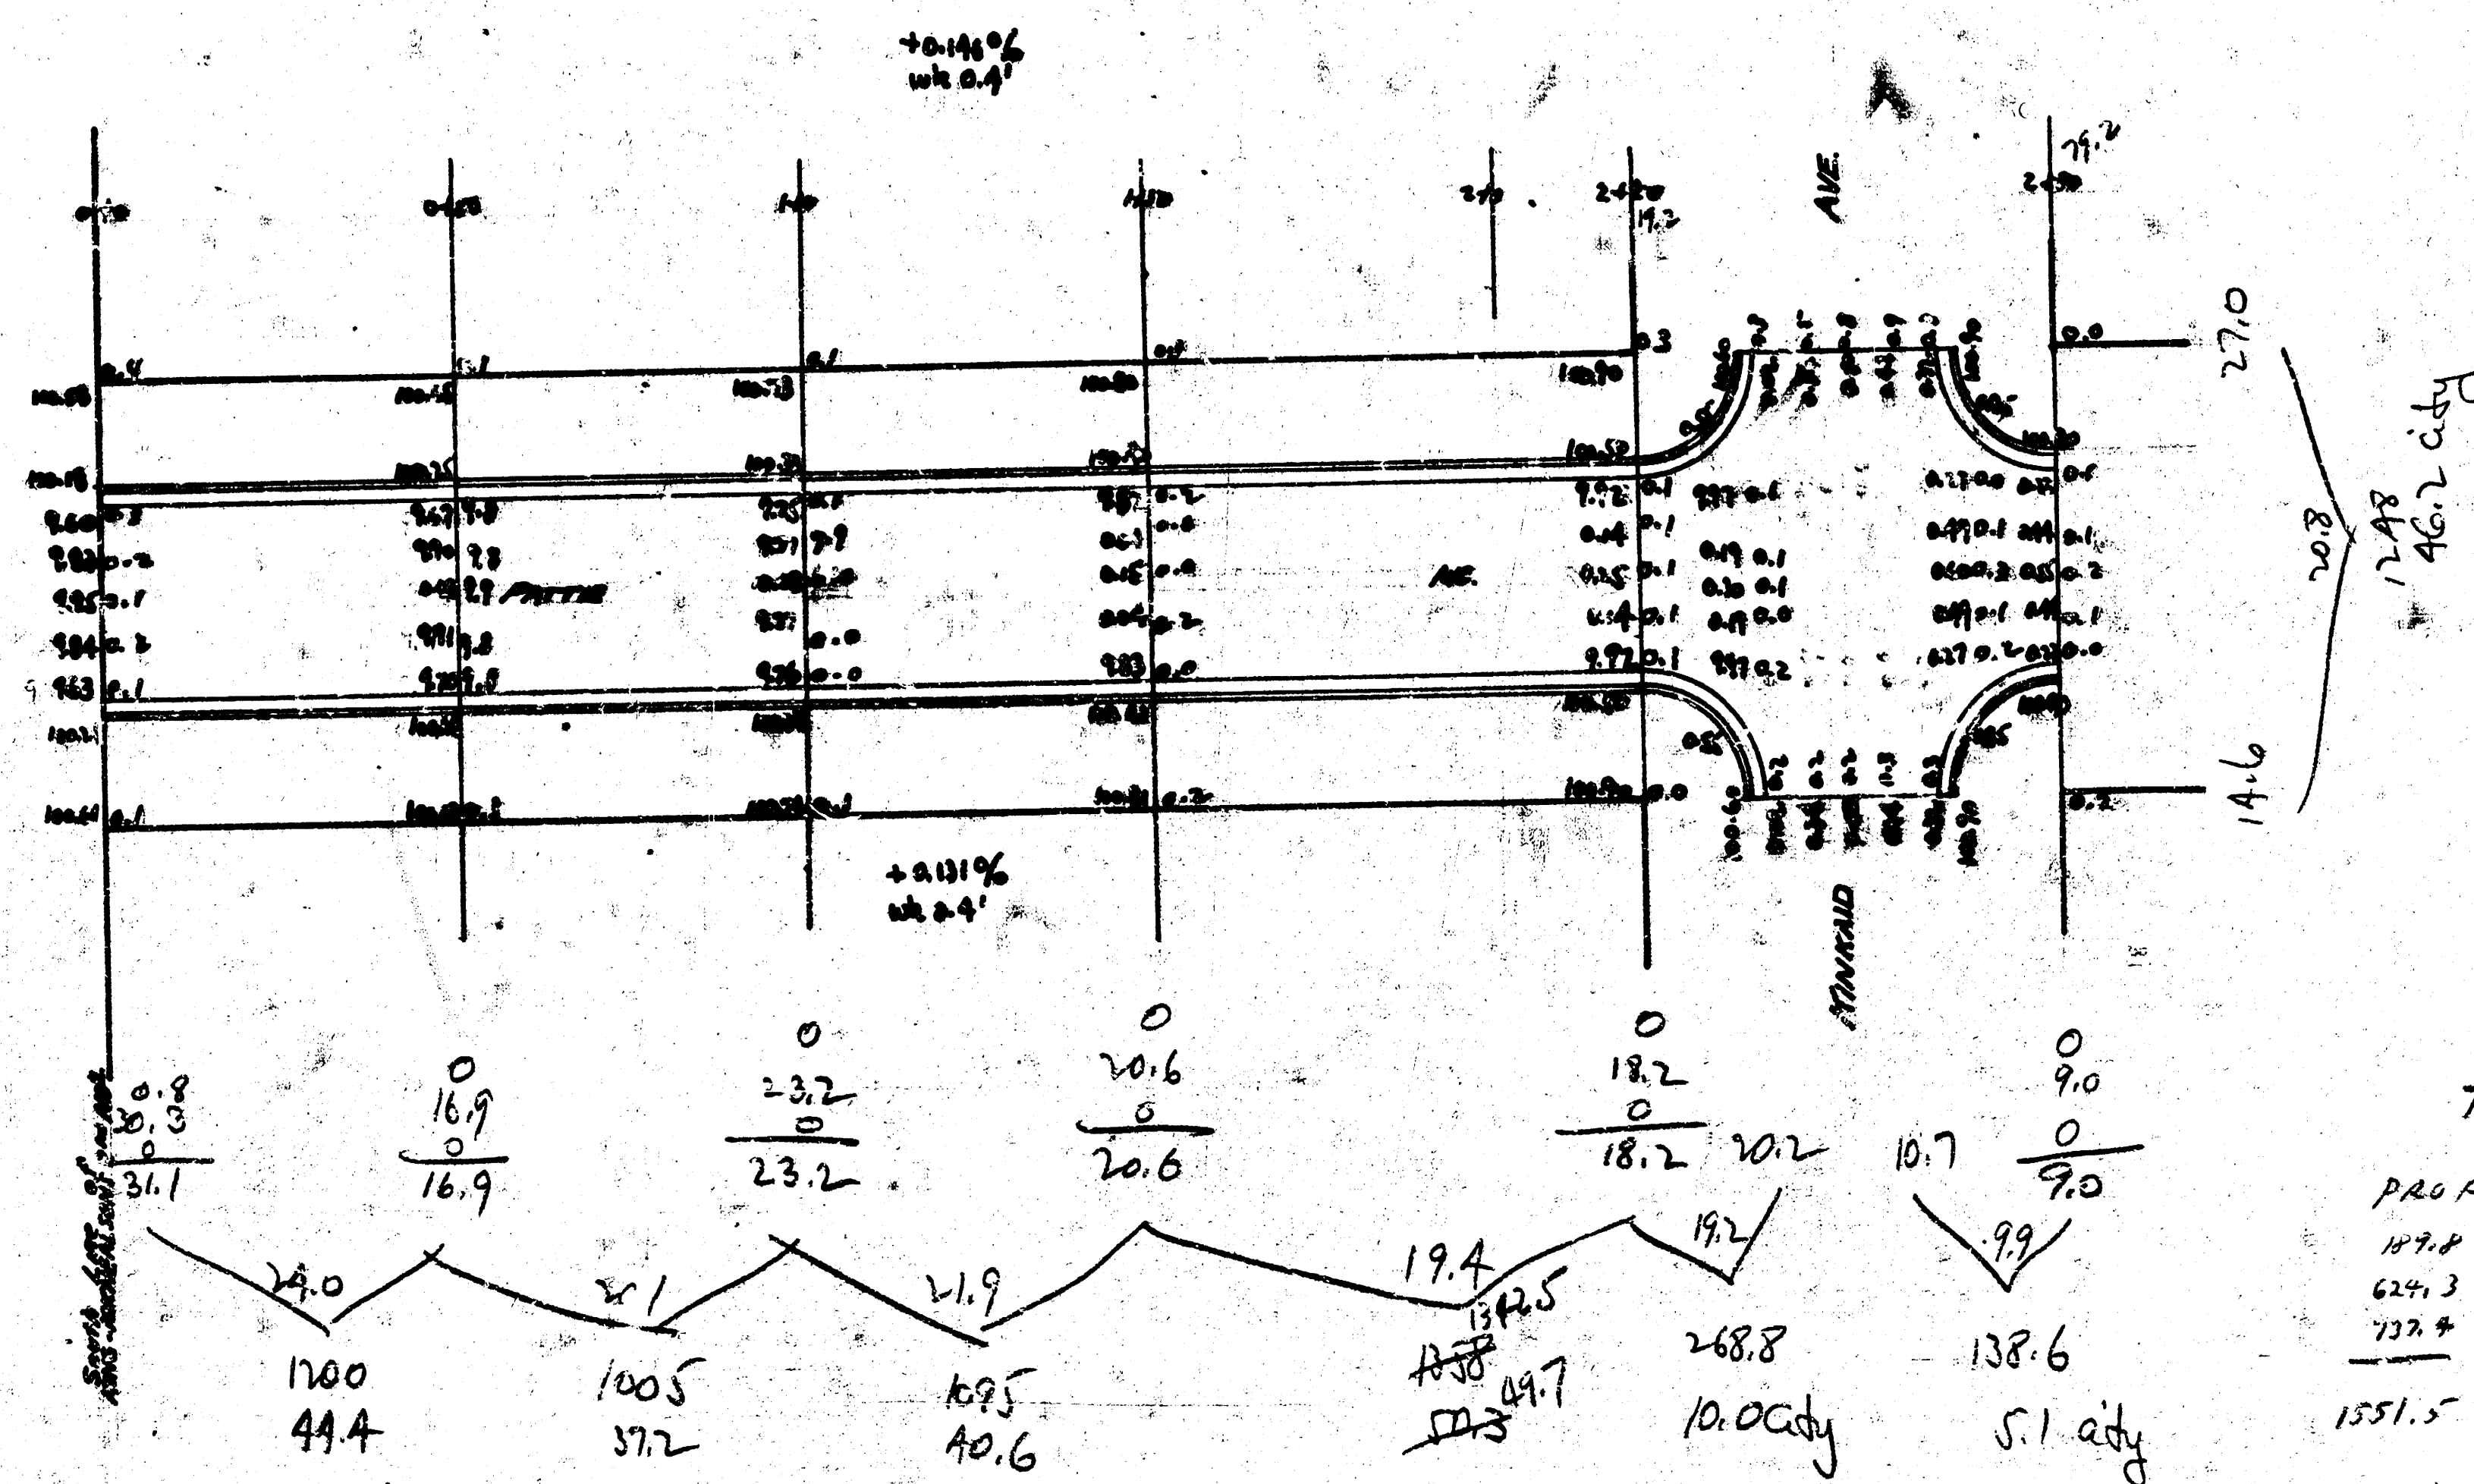

Prof Exam

44.4
37.2
40.6
50.3

172.5
+ 100%

189.8 w/ yds

City Exam

10.0
5.1
46.2
61.3
+10%
67.4 *undo*


TOTALS


PROP	CITY
187.8	67.4
624.3	284.0
732.4	
1551.5	351.4

8 June



PATTIE AVE
J.L. LEVY to J.L. KING/INTERCOM
26-2-30 2nd FLOOR
CITY OF WICHITA, KANSAS
Engineering Division
L.R. WHITE CITY E
JULY 1942

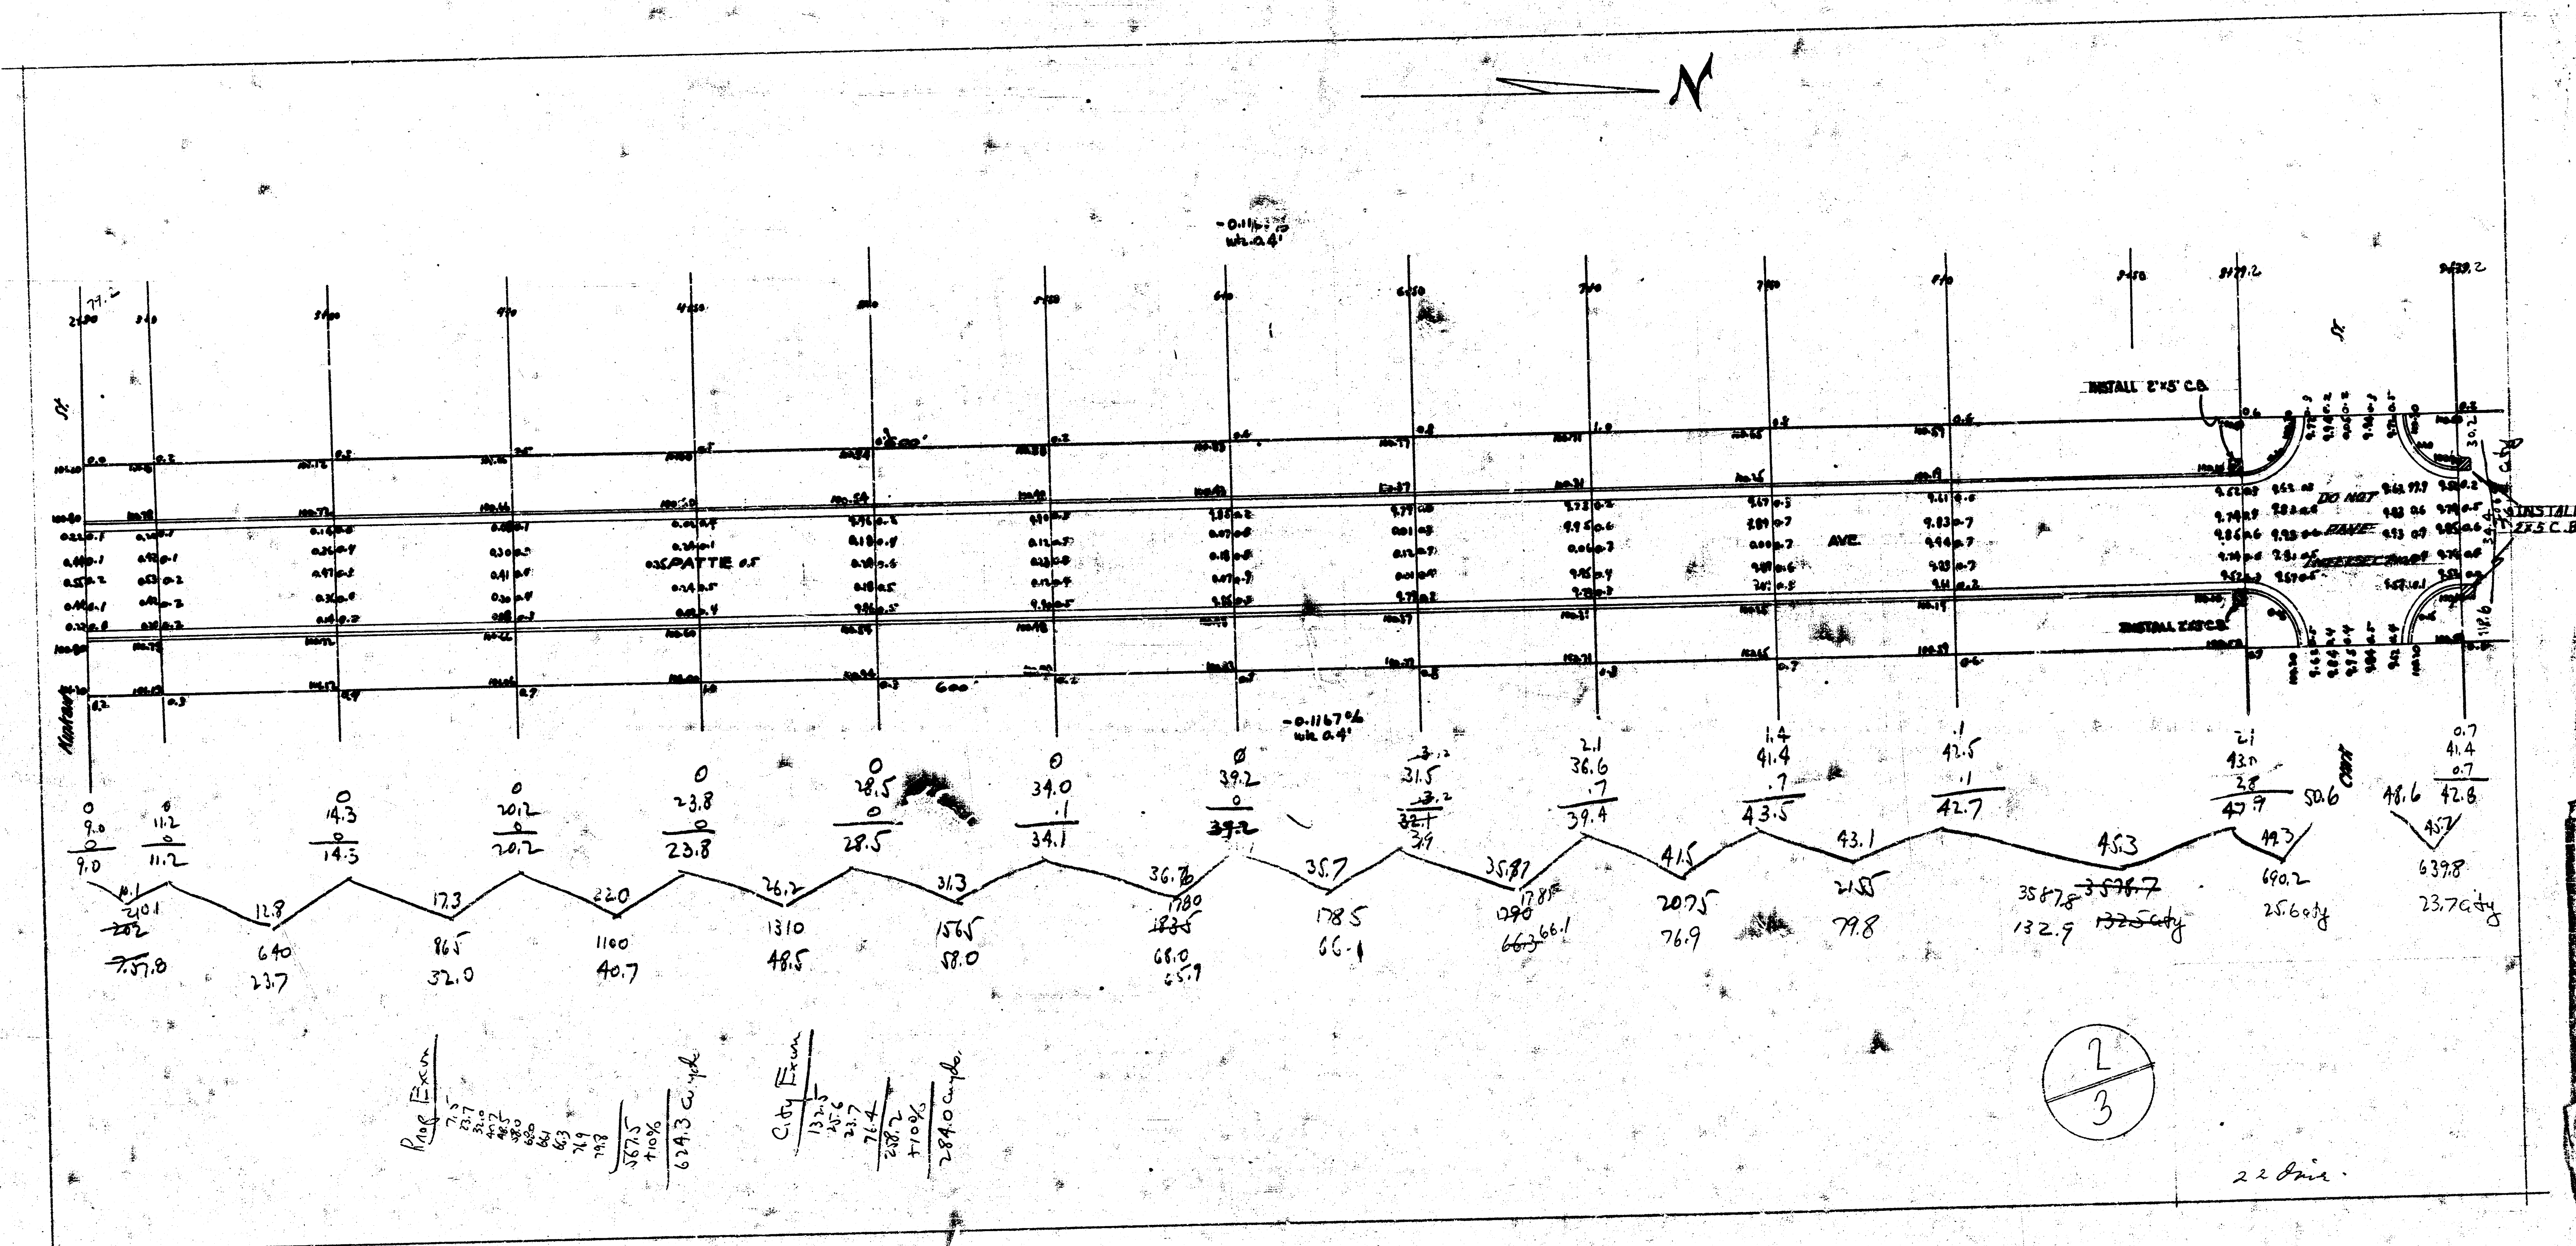

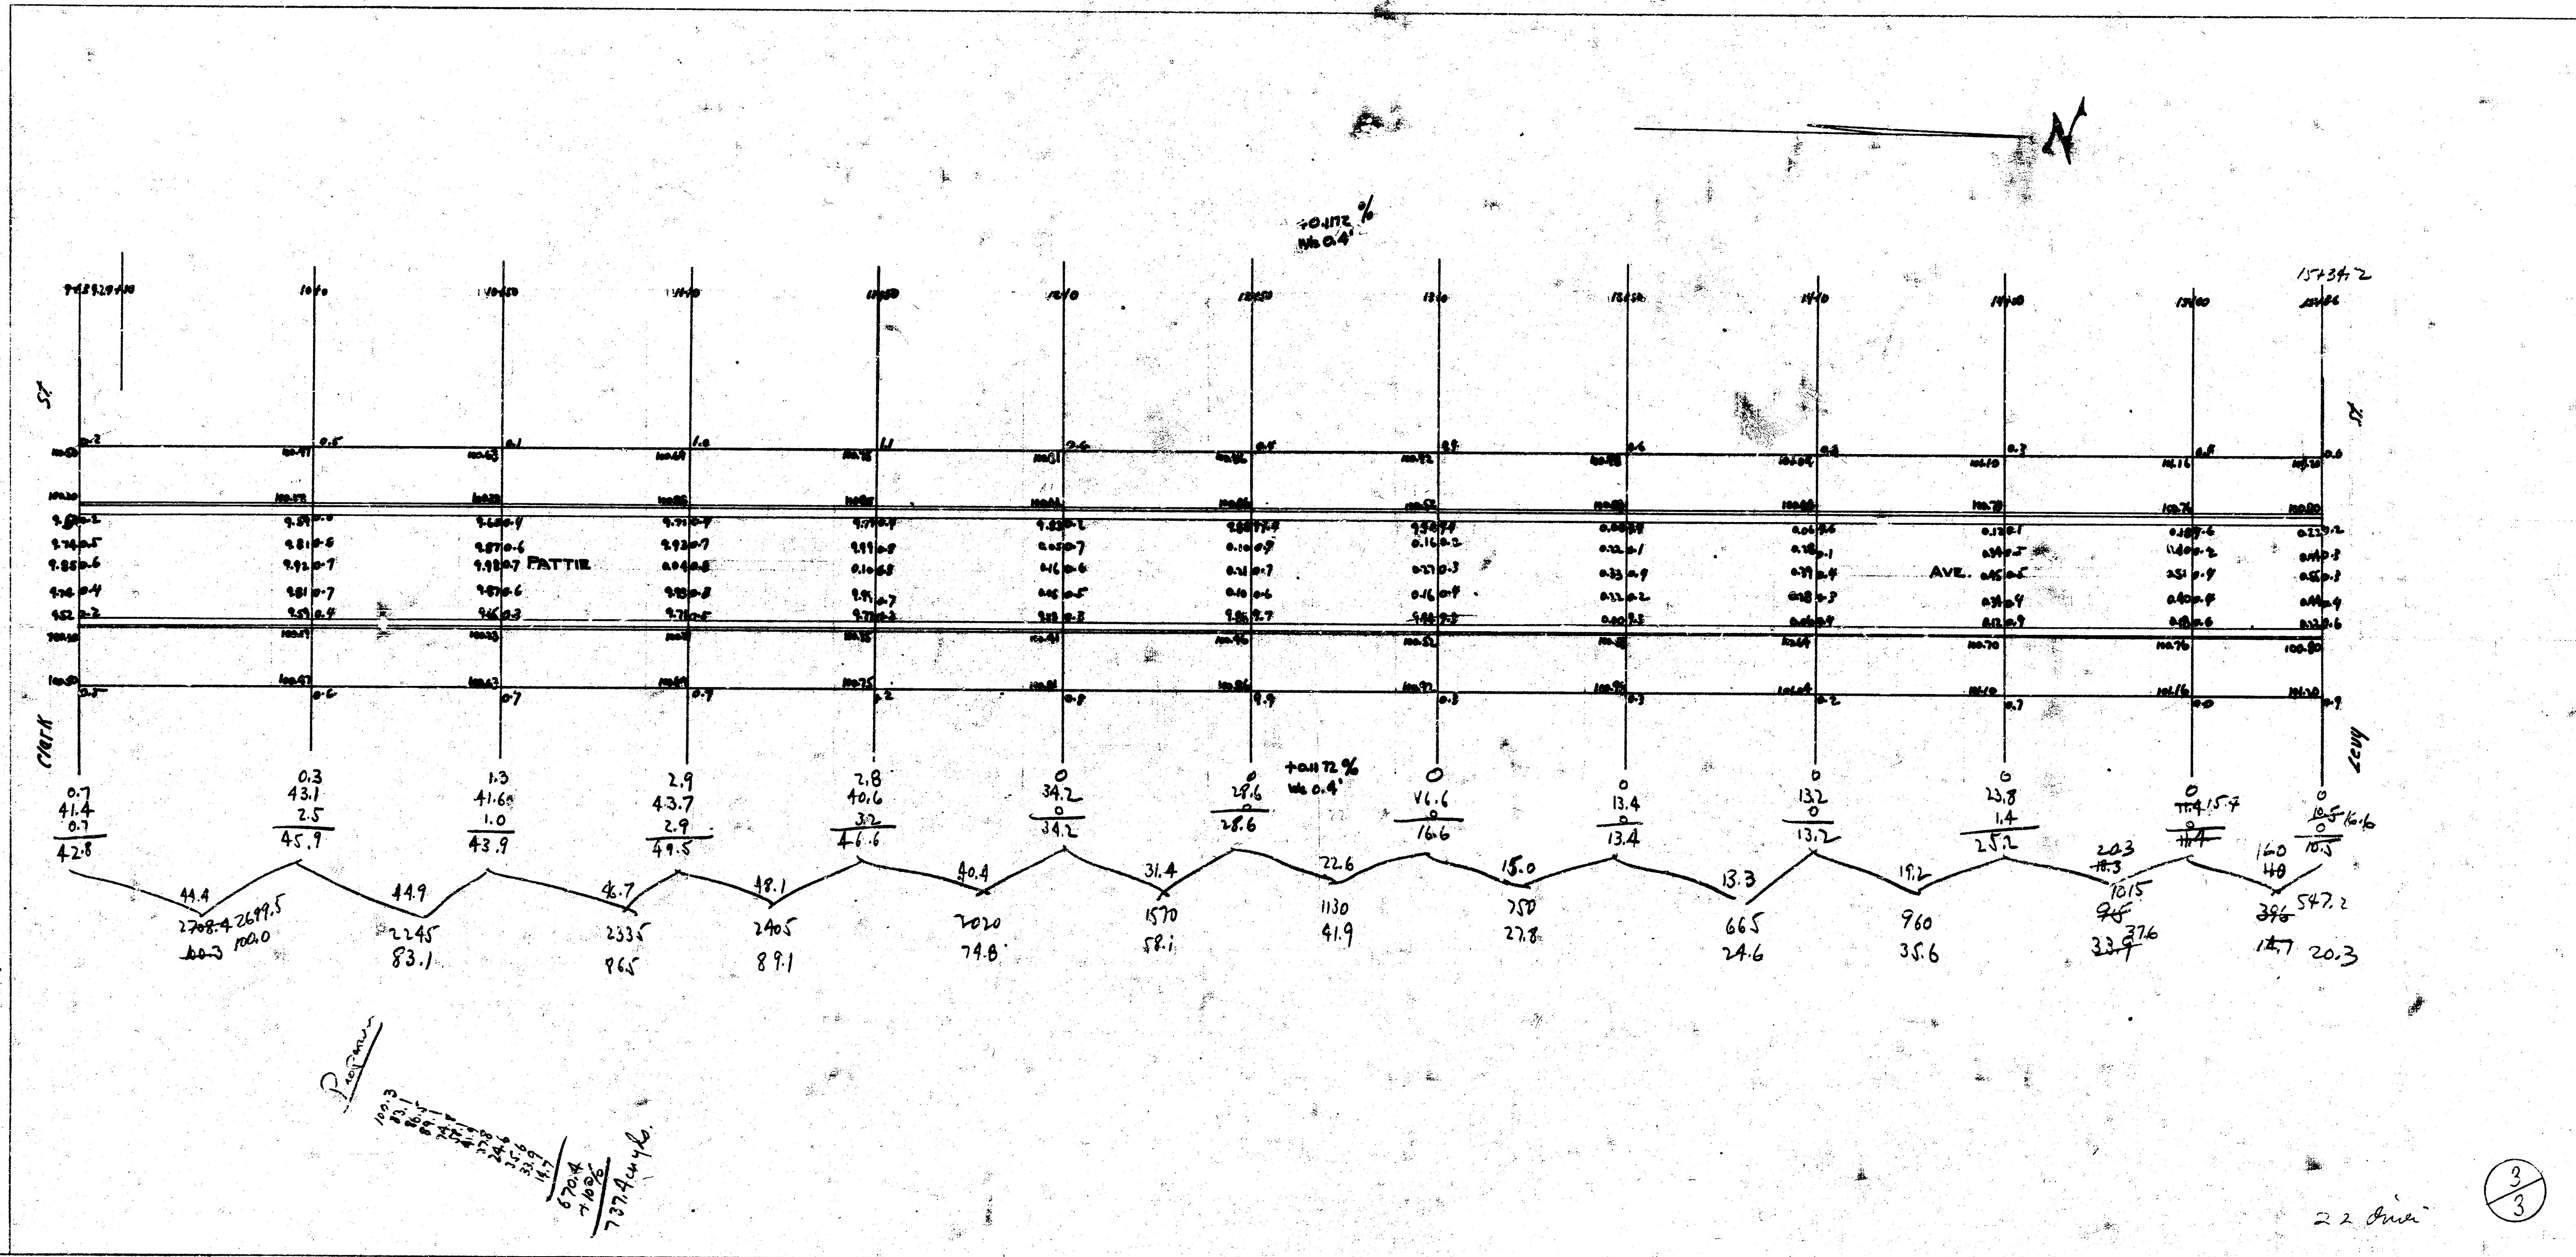

15 5 7 4

