


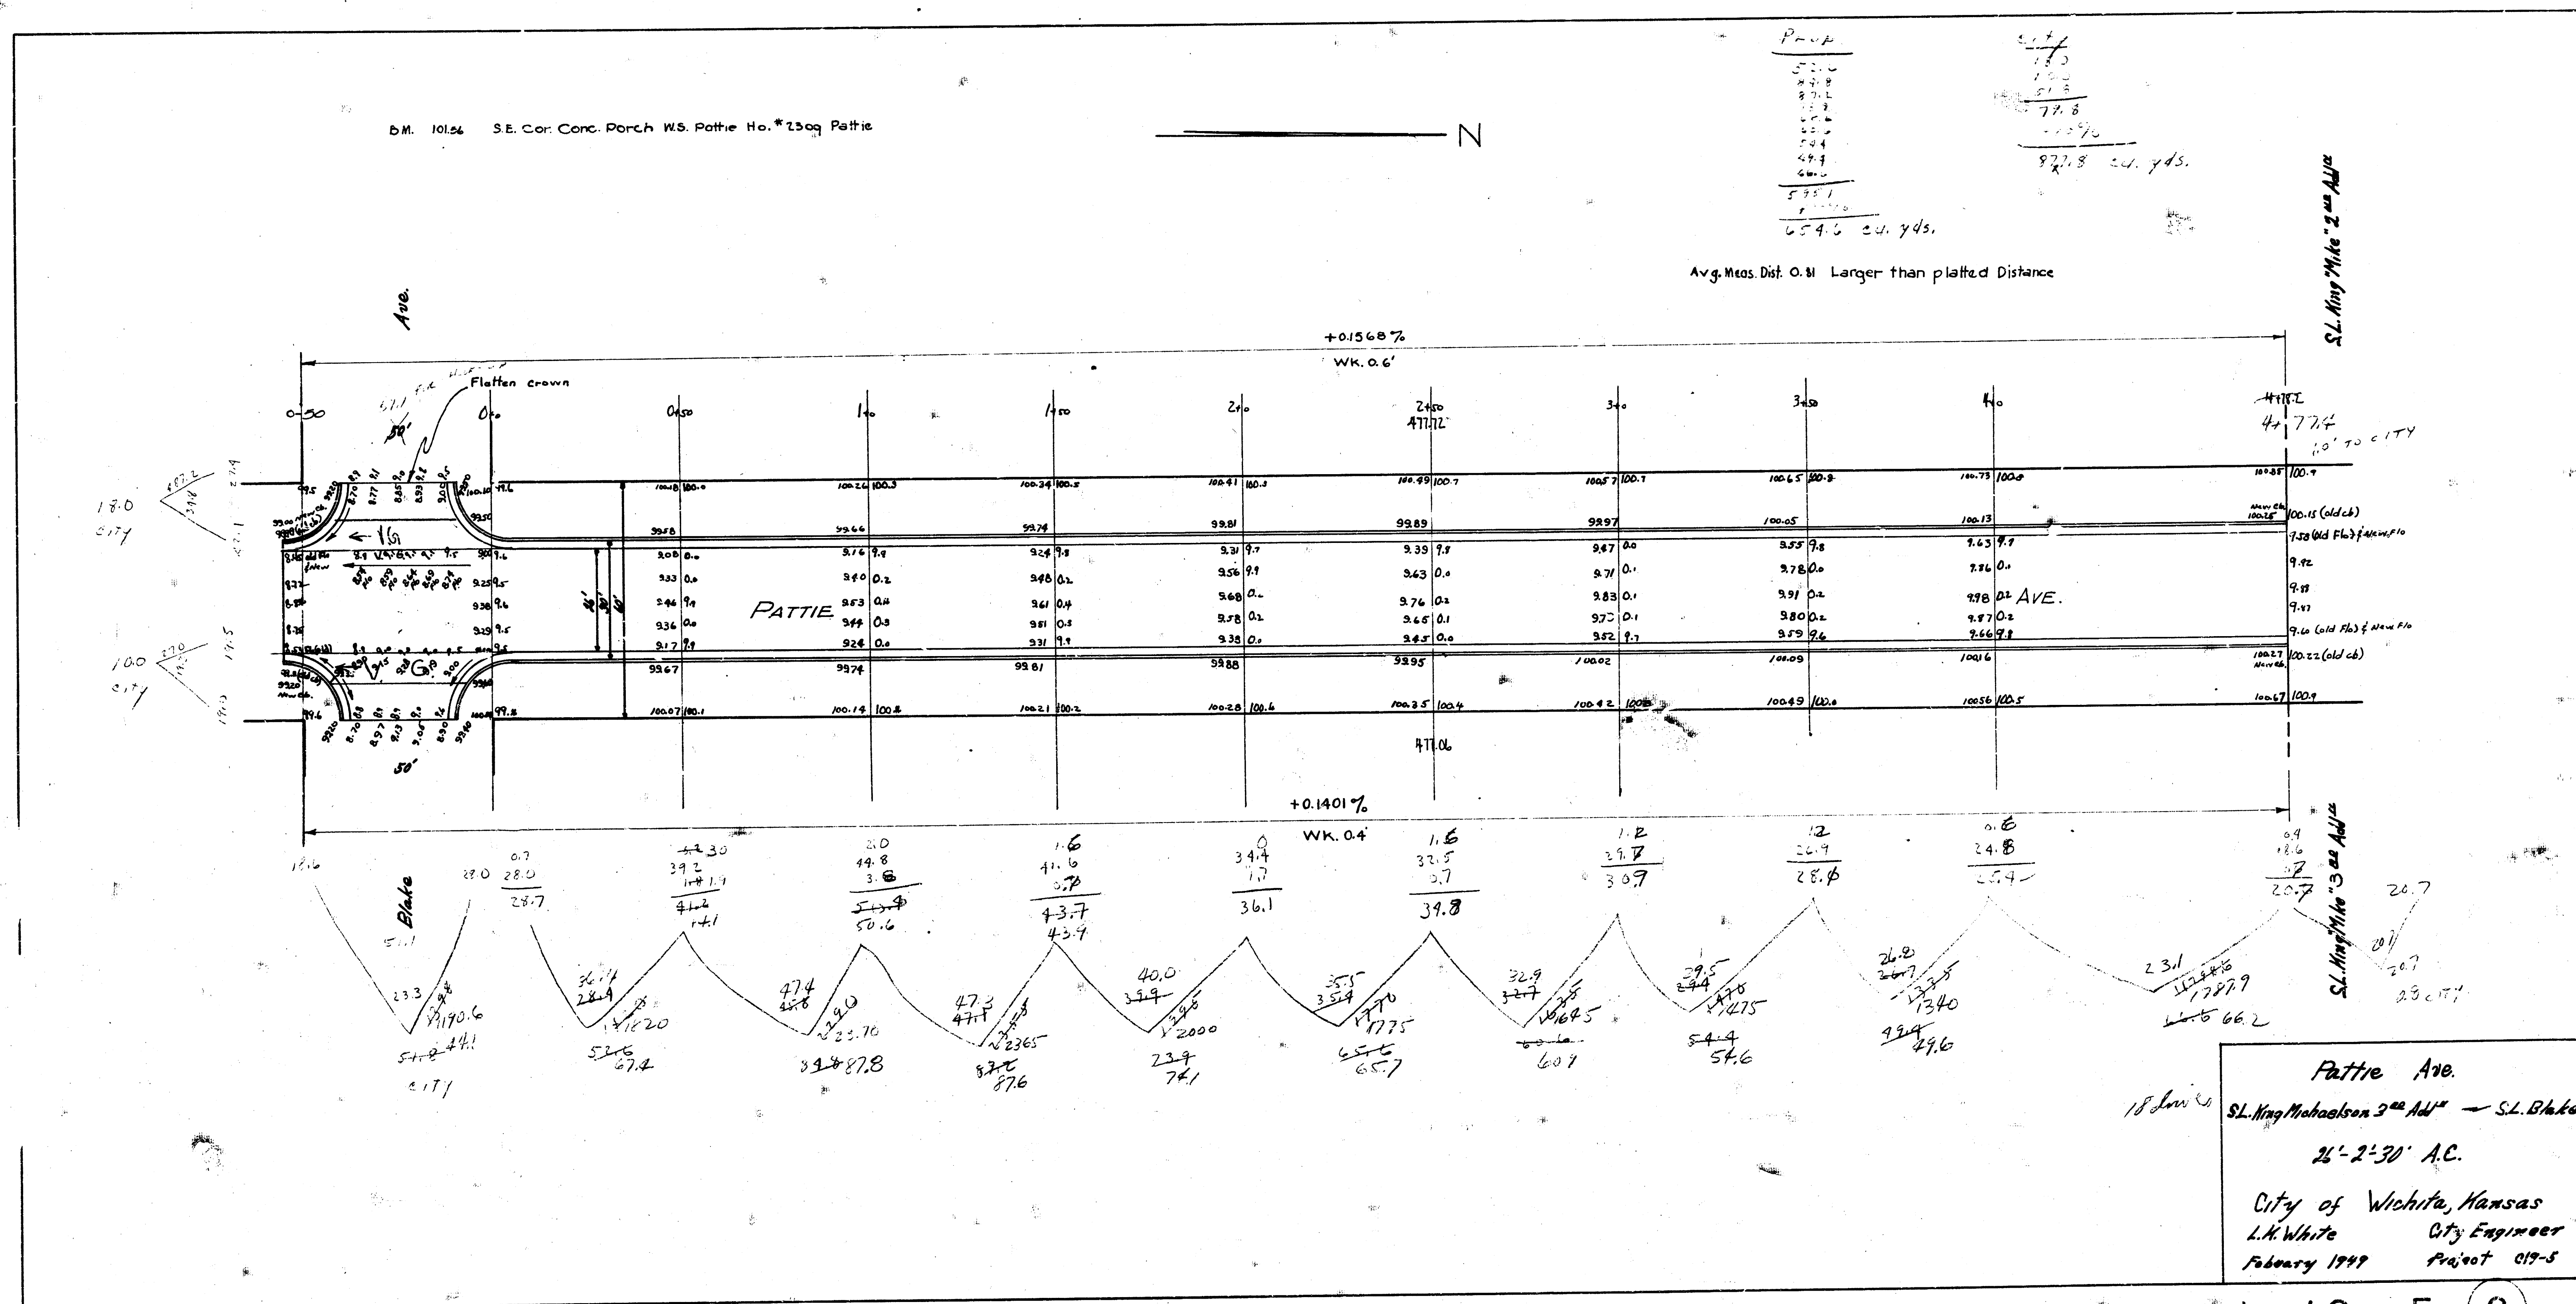

4 12 5 (9