


B.M. 60 #NAIL N.S. P. POLE S.W. COR. GARLAND & 25TH. ELEV. 125.66
 B.M. (STEP) P. POLE S.W. COR. PAYNE & 25TH. ELEV. 125.41

STA. ON E.



NOTE TO CONTRACTOR

WK. GRADE OF 0.4' WILL APPLY
 EXCEPT TO MATCH EXISTING
 CONC. DRIVES.

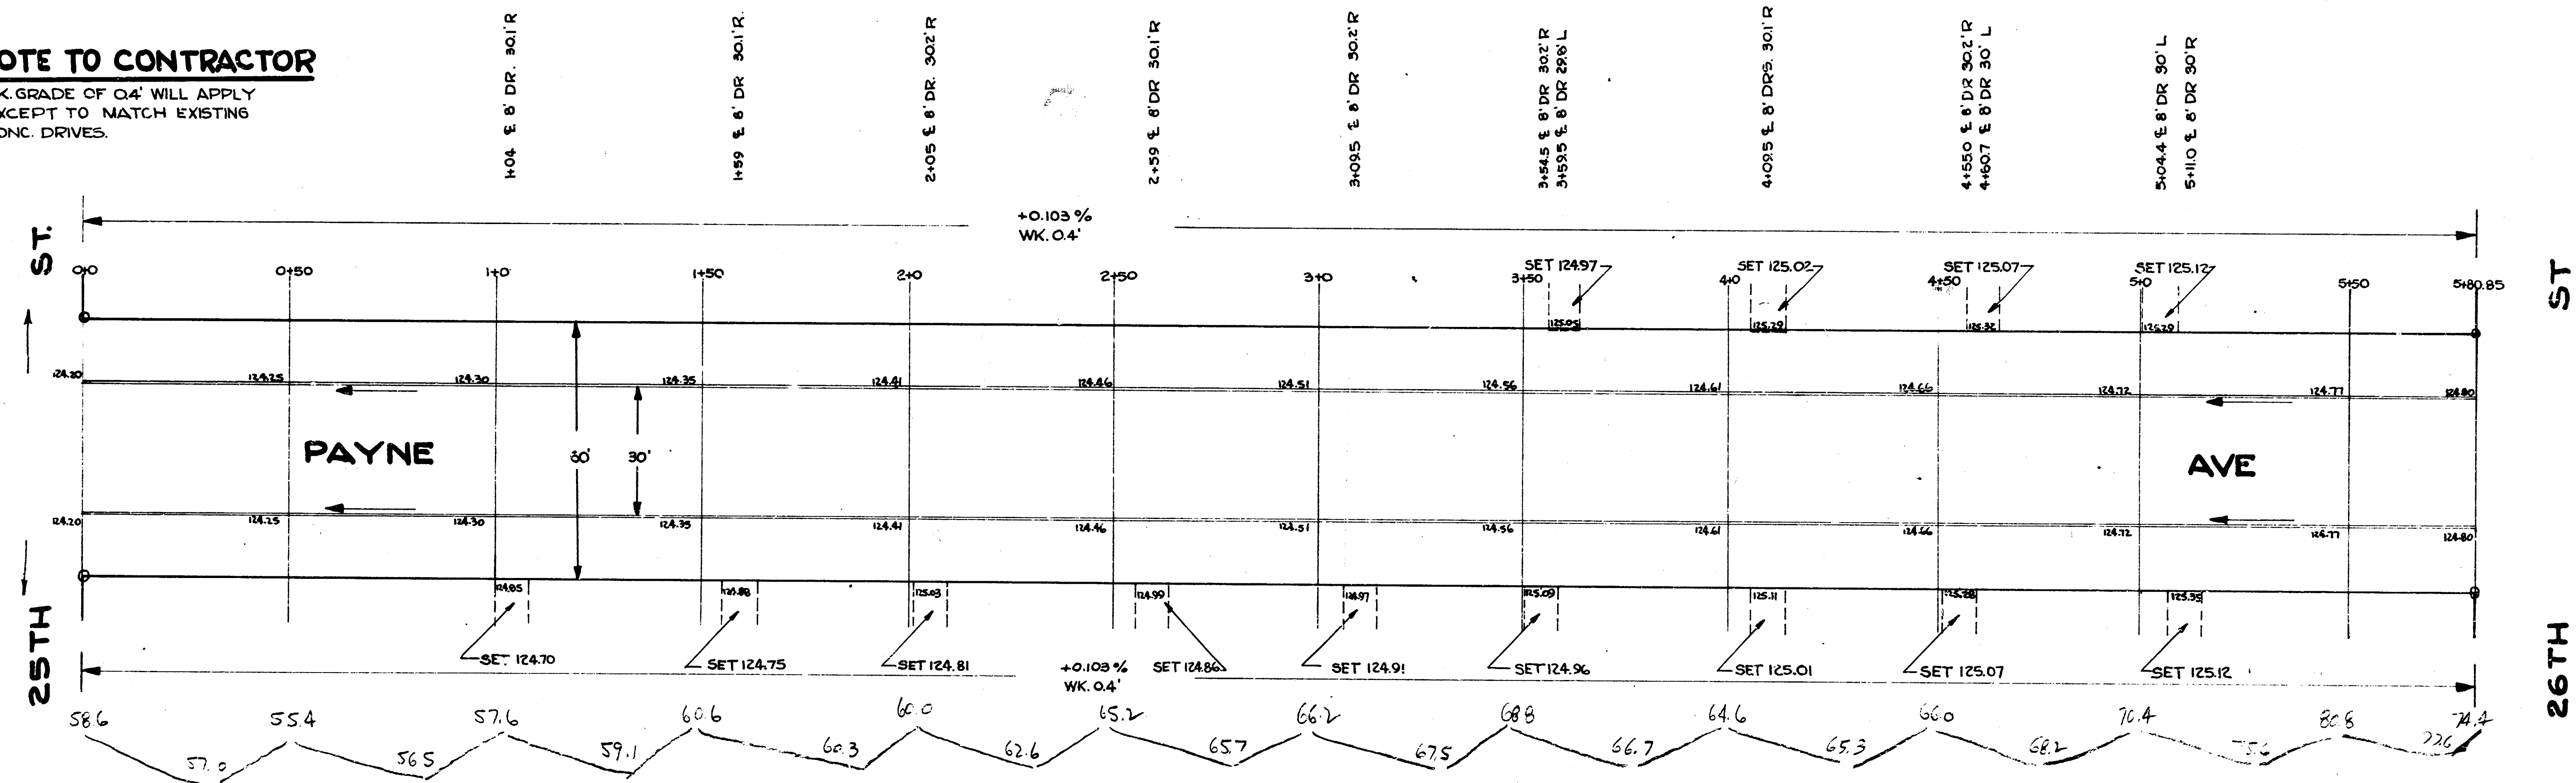

1393.3 cu yds
 +100/6
 1537.6 yds



PAYNE AVE
 N.L. 25TH TO S.L. 26TH
30' CONC. & CB
CITY OF WICHITA, KANS.
 B.E. SMITH CITY ENGINEER
 FEB 1954 PROJ. NO. C13-124