

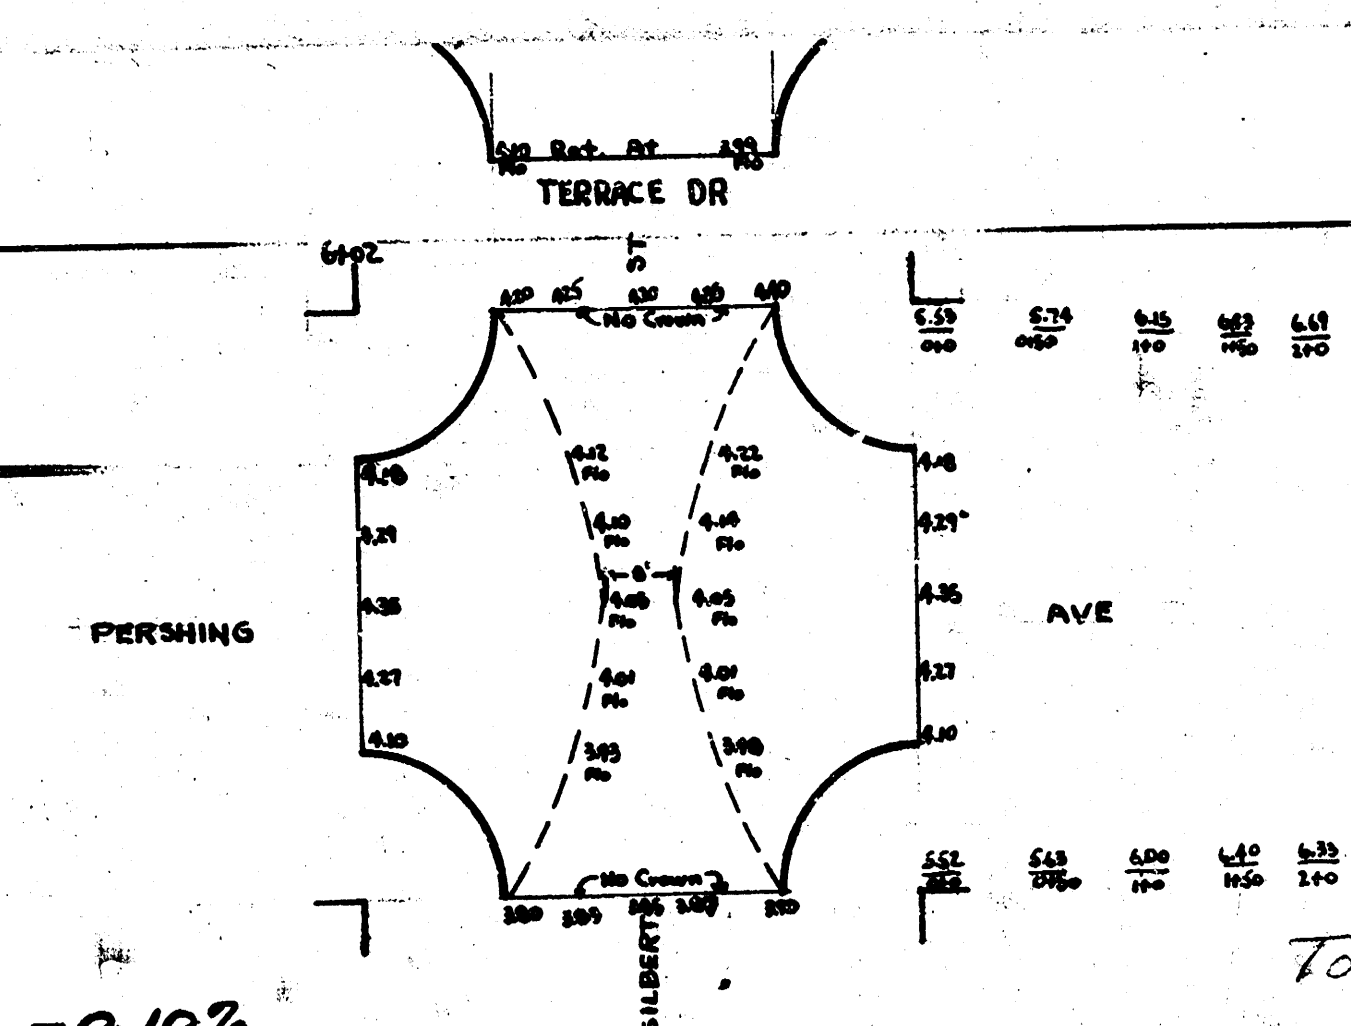


B.M. 11237 T in Hwy Top Hyd. N.W. Cor. Morris & Pershing

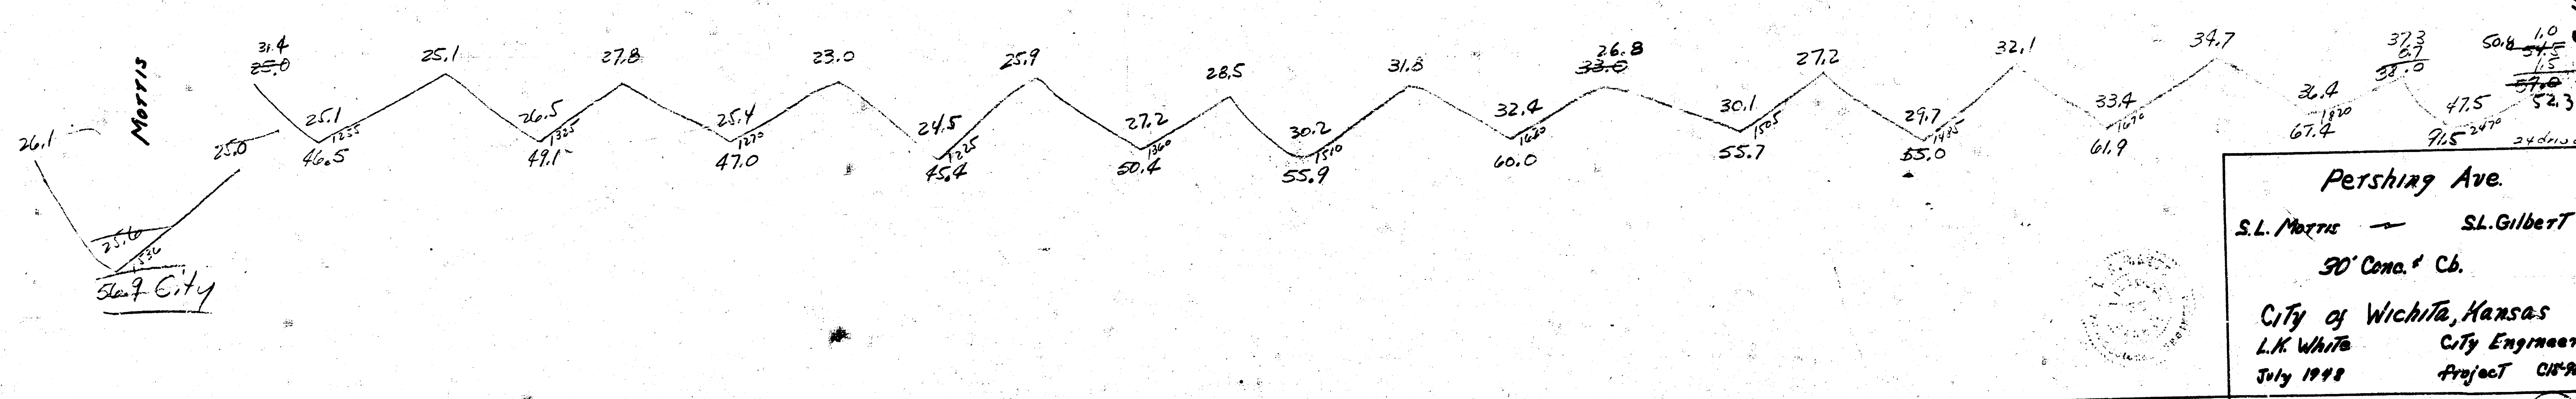

Prop.	City
46.5	56.9
49.1	22.7
47.0	24.0
55.4	103.6
55.9	110.0
60.0	
55.7	
55.0	
61.7	
67.4	
91.5	
685.8	
110.0	
Total 754.4 Cu.Yds.	Total 114.0 Cu.Yds.

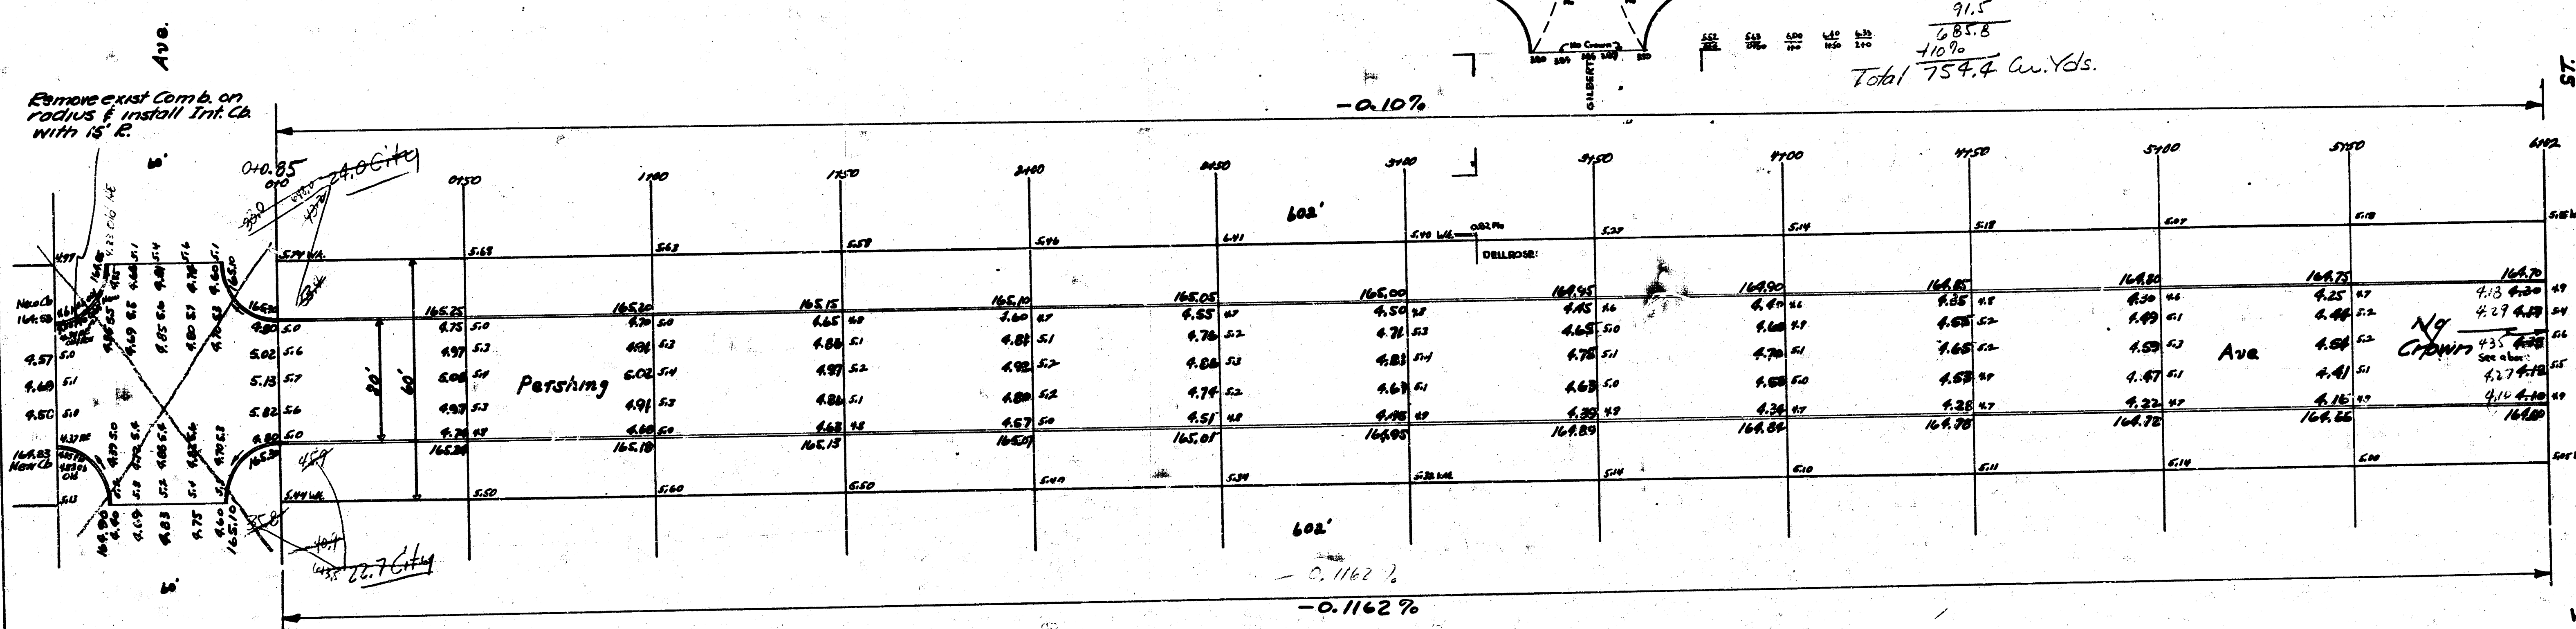

Pershing Ave.
S.L. Morris — S.L. Gilbert
90' Cona. Cb.
City of Wichita, Kansas
L.K. White City Engineer
July 1948 Project C-190