


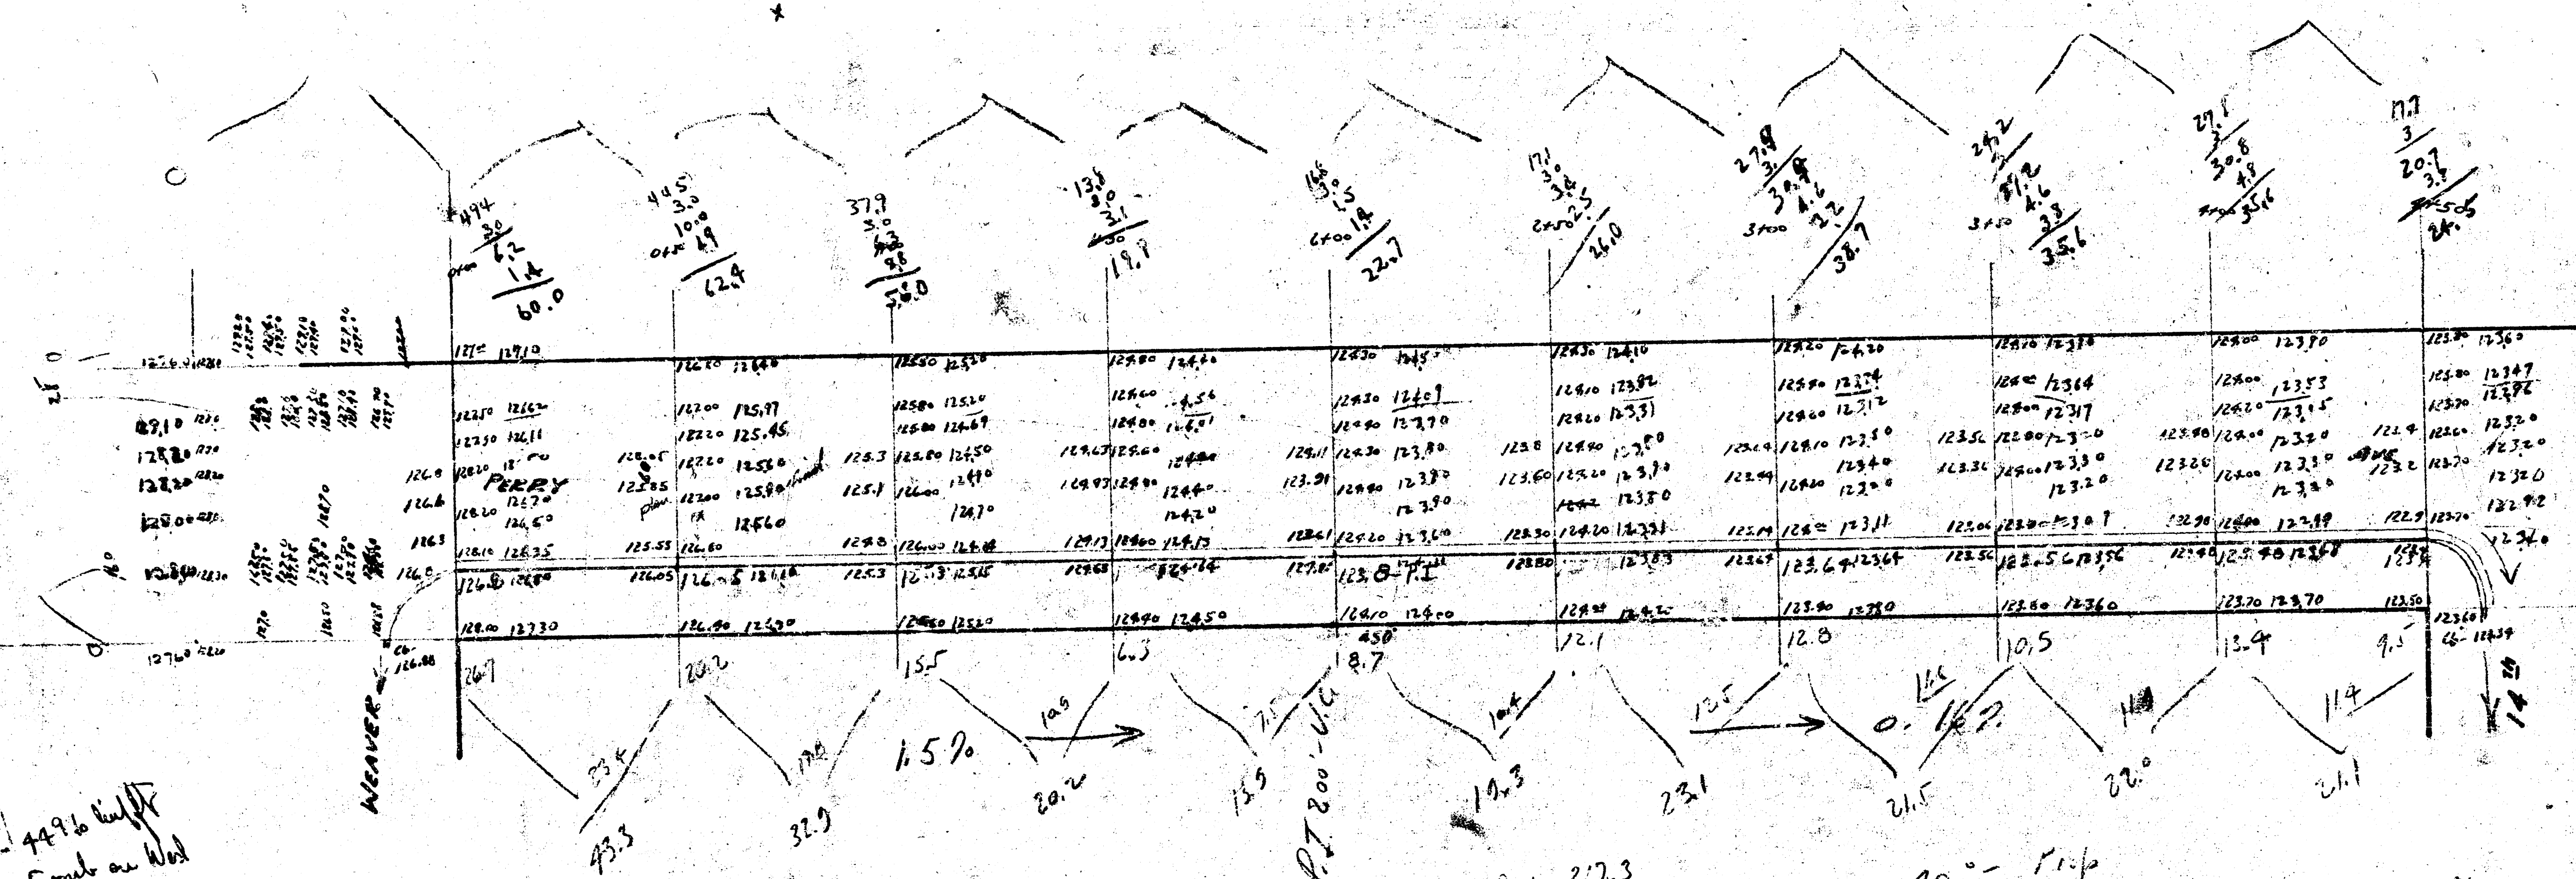

44.9% left  
Cont on West  
Side

Prop - 21.3  
+ 10.9 = 32.2  
City