

Property

9.8	
8.1	
7.7	
6.1	
5.0	
4.4	
5.3	
5.7	
5.1	
7.0	
9.0	
9.3	8.6
52.5	

PROPERTY	COVD	+ 10%	TOTAL
	82.5	8.3	90.8

PERSHING AVE. FR. ST. KELLOGG TO N.L. ORME, O.F.G. E.S.


21. Elev. 165.97 NE. W.L. Delrose N.L. Orme.
169.13 " in Levee in Drive " 507 S. Pershing.

Tentative Grades

East side should be held higher than
the west side and run on
straight grade. the west side
for settled.

V.C. To follow West Side

For final grades check and regrade on West side
at closer intervals than 100' as was done on preliminary.

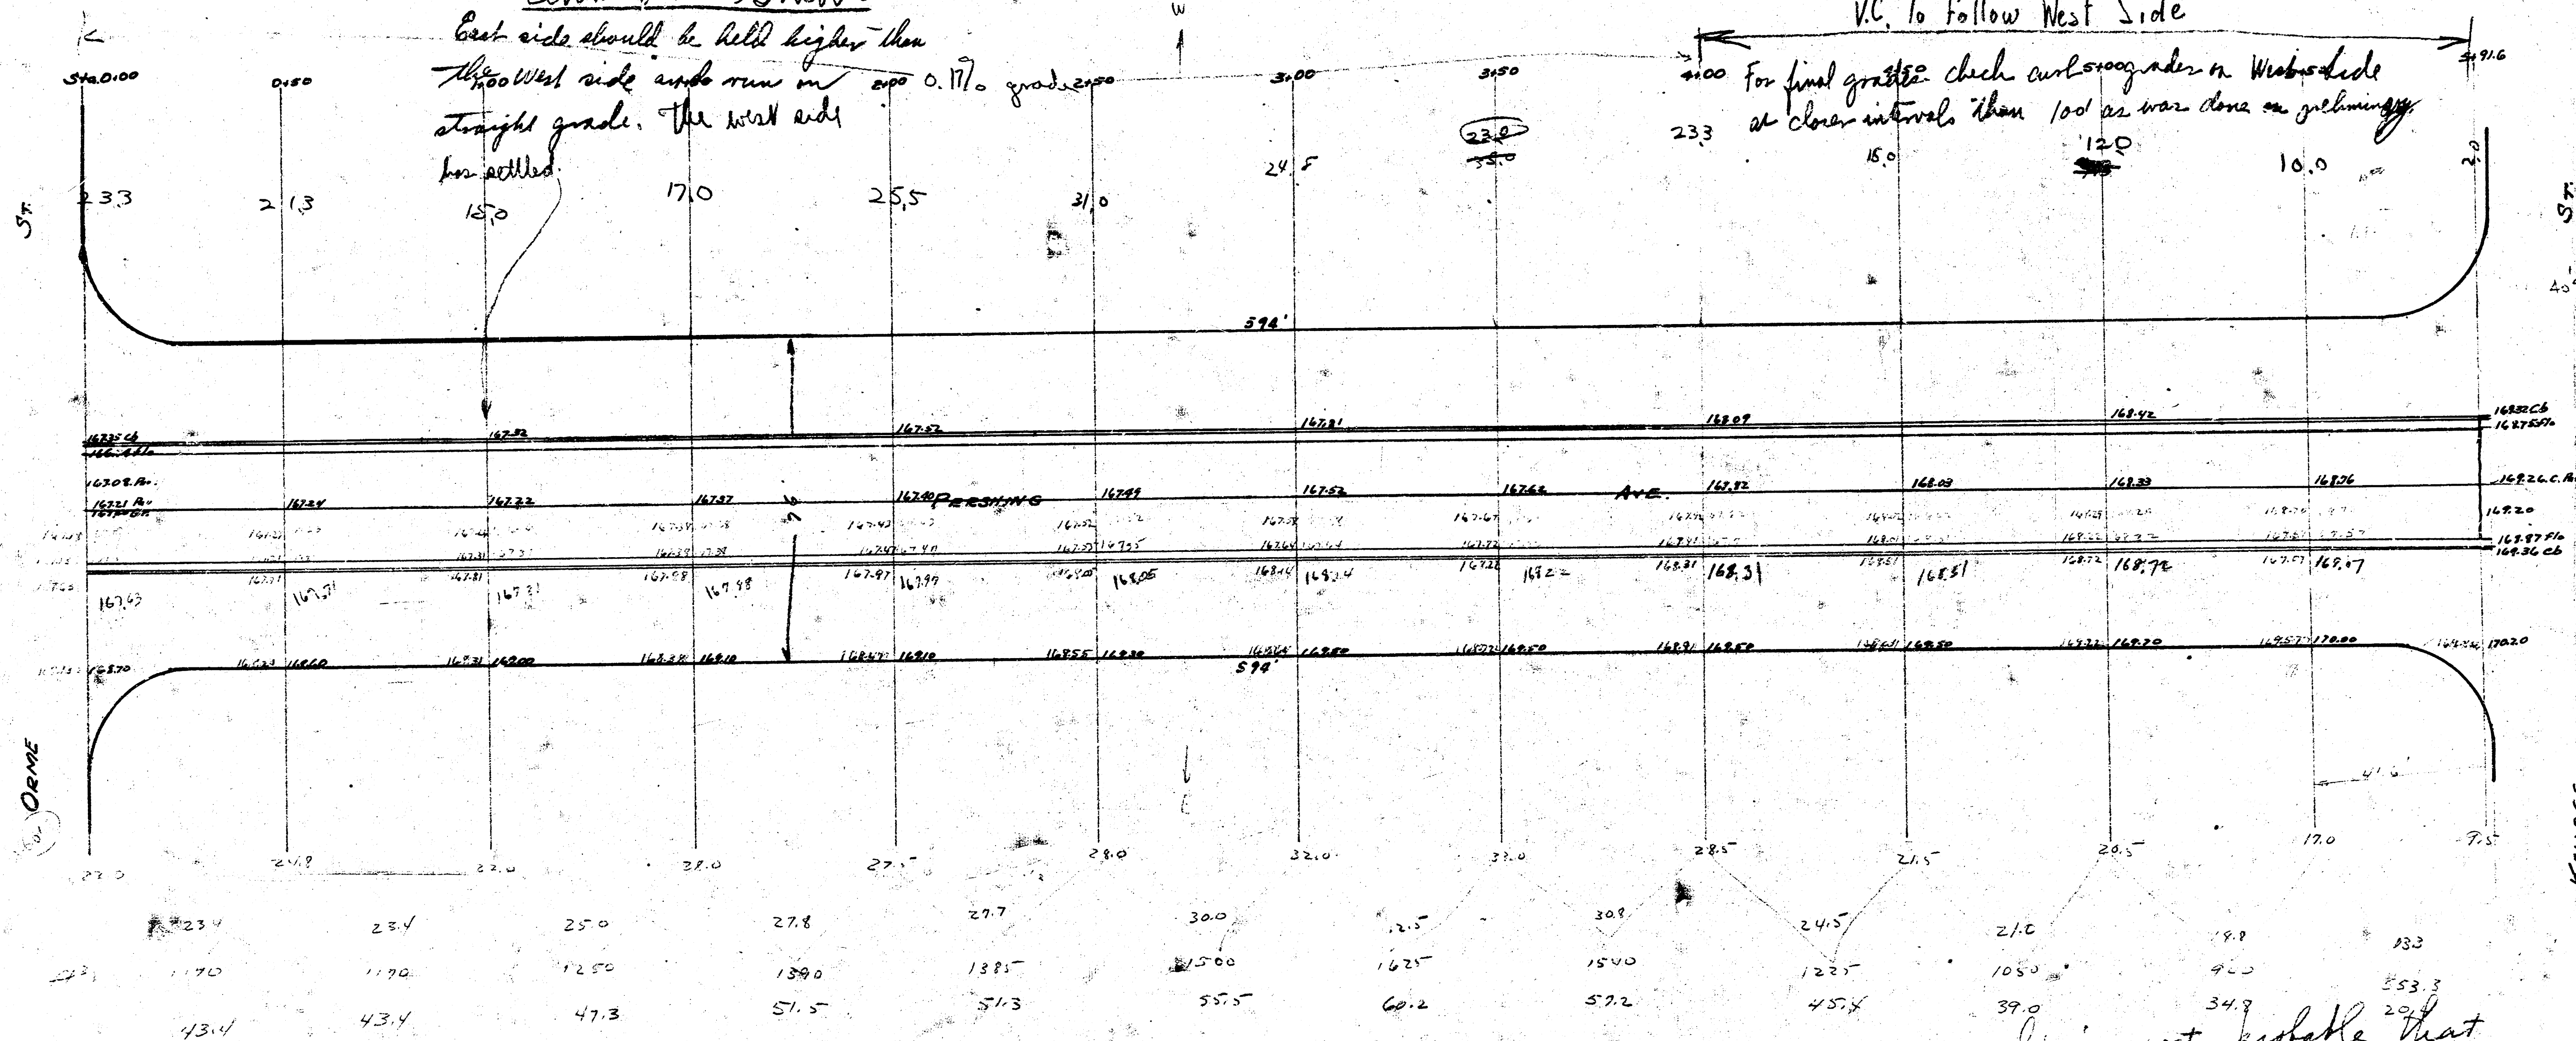

It is not probable that
excavation will be made
more than 5' from the gutter
into the street. Present street
surface being well established.

Paving Plan
Pershing Ave.
St. Kellogg
to N.L. Orme
1/20