


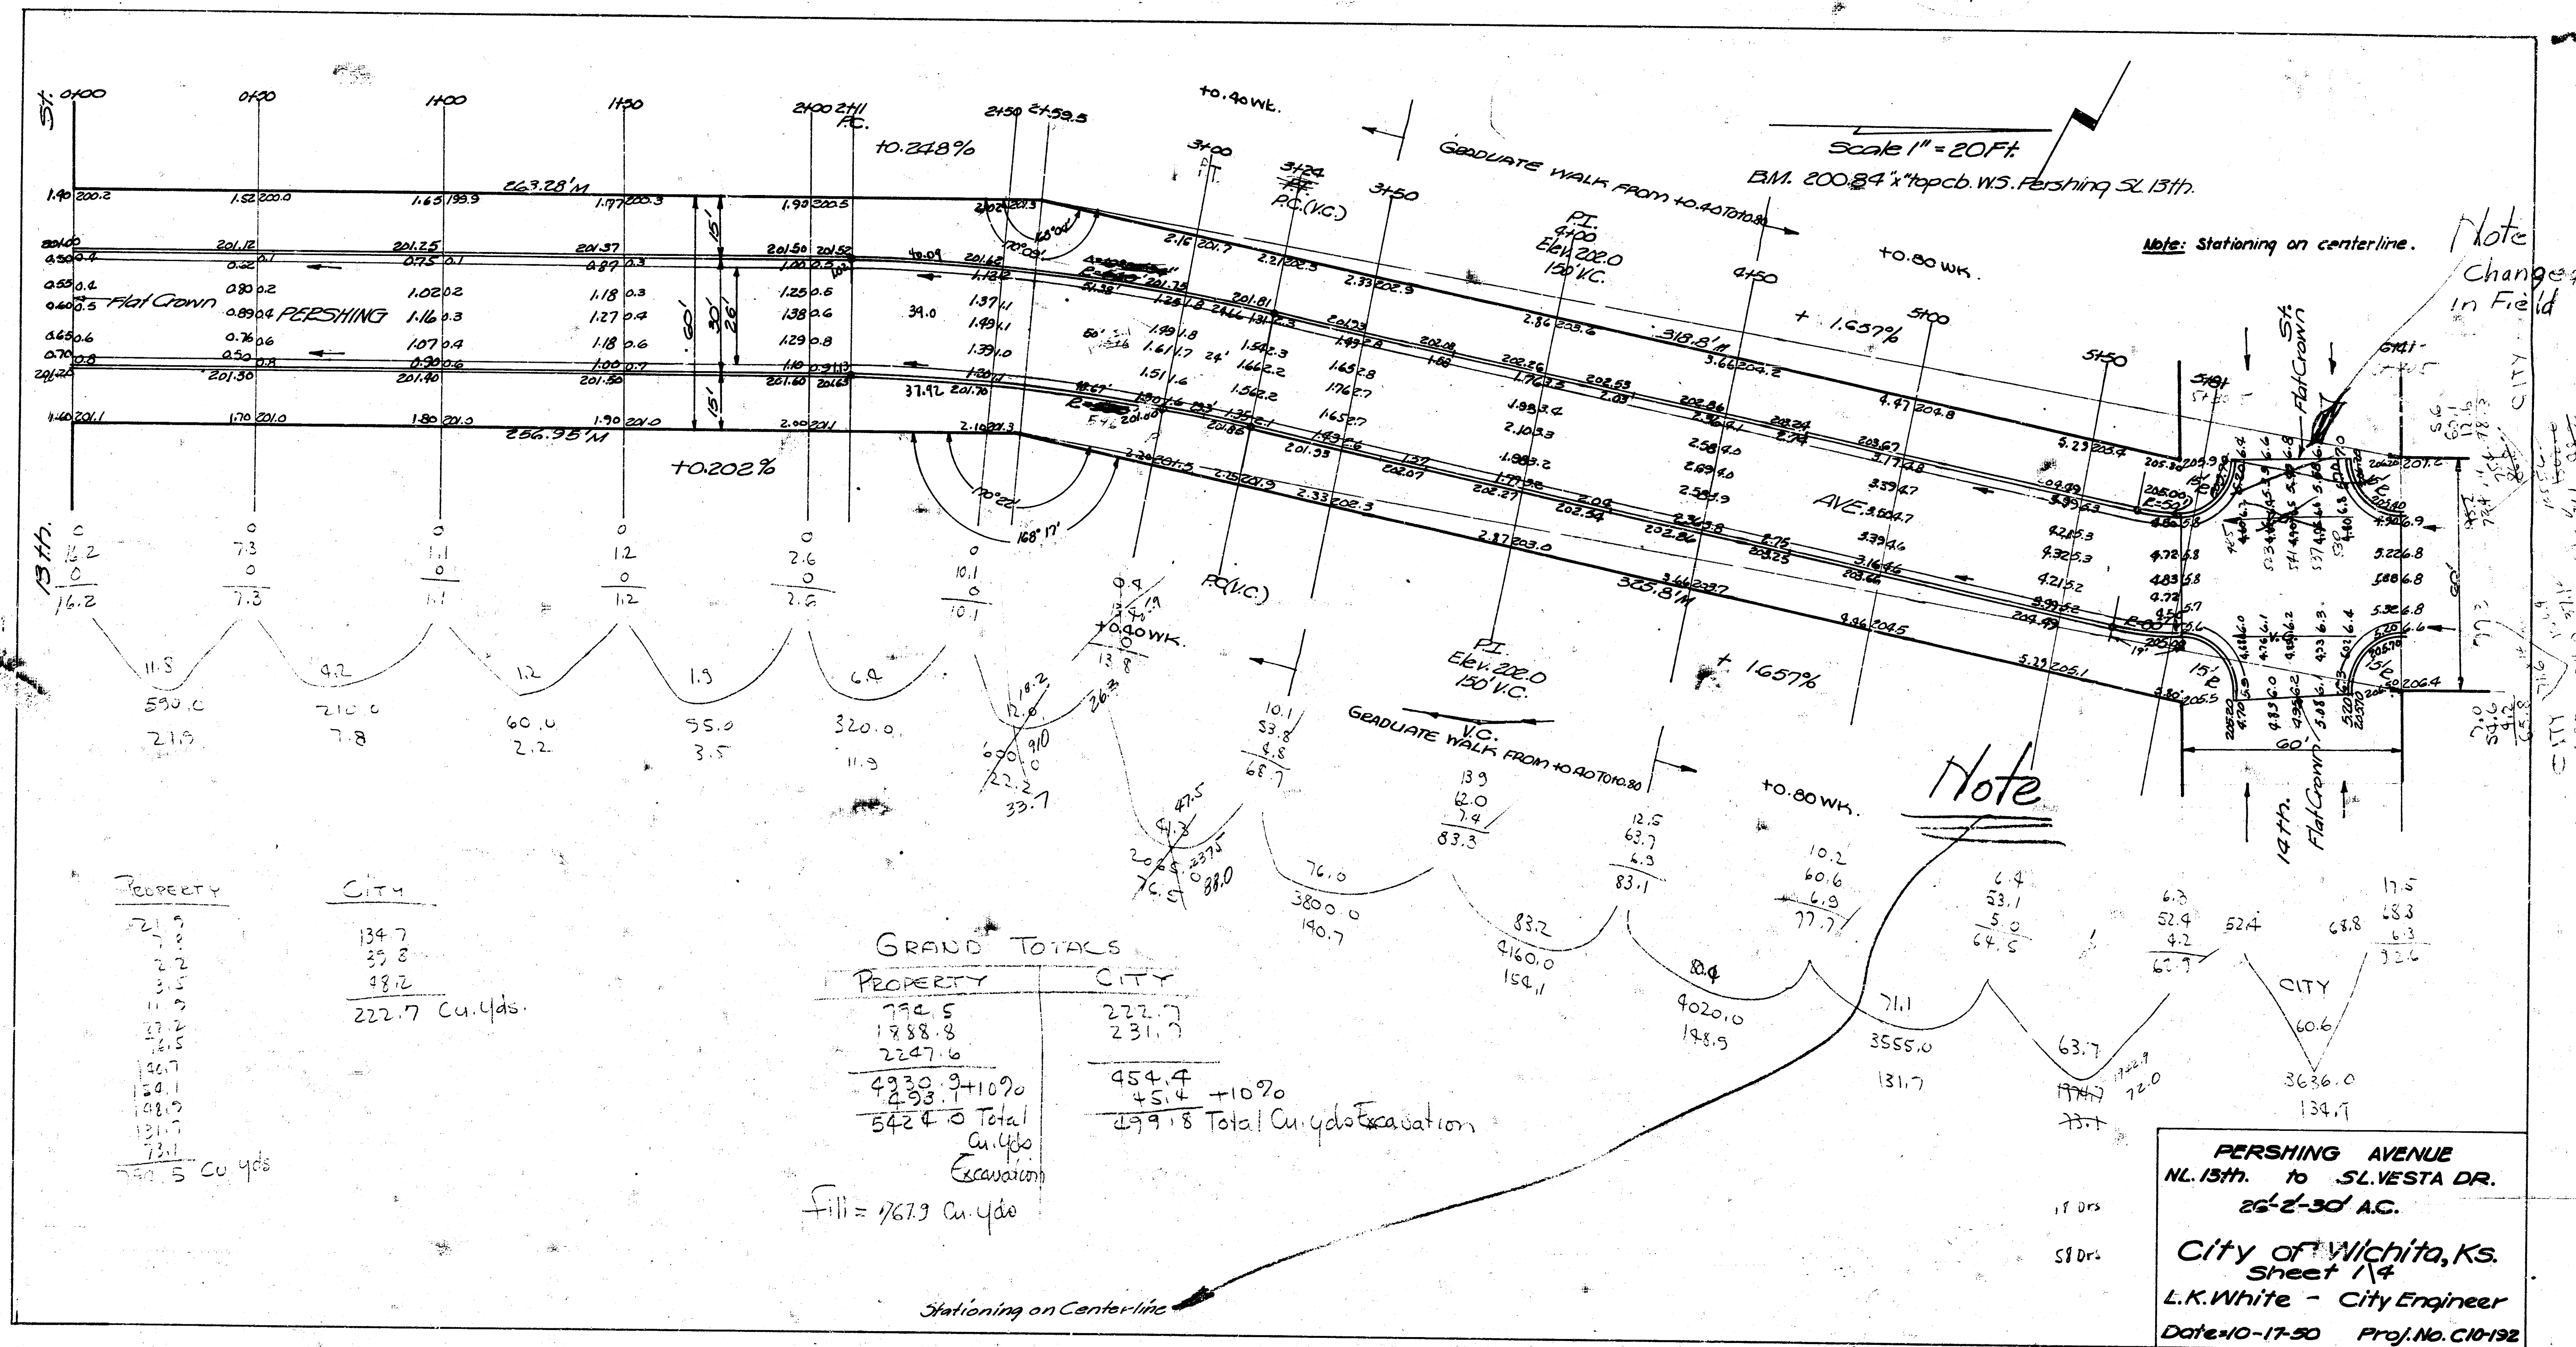

Scale 1" = 20 FT.

