




Note:
C.B. Grades raised as shown

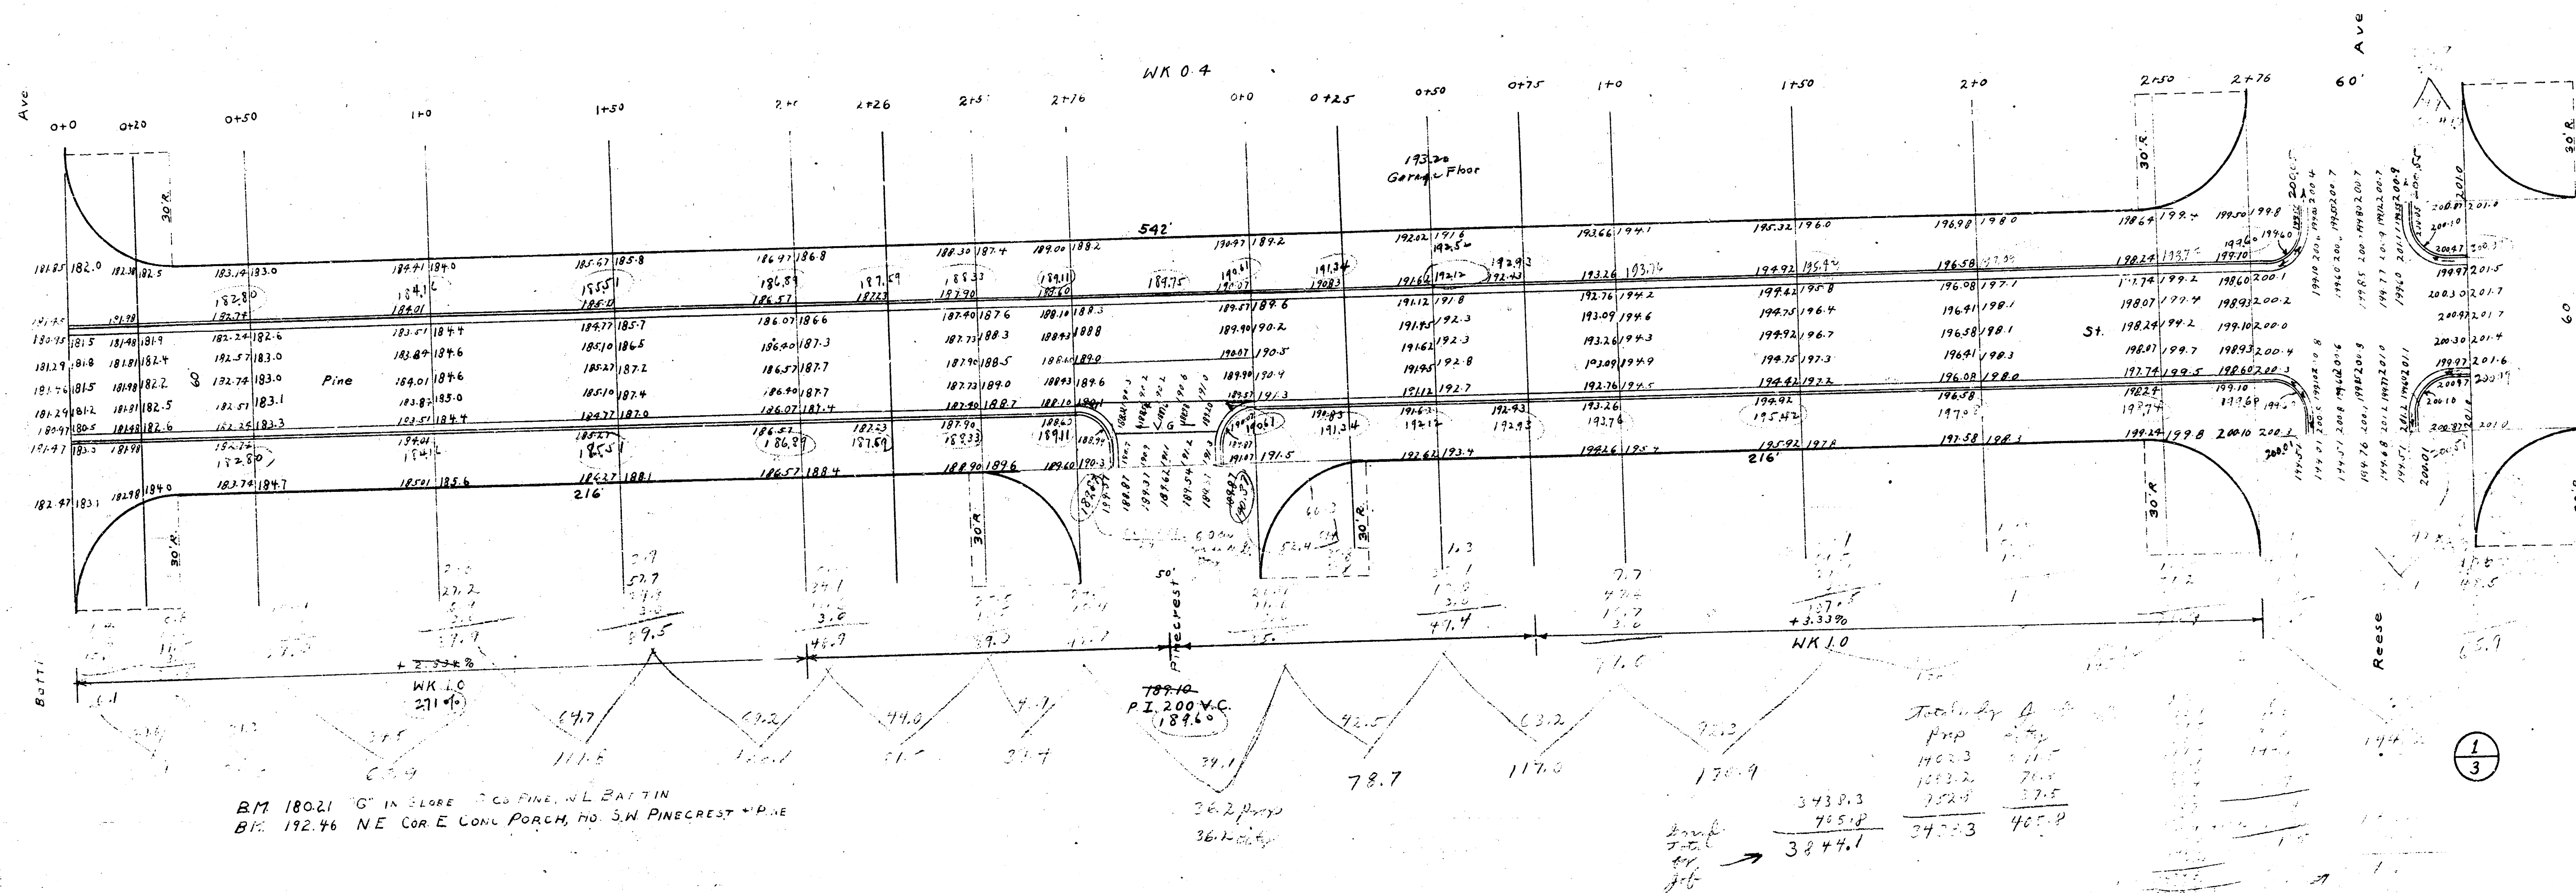

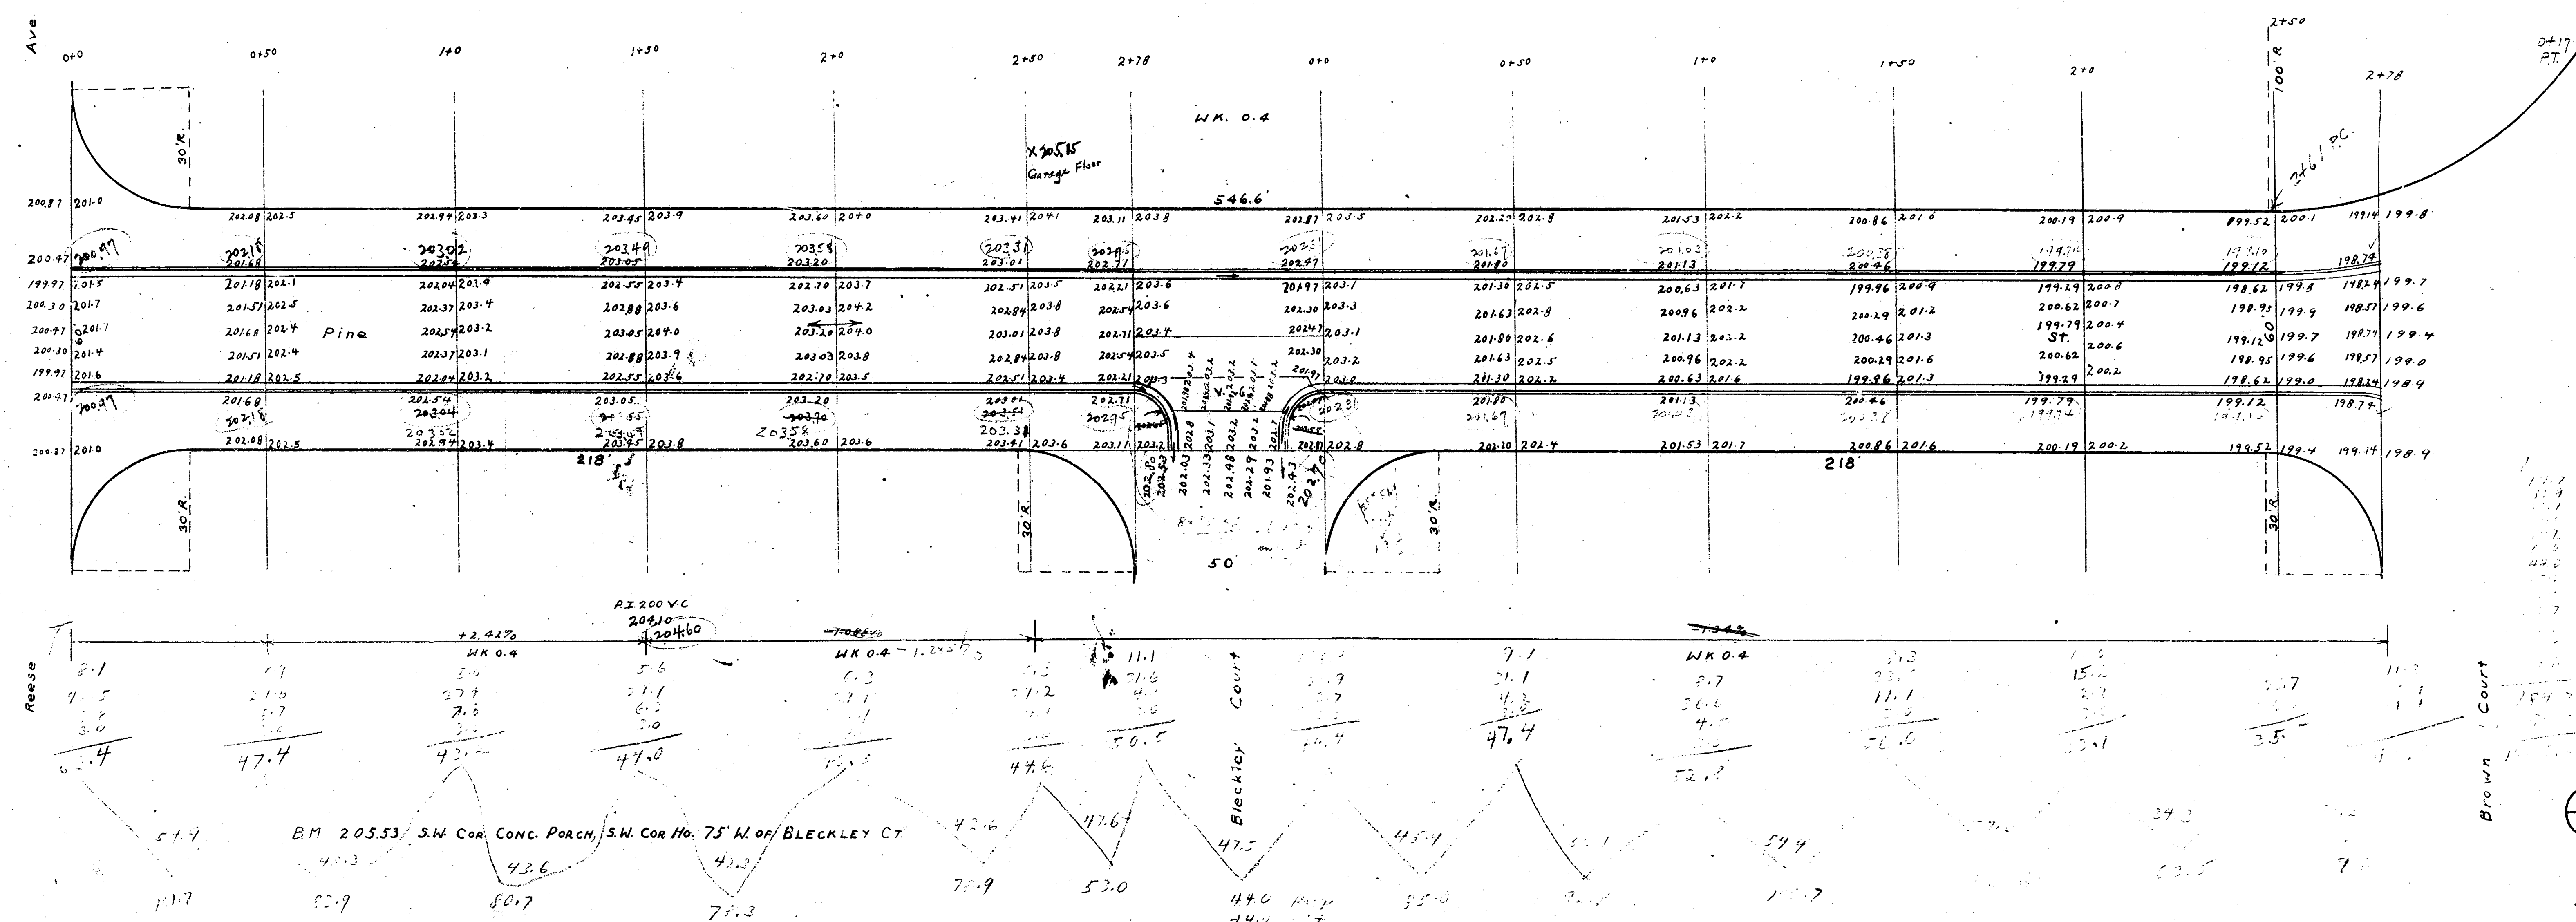

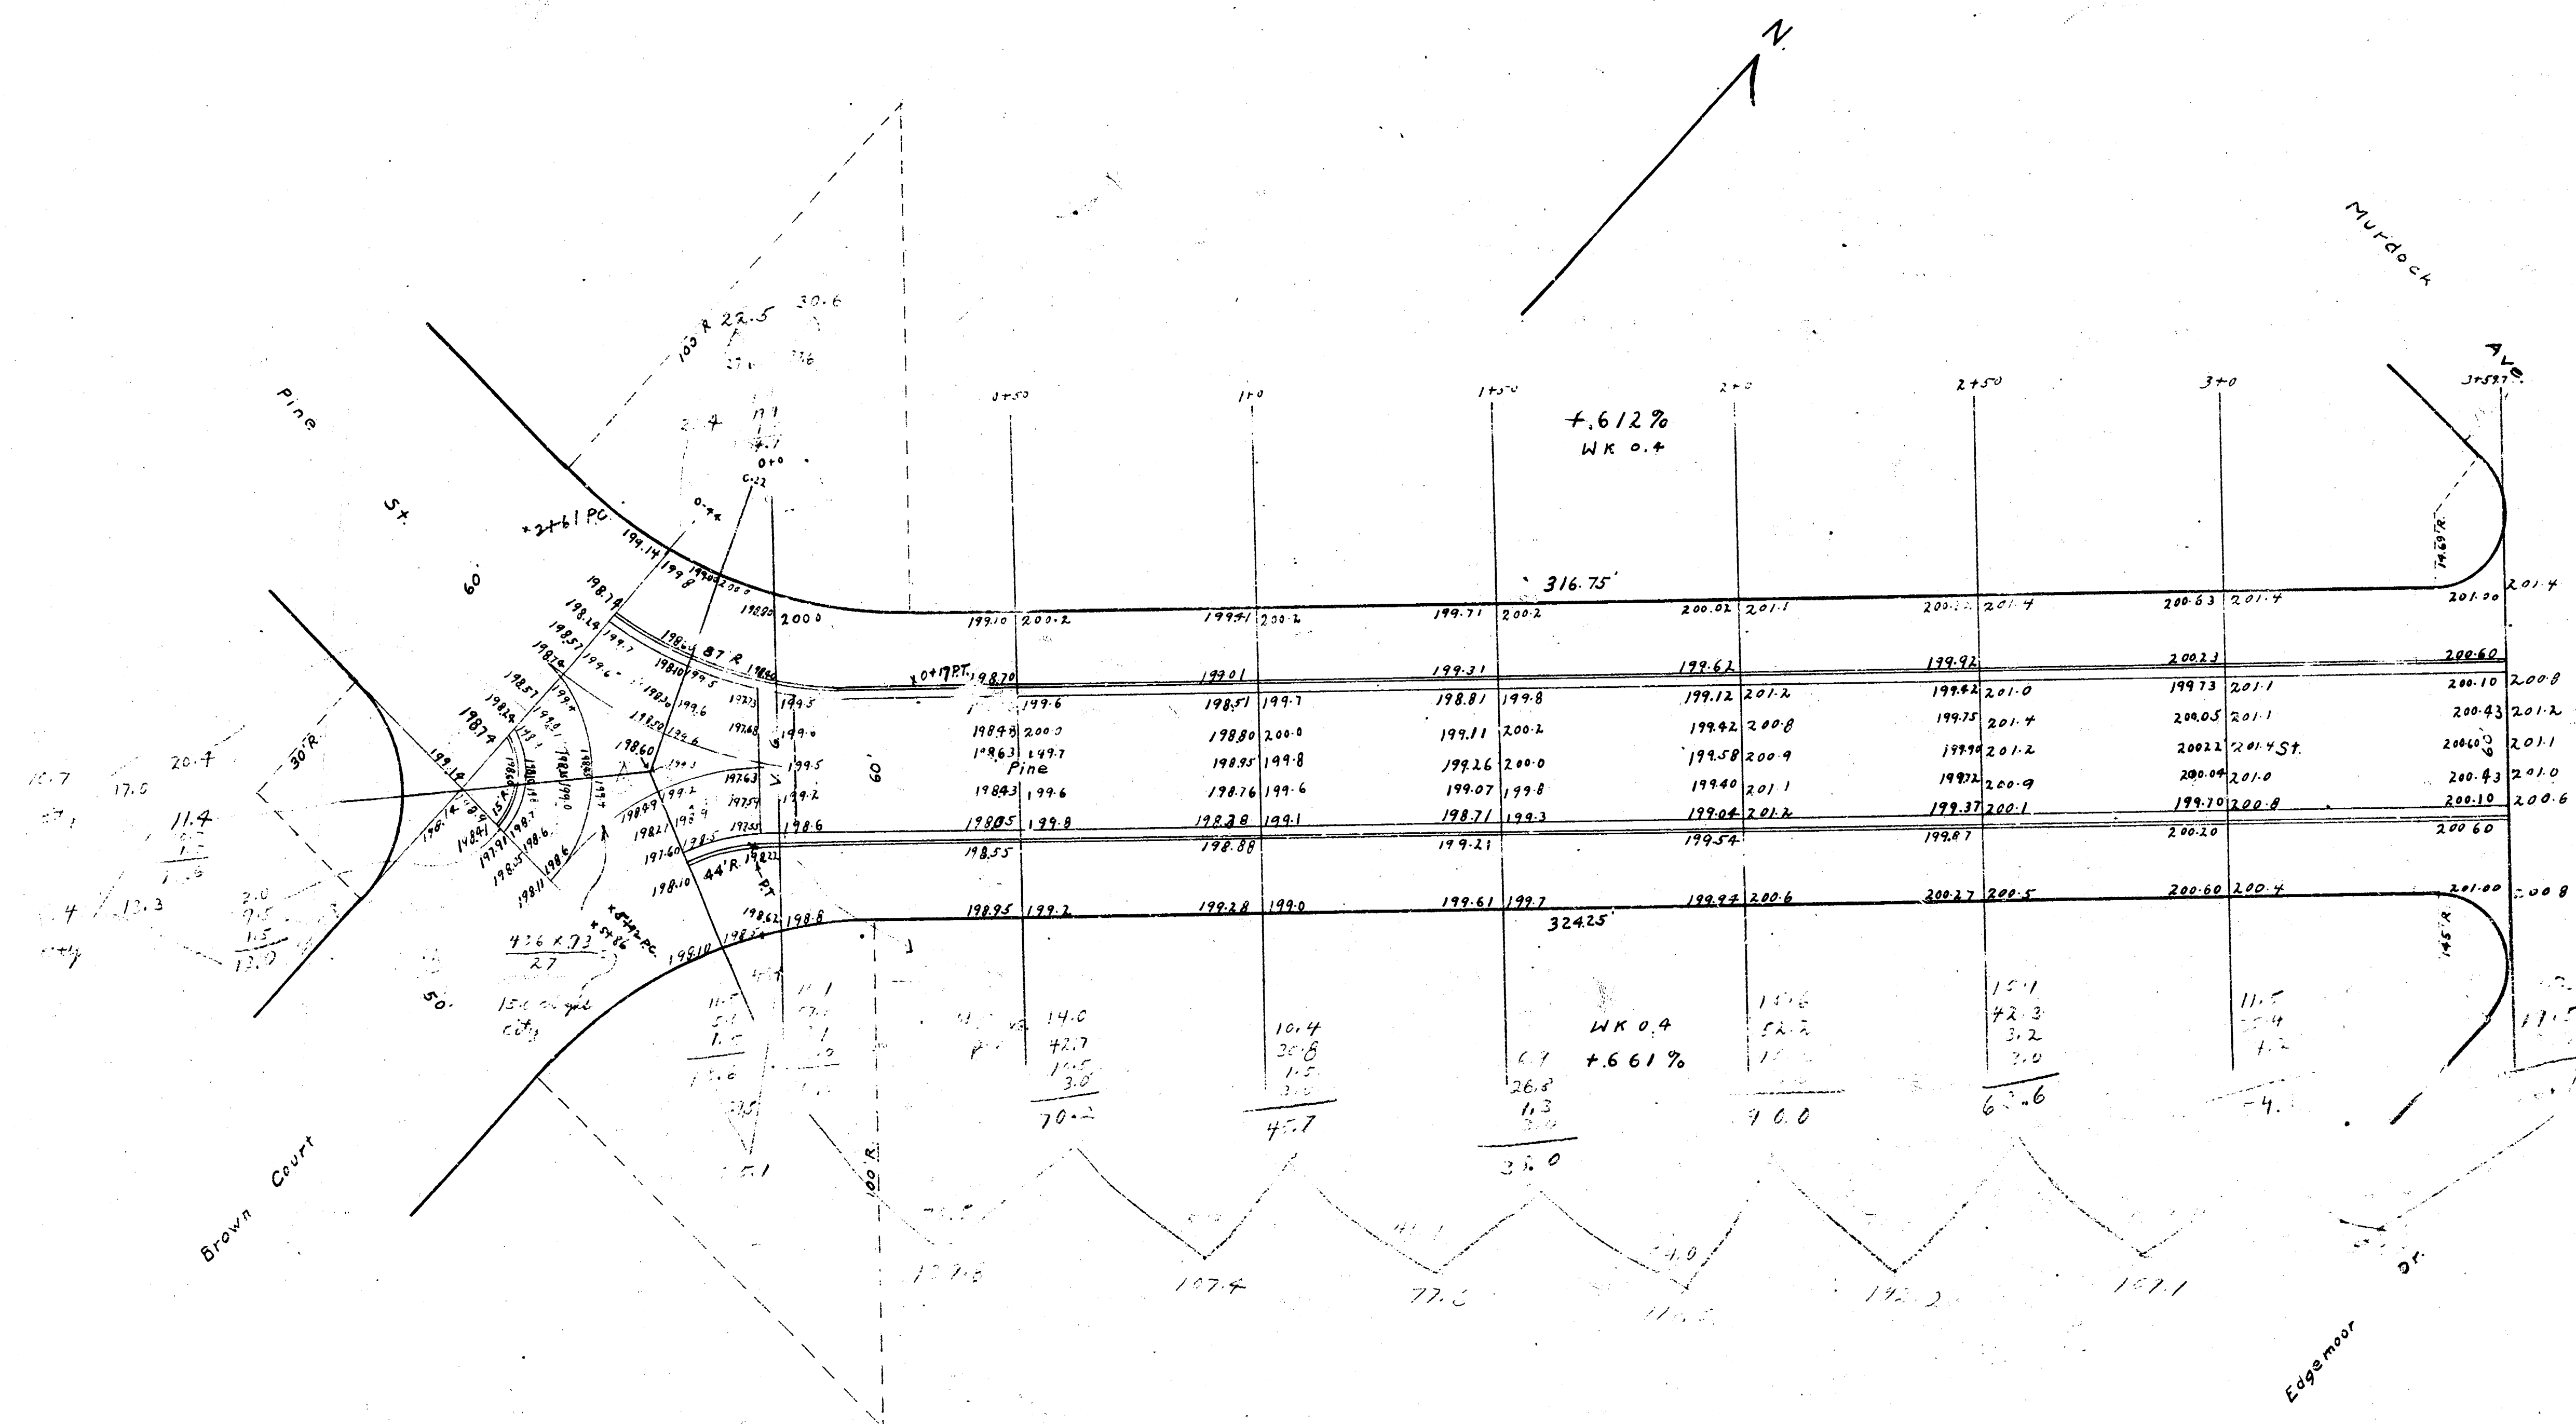

3