PINE AVE. — W.L. BATTIN TO E.L. HARDING

Curb & Gutter only
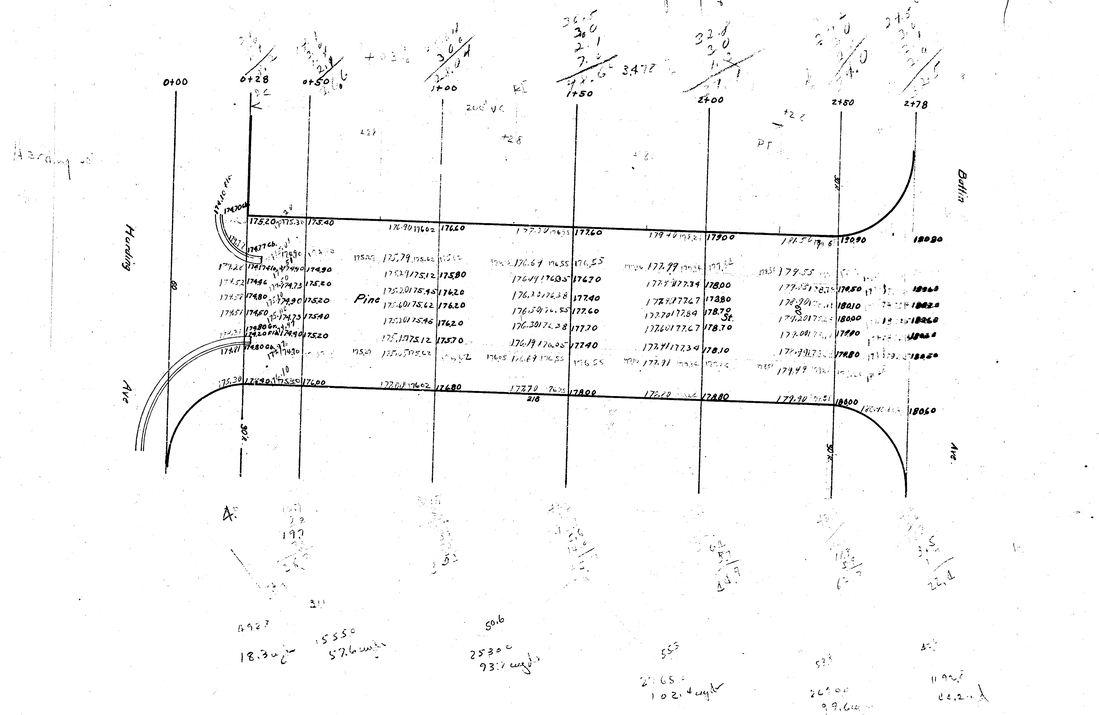
BM. Elev. 174.75 S.W. coping of culvert on Subway E. of Blackley Avenue