


B.M. 200.60 G in Globe W. Ch. Pine St. Murdock
 B.M. 203.10 T in Hwy Top Hyd. N.E. Cor. Old Manor & Pine St.

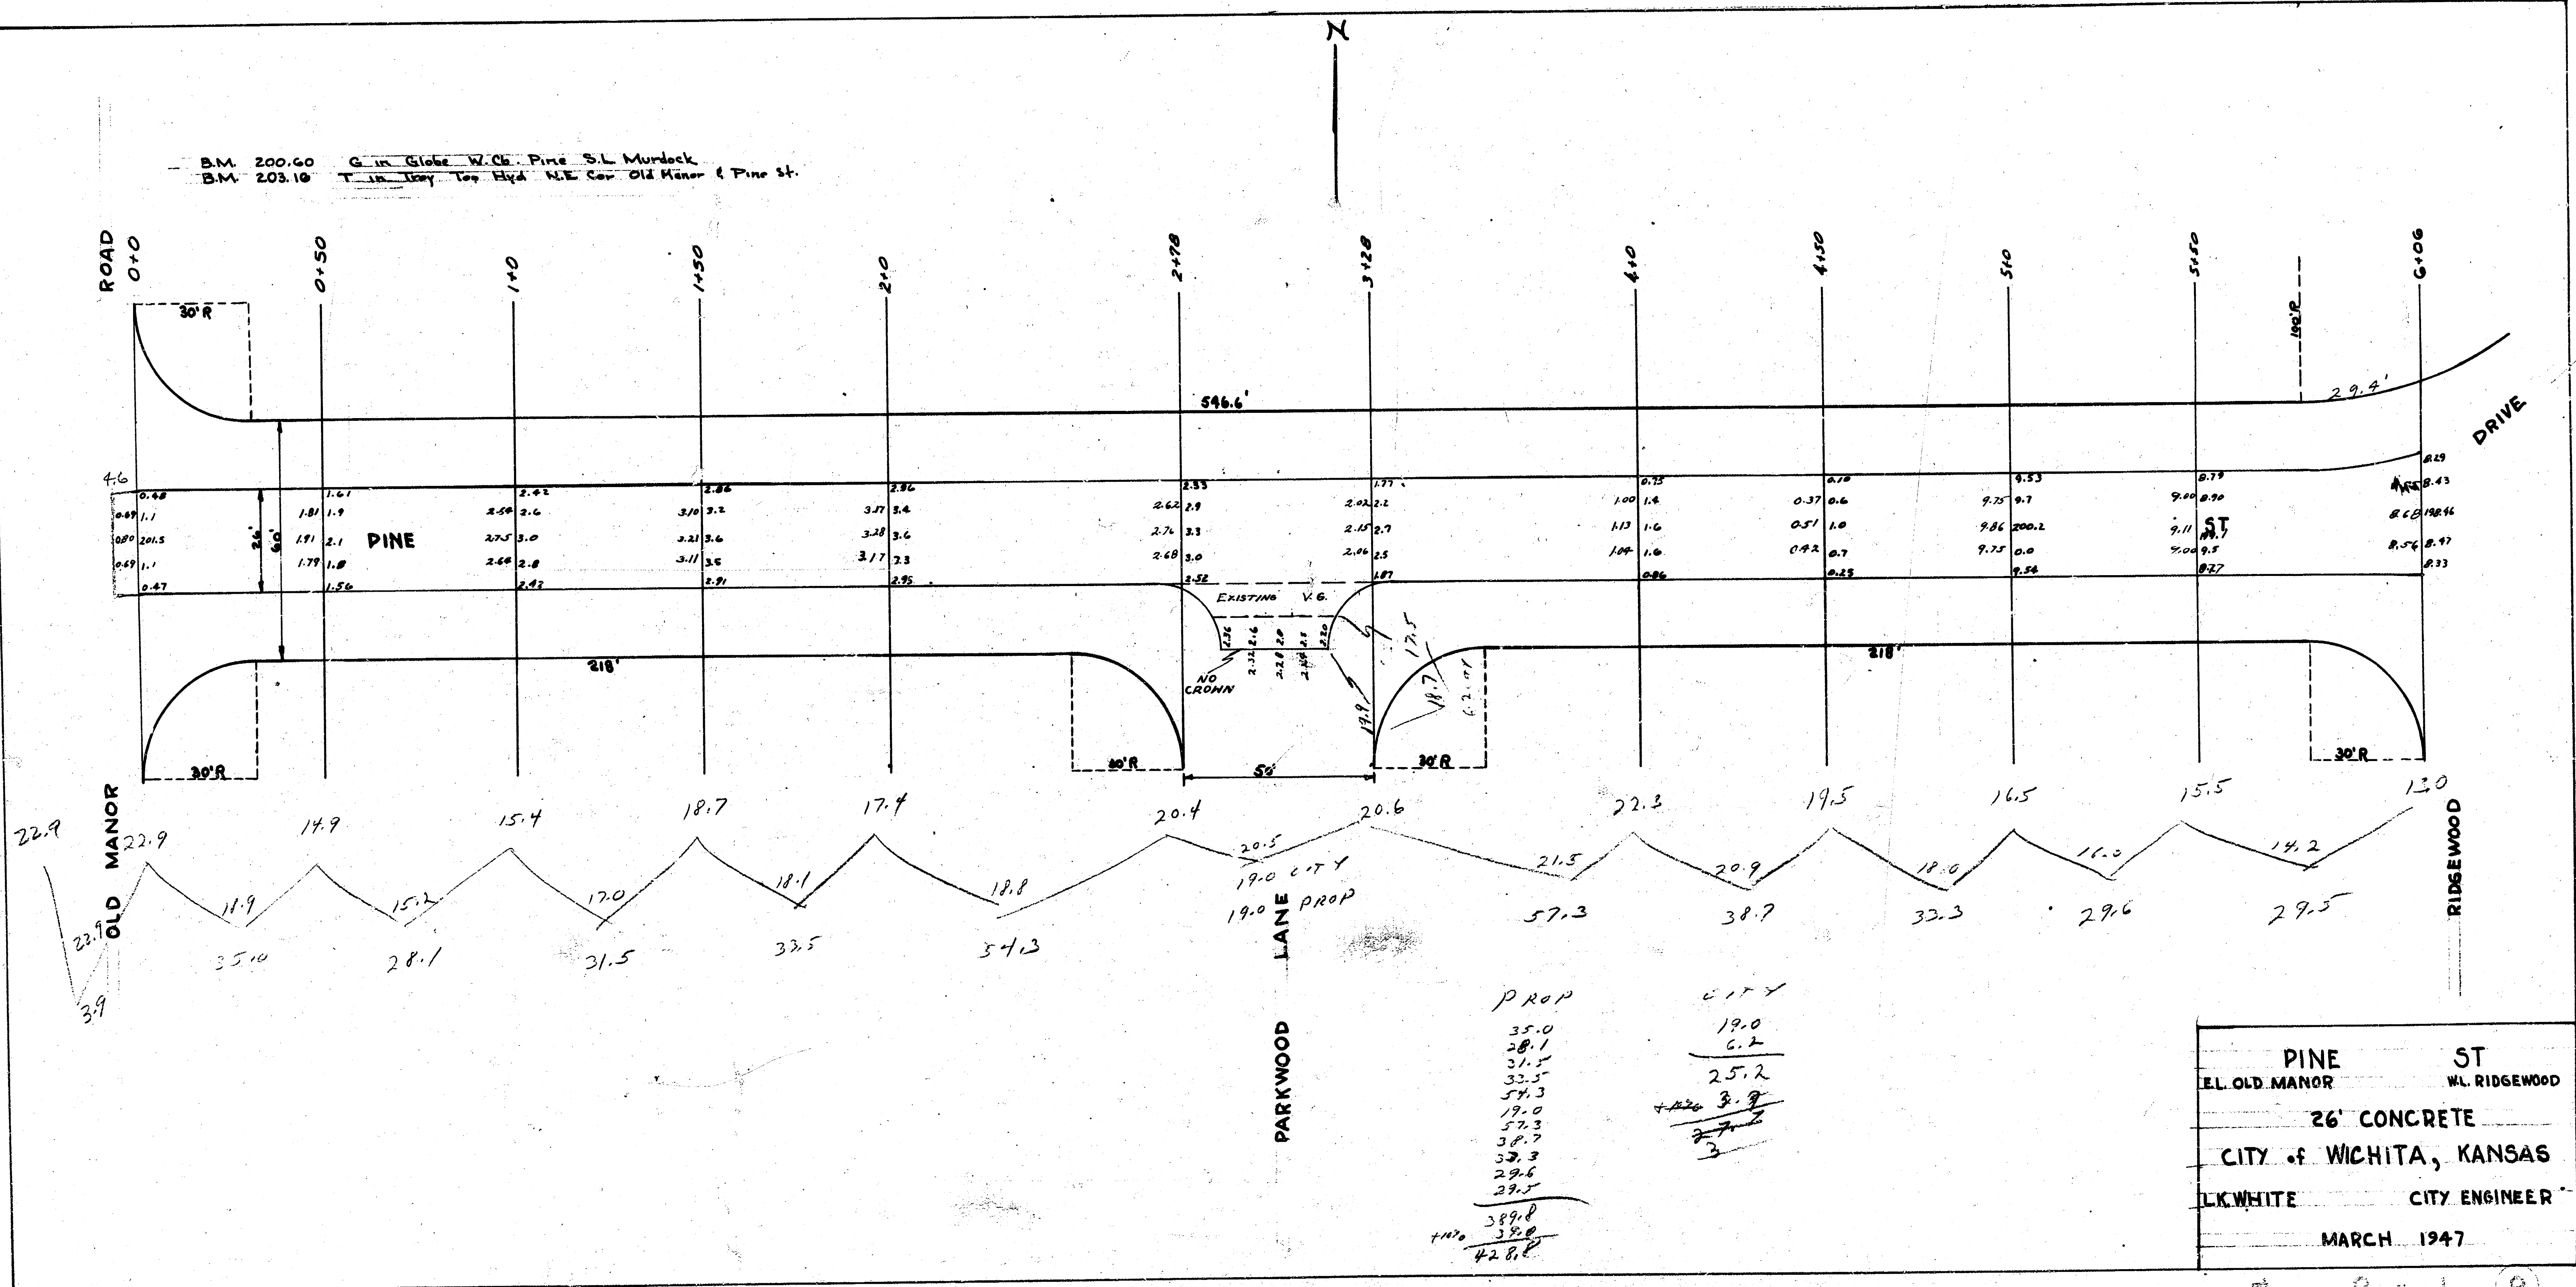

PINE ST
 EL. OLD MANOR WL. RIDGEWOOD
 26' CONCRETE
 CITY OF WICHITA, KANSAS
 LK WHITE CITY ENGINEER
 MARCH 1947