CH.M. 81

Exc.

Prop.	City
4075.6	372.0 yd³
+10% 407.6	+10% 37.2
4483.2	409.2

BM. 126.91 S. Rim M.H. 150' E. of Elpyco, 150' N. of Blake.
BM. 121.55 "R" in Richie N. Cb. Blake, W.L. Pinecrest
BM. 129.80 "H" in Harris c. wk. N. N.E. Pinecrest & Kinkaid

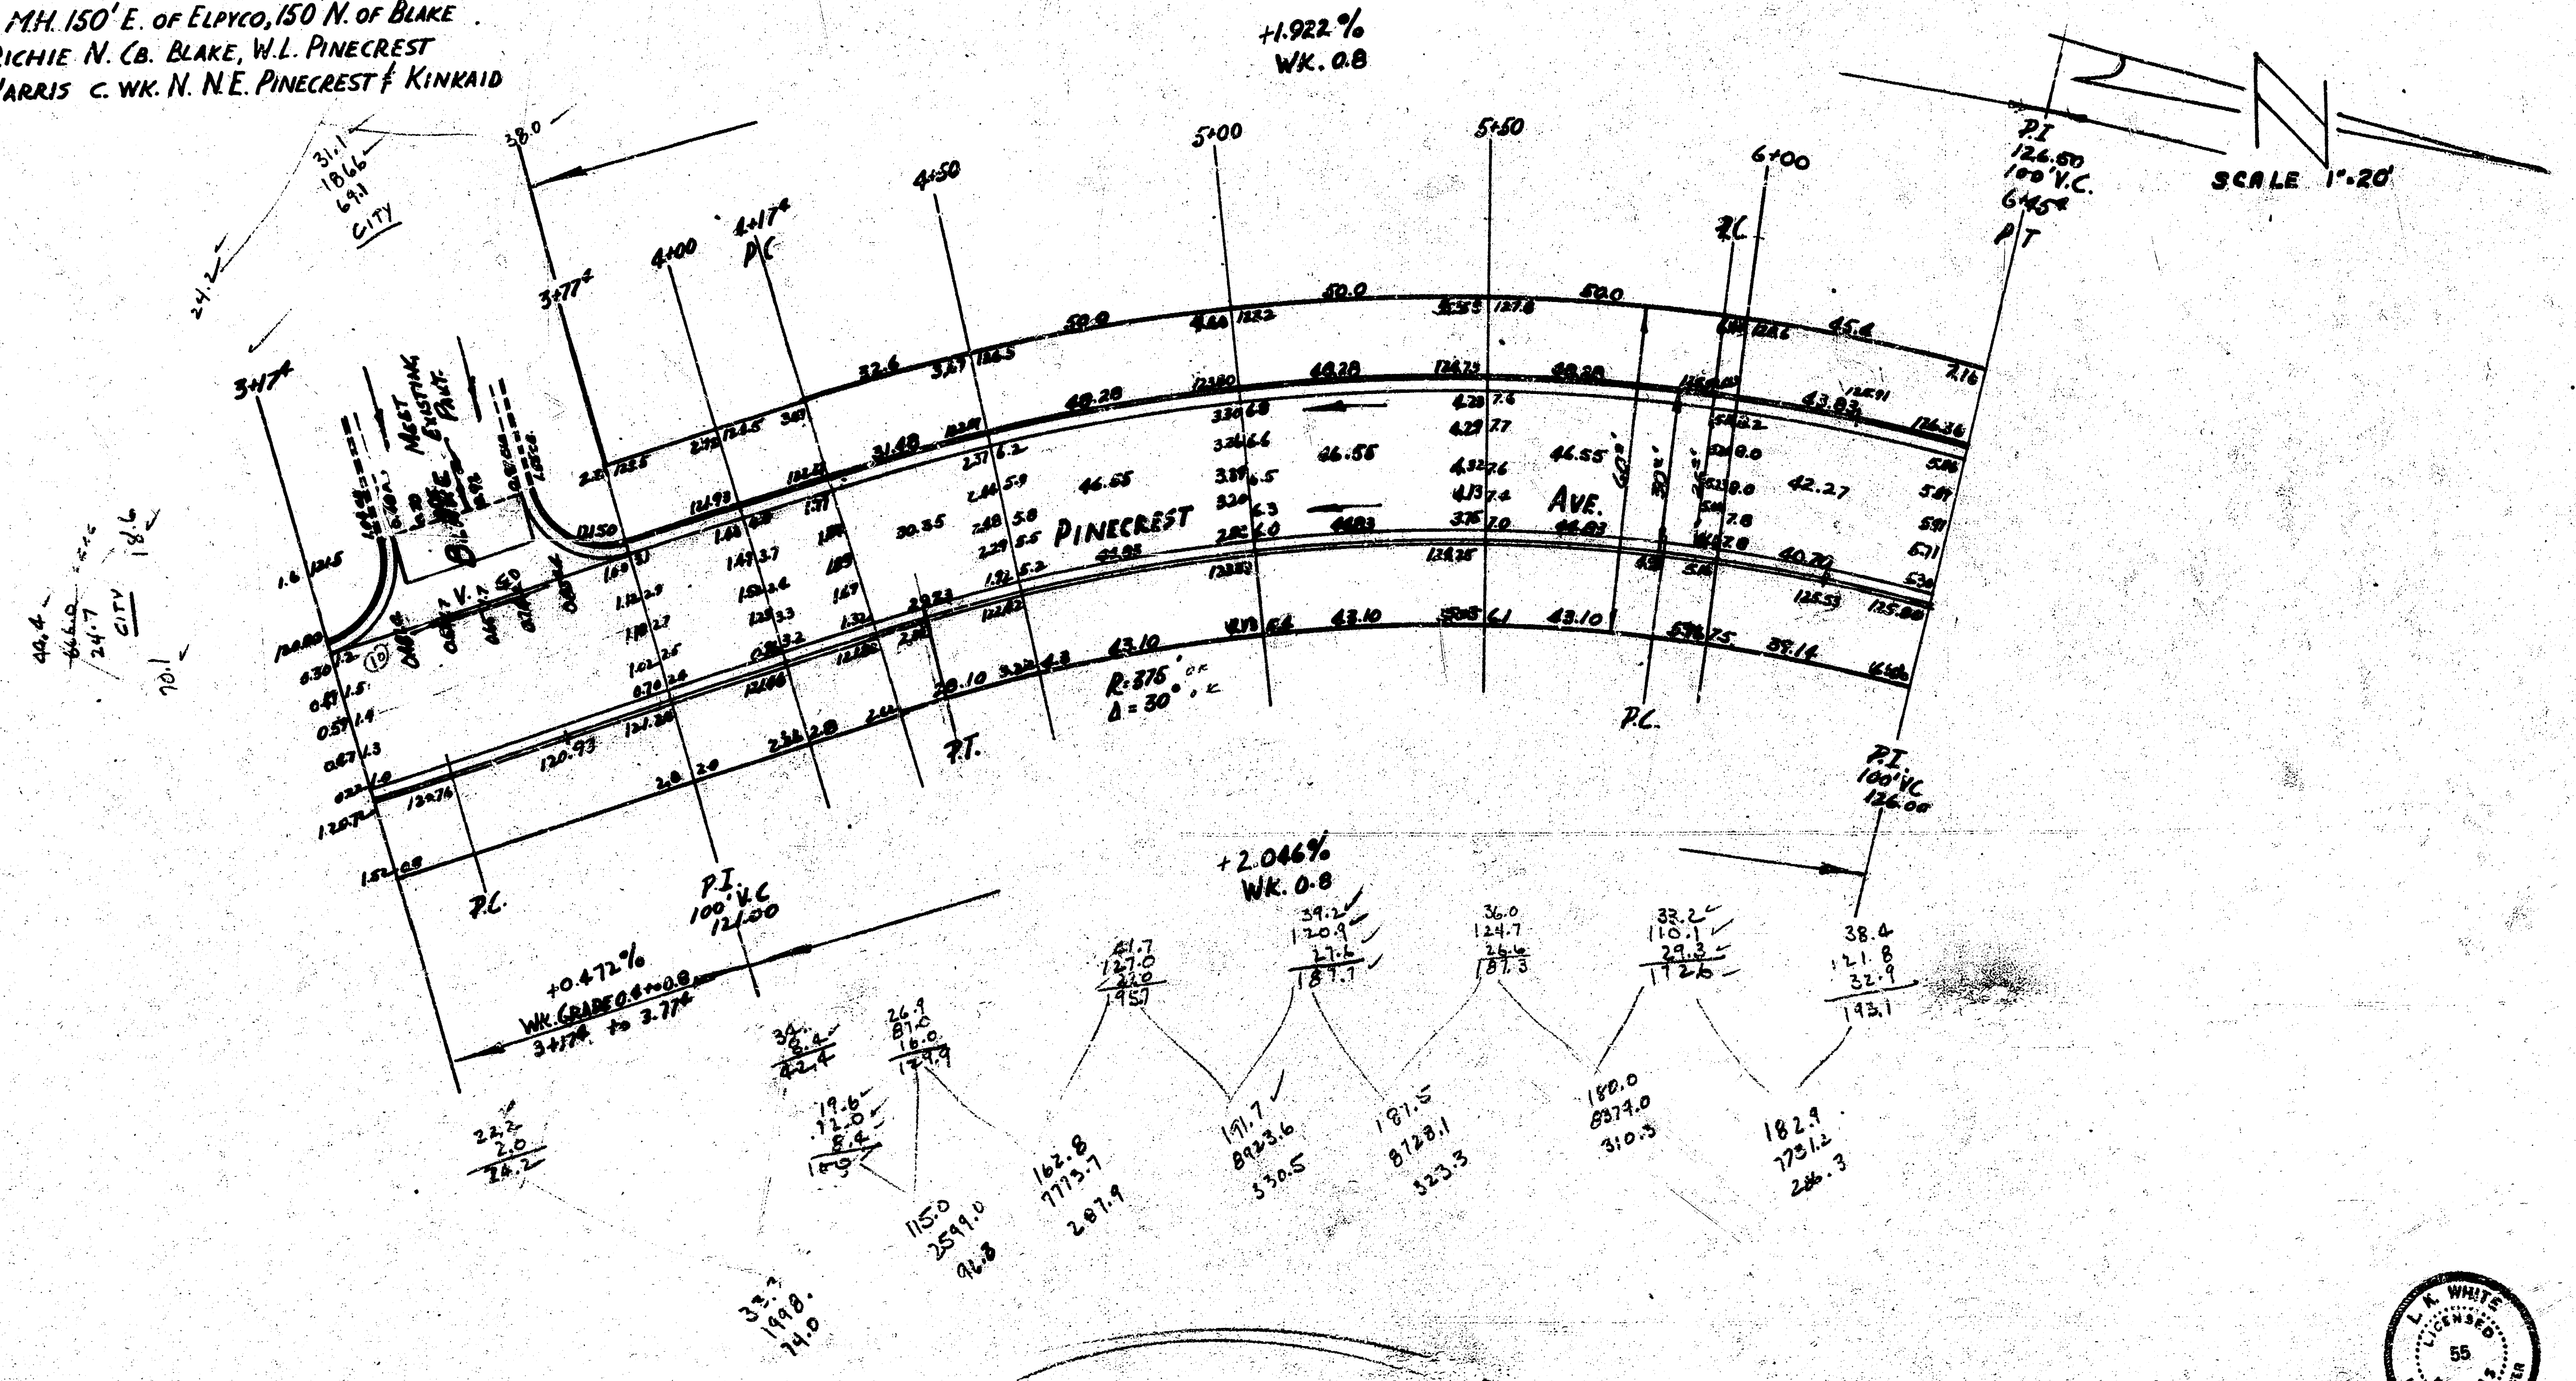

NOTE: STATIONING ON S. & W. R.

1/2

L.K. WHITE 55

PINECREST AVE.
SL BLAKE TO NL KINKAID
26-2-30 AC.
CITY OF WICHITA, KANSAS
LK WHITE CITY ENGINEER
JAN. 22, 1952 PROJ. NO. CII-196

Roads 81

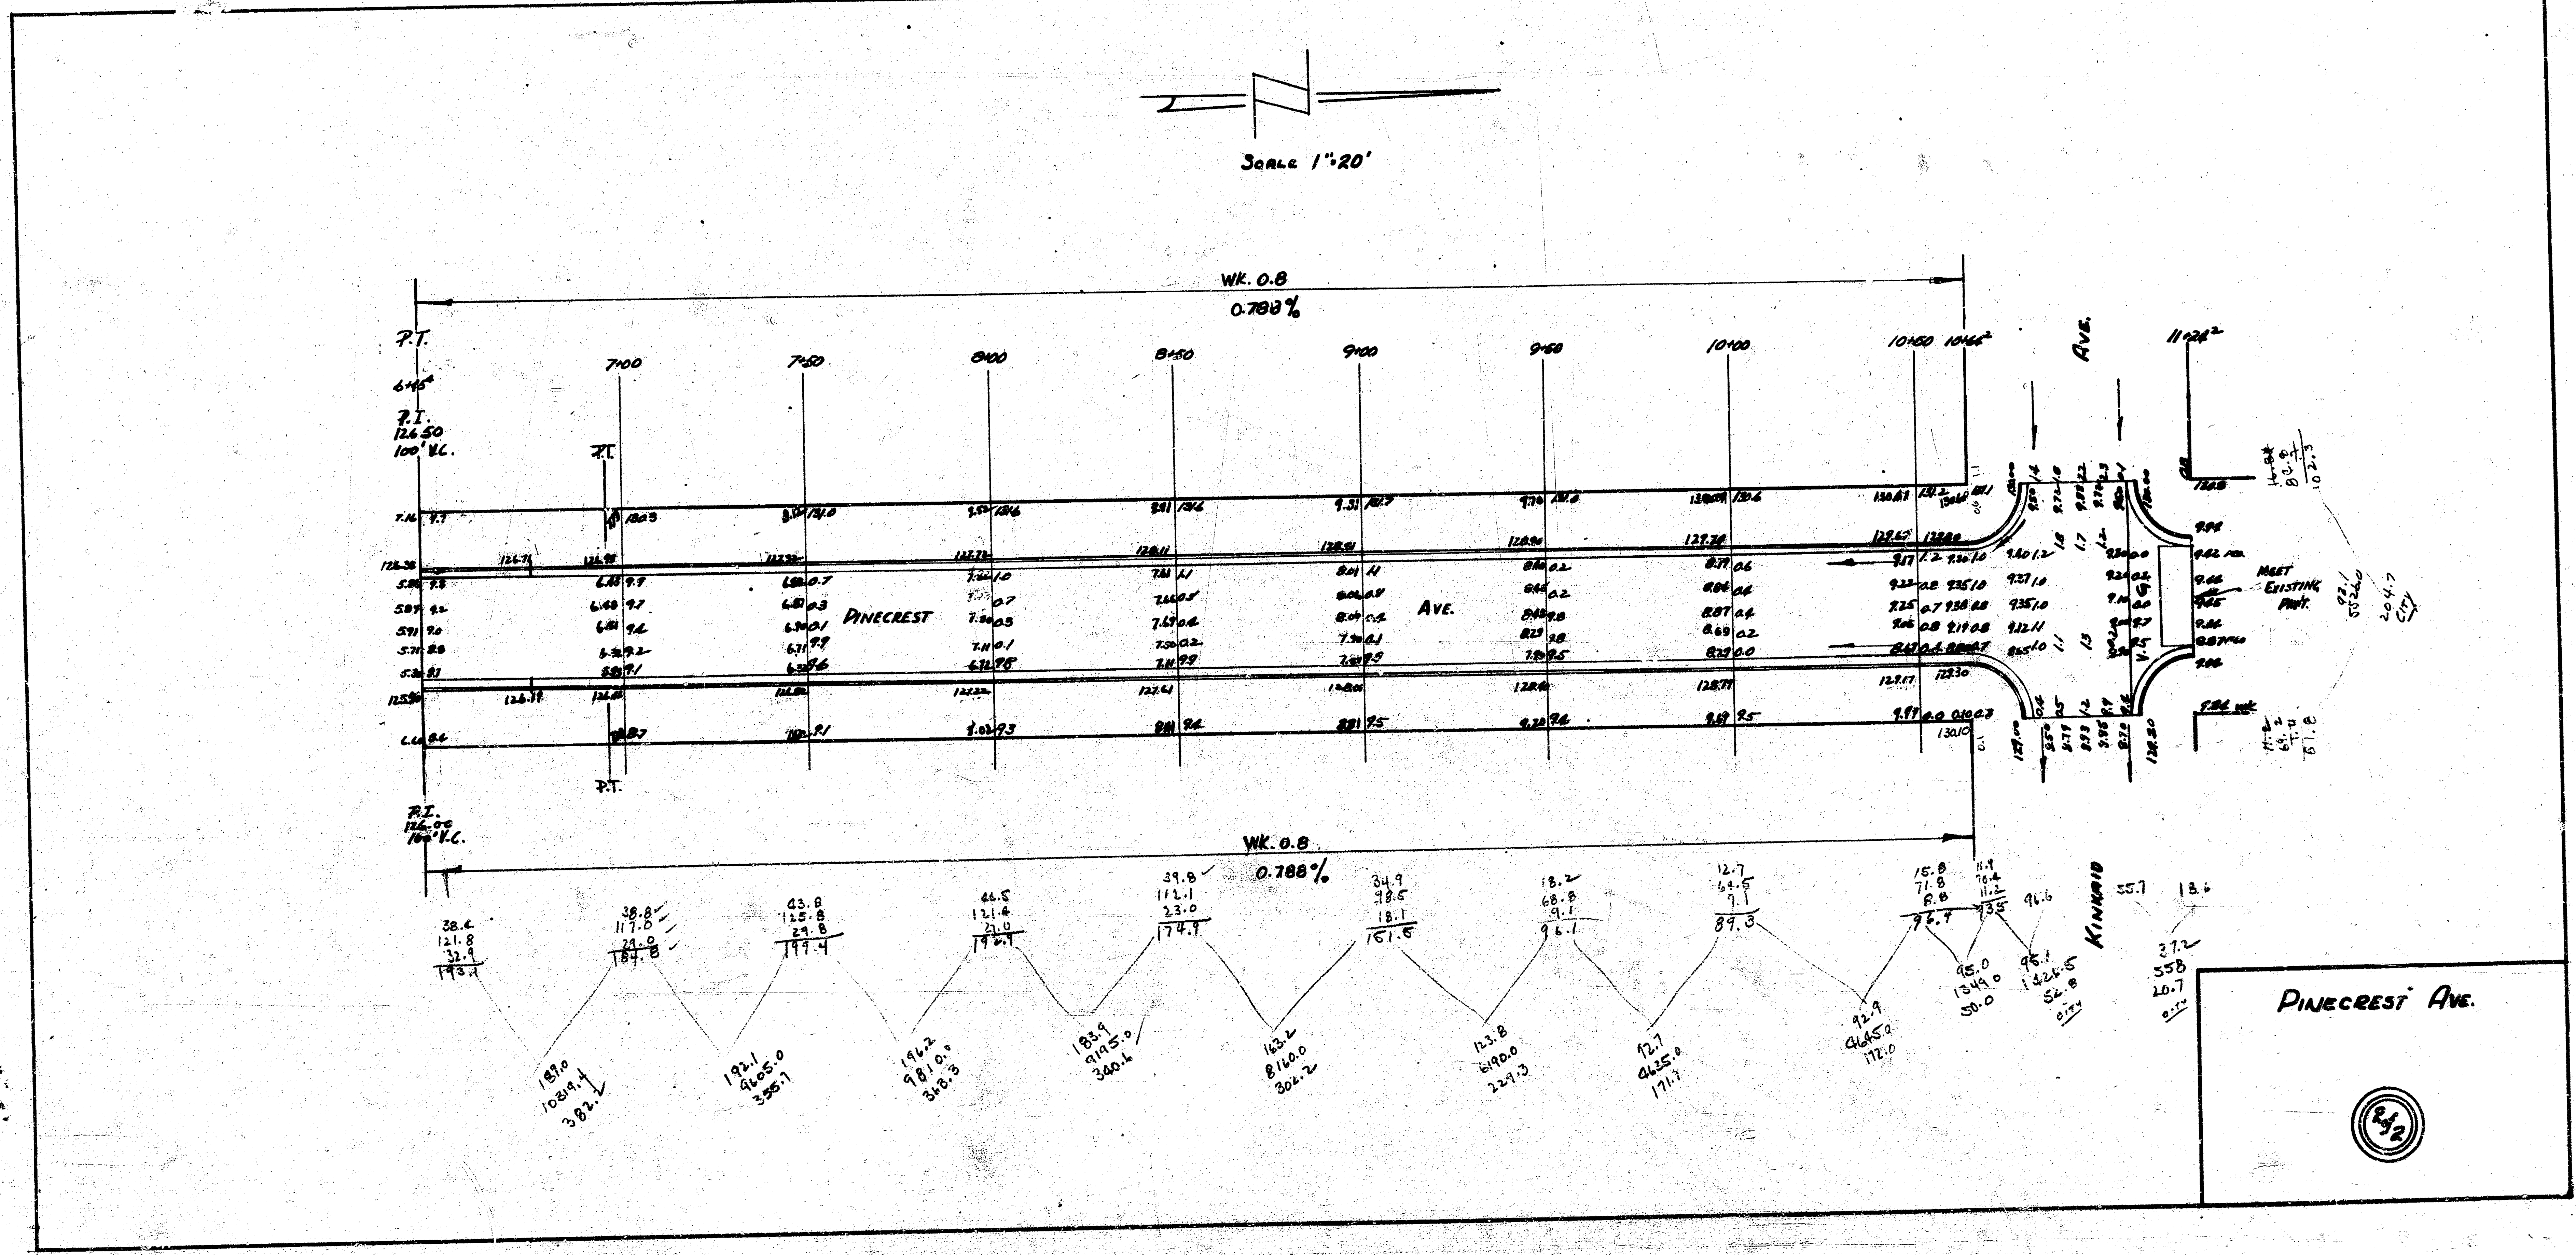

PINECREST AVE.

2 of 2

CH M. 81

EXCAV.
343 yd 3
+10% 34.03
377.3

FILL
429 yd 3
+10% 42.9
471.9

B.M. 126.91 S. RIM MH 150' E OF ELPYCO. 150' N. OF BLAKE
B.M. 121.55 "R" IN RITCHIE N. CB. BLAKE, W.L PINECREST
B.M. 129.80 "H" IN HARRIS C. WK. N.N.E. PINECREST

N

SCALE: 1"=20'

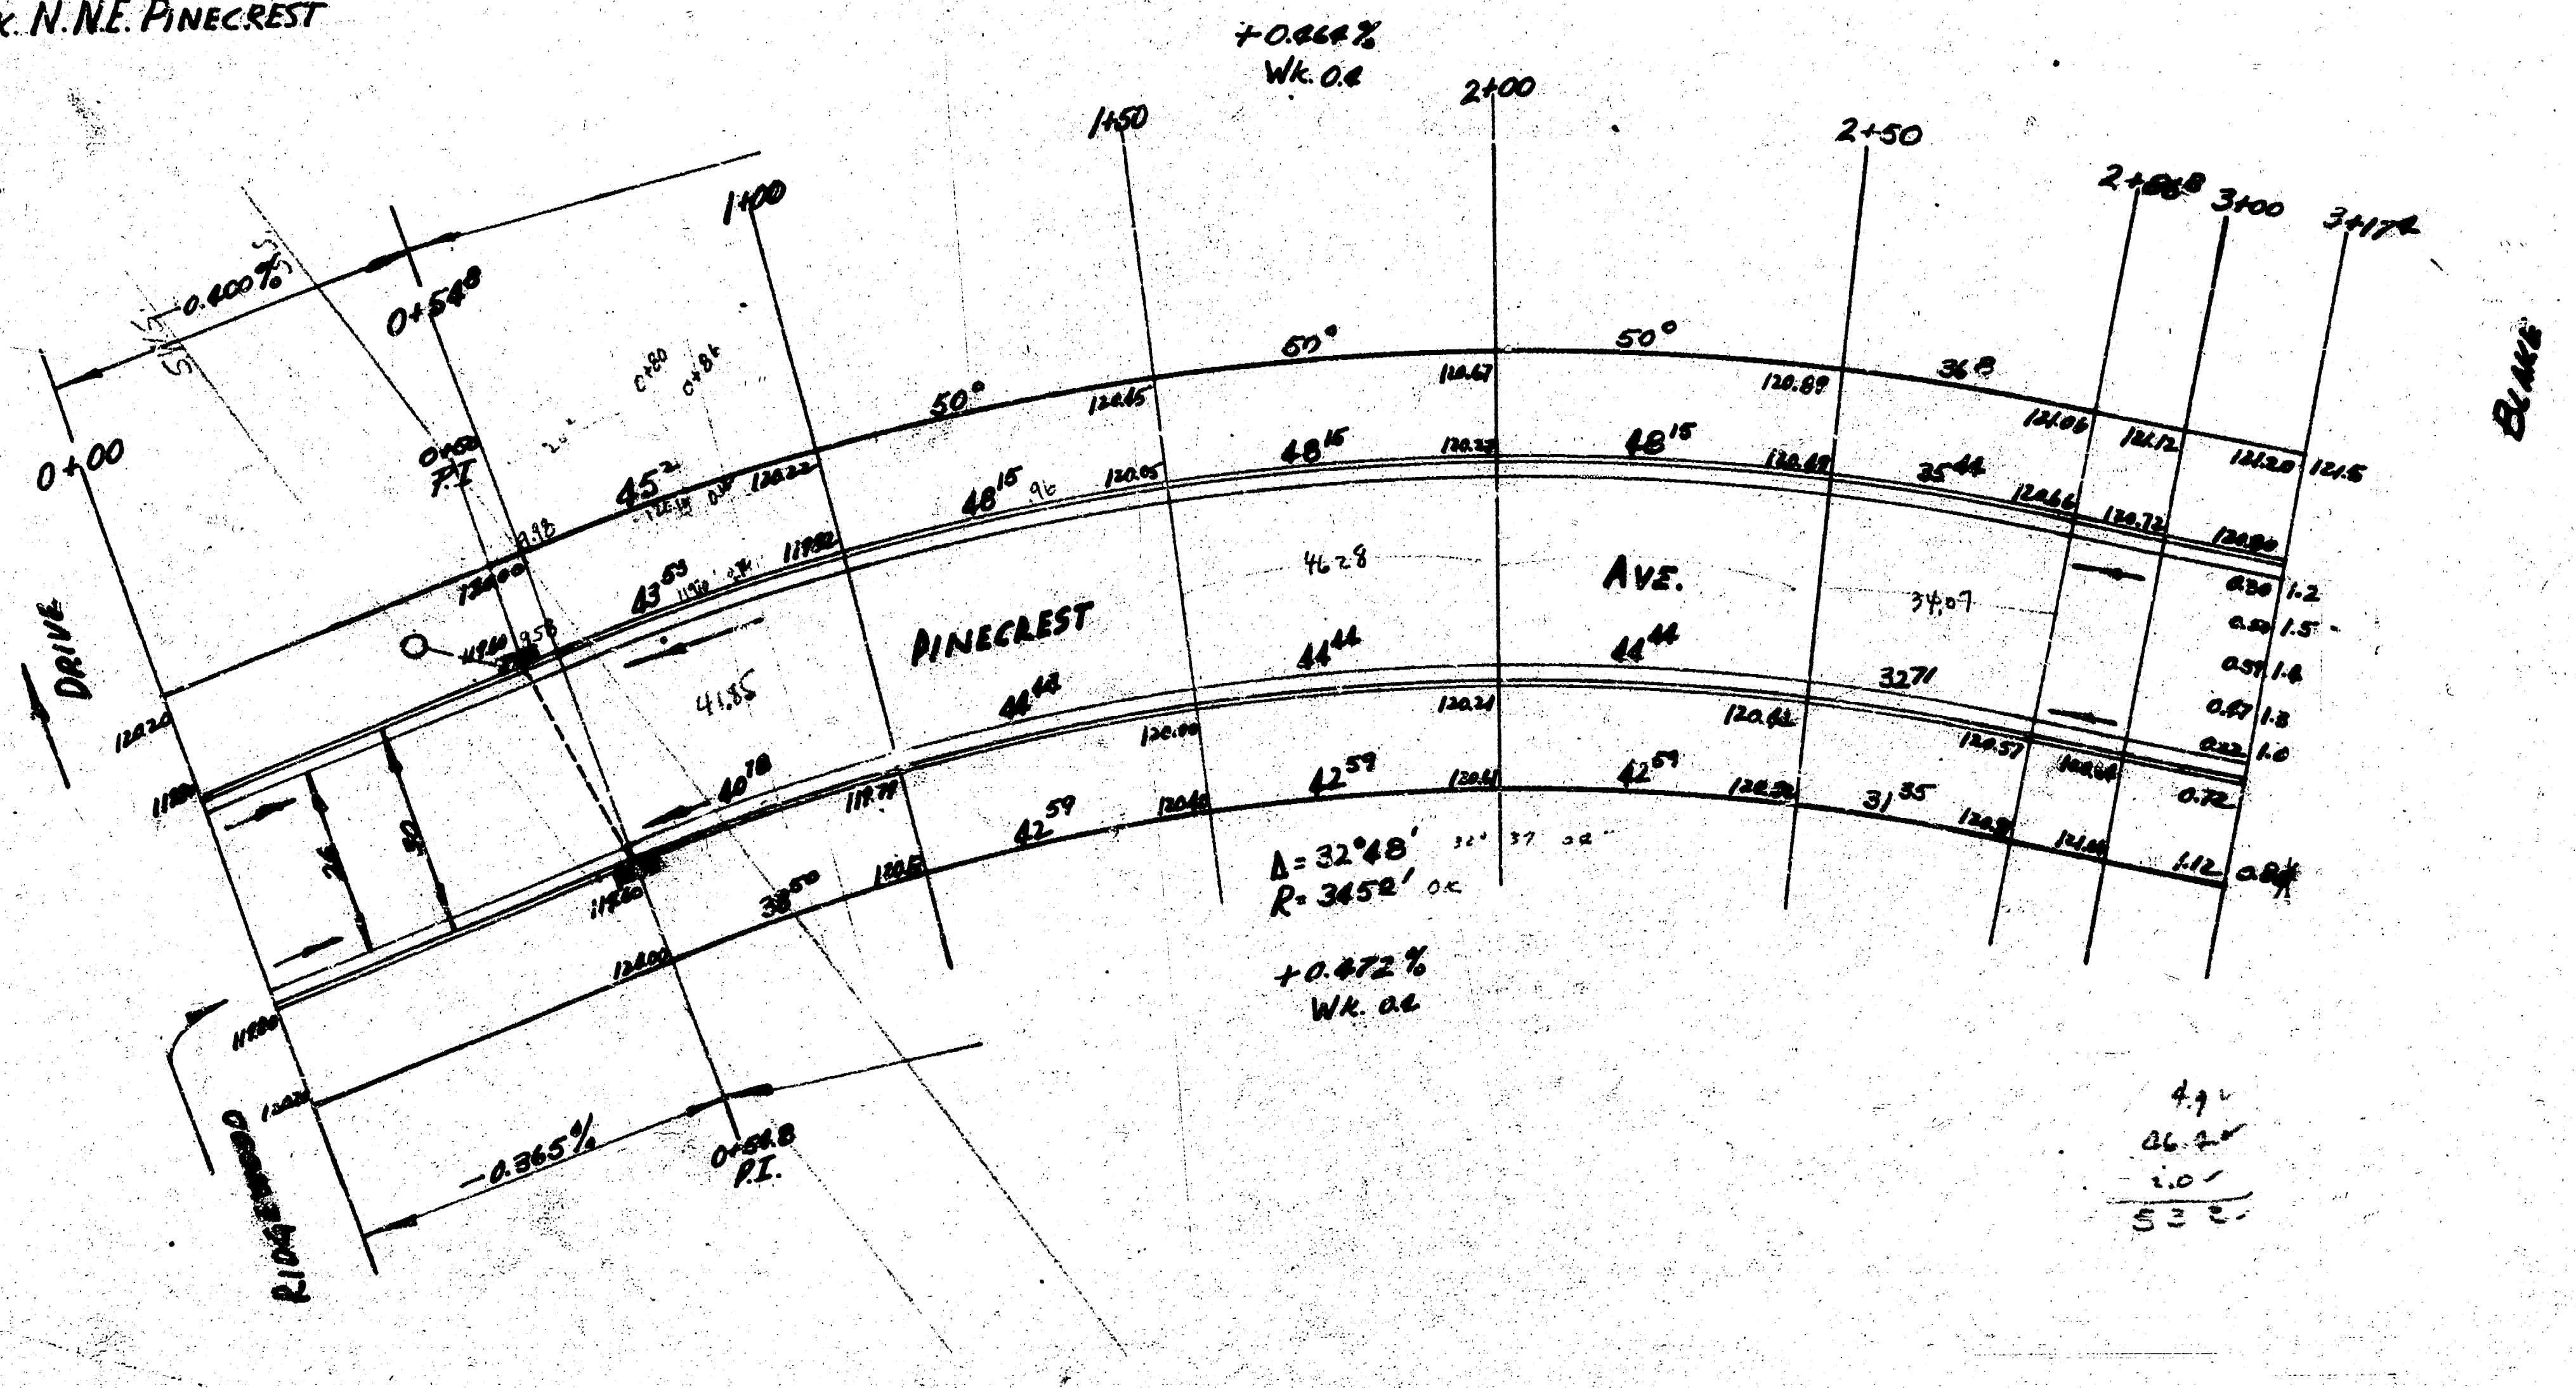

NOTE: STATION ON S & W. R

L.K. WHITE
LICENSED
55
KANSAS

PINECREST AVE
W.L. RIDGEWOOD TO S.L. BLAKE
26-2-30 A.C.

CITY OF WICHITA, KANSAS
L.K. WHITE CITY ENGINEER
JUNE 2, 1952 PROJ. NO. C 12-69

Book 38Y Pages 25-27

Intersection of Larry Lane + Pinecrest Book 38Y Page

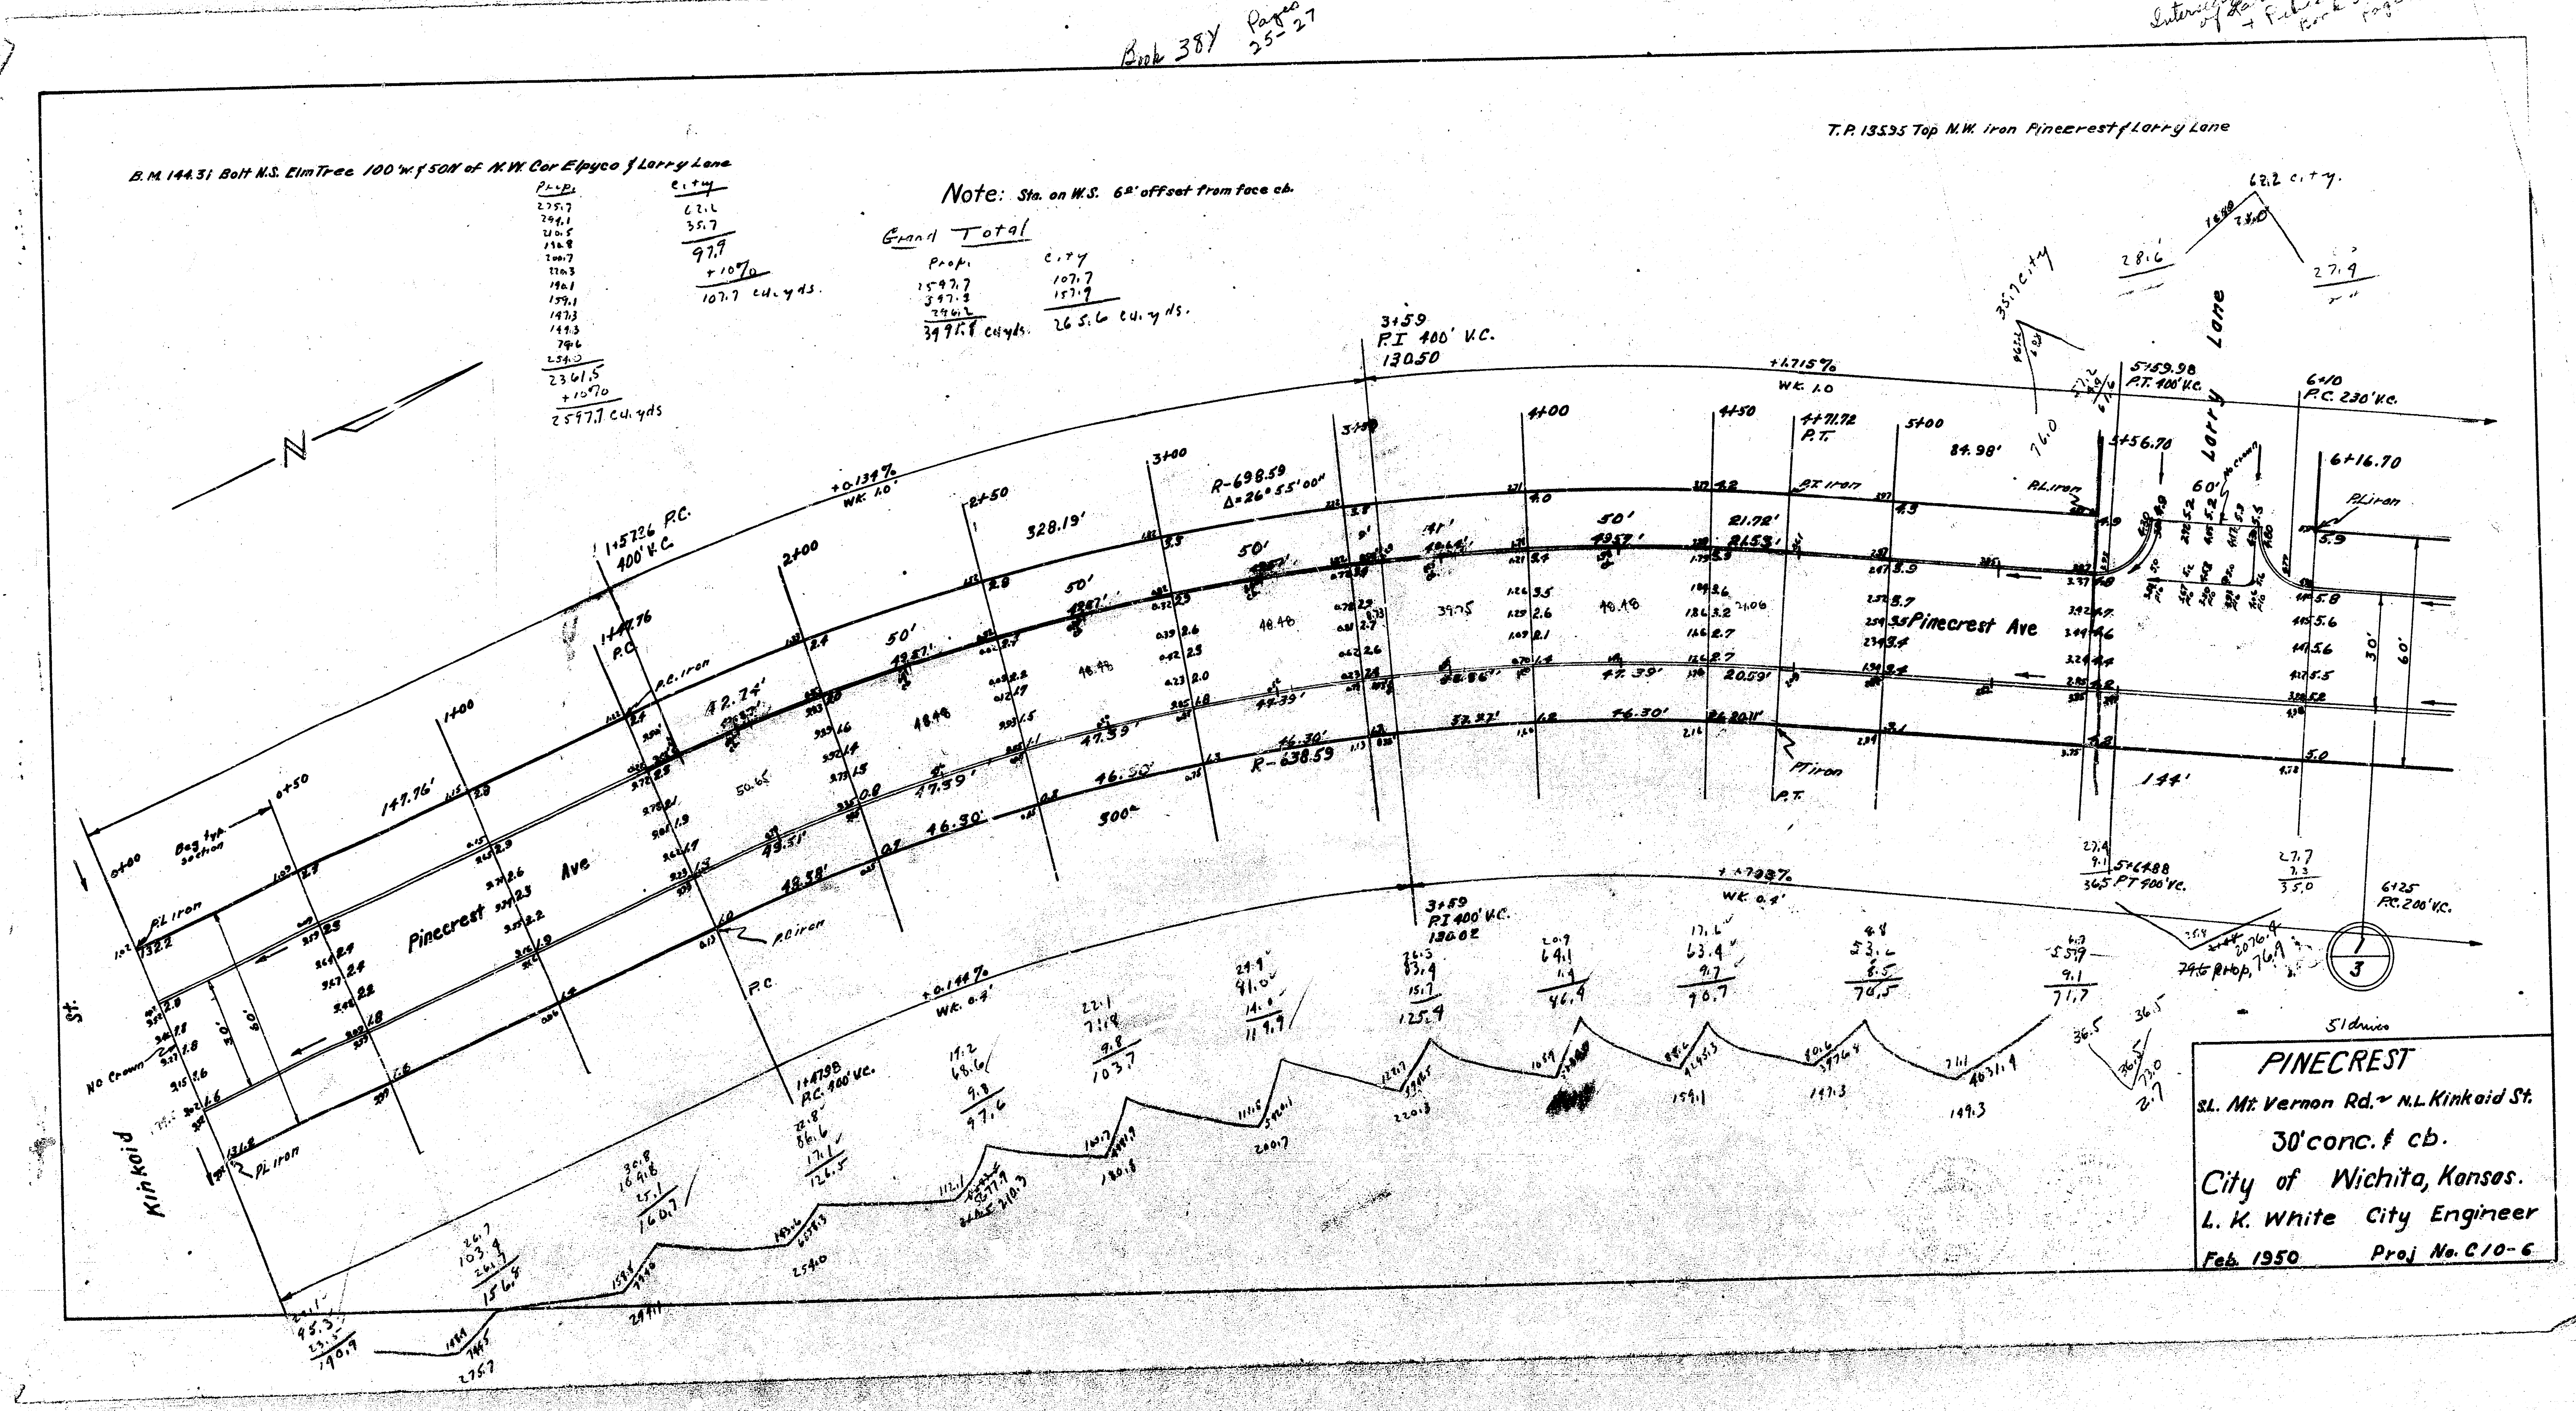

PINECREST

S.L. Mt. Vernon Rd. to N.L. Kinkaid St.

30' conc. & cb.

City of Wichita, Kansas.

L. K. White City Engineer

Feb. 1950 Proj No. C10-6

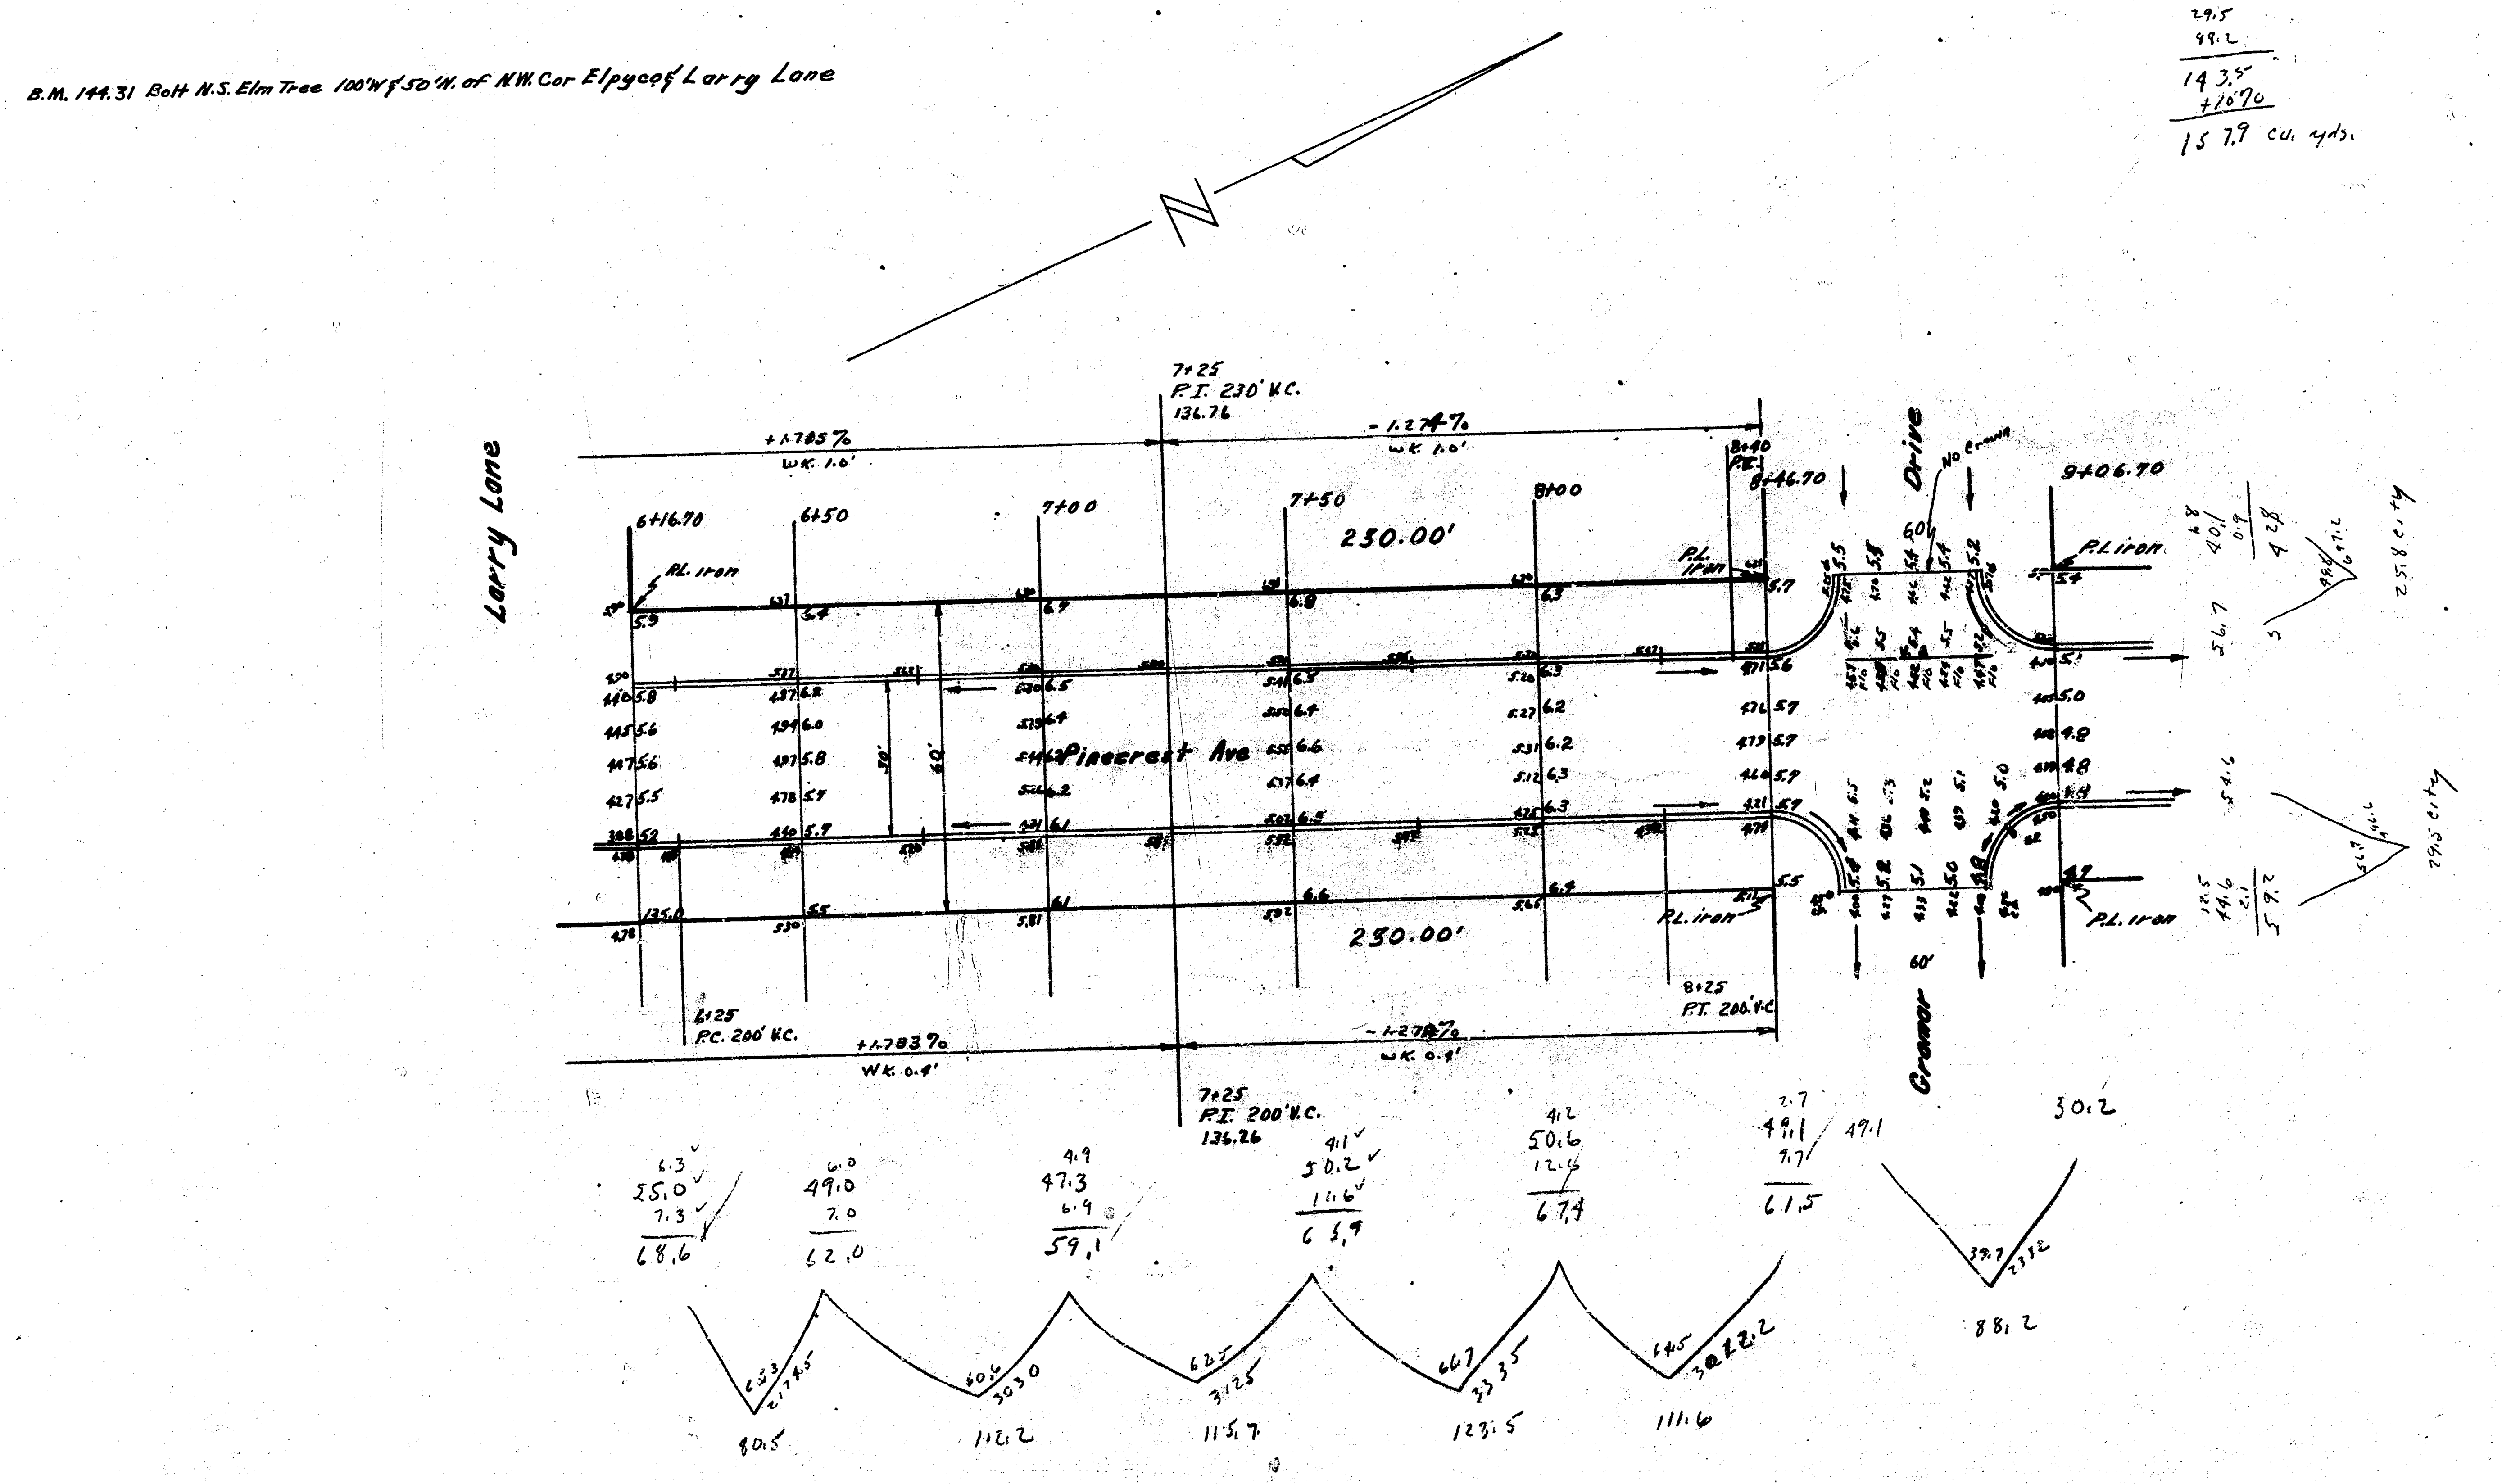

City
25.8
29.5
98.2
143.5
+1070
157.9 cu. yds.

Property
80.5
112.2
115.7
123.5
111.6
543.5
+1070
597.9 cu. yds.

Total
597.9
157.9
755.8 cu. yds.

B.M. 144.31 Bolt N.S. Elm Tree 100' W. & 50' N of N.W. Cor Elpyco & Larry Lane

Note: Sta on ~~W.S.~~ E.S. 6' off set. from face cb.

Property
34.3
9.1
~~0.7~~ 0.7
~~31.5~~ 28.0
~~107.5~~ 95.4
~~86.1~~ 77.0
~~267.3~~ 244.5
+10 70
~~296.2~~ cu. yds.
269.0

Changes in red are corrections to show stationing on E.S. rather than on W.S.

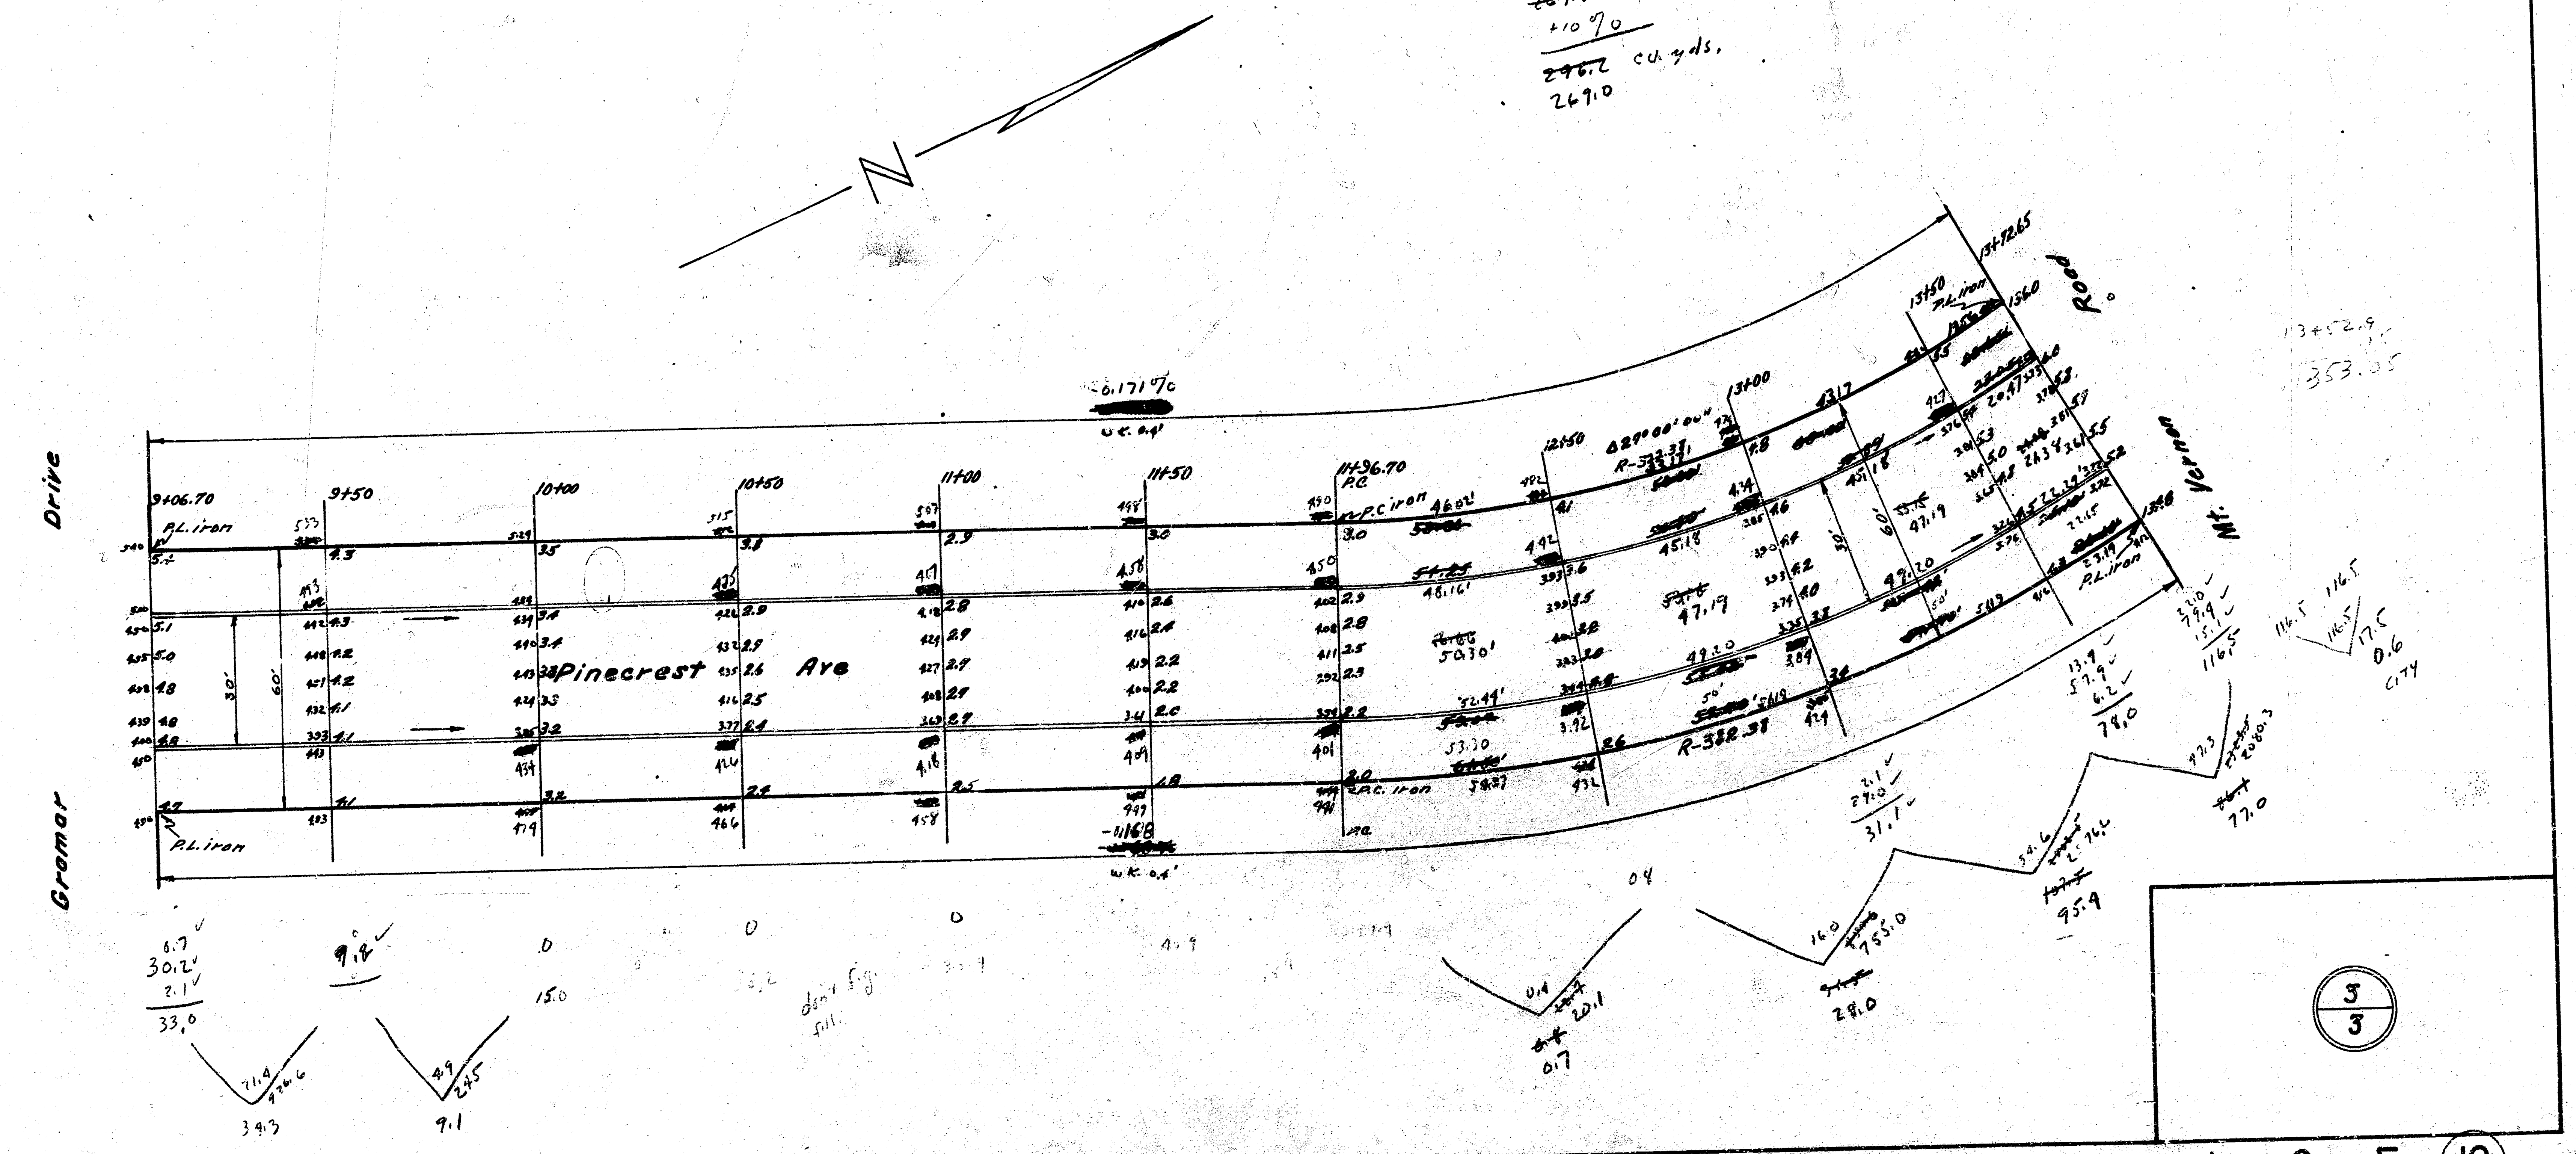

3/3

(16) 2 6 4