


BM. 146.89 Standard SW corner Edgemoor and Harry.

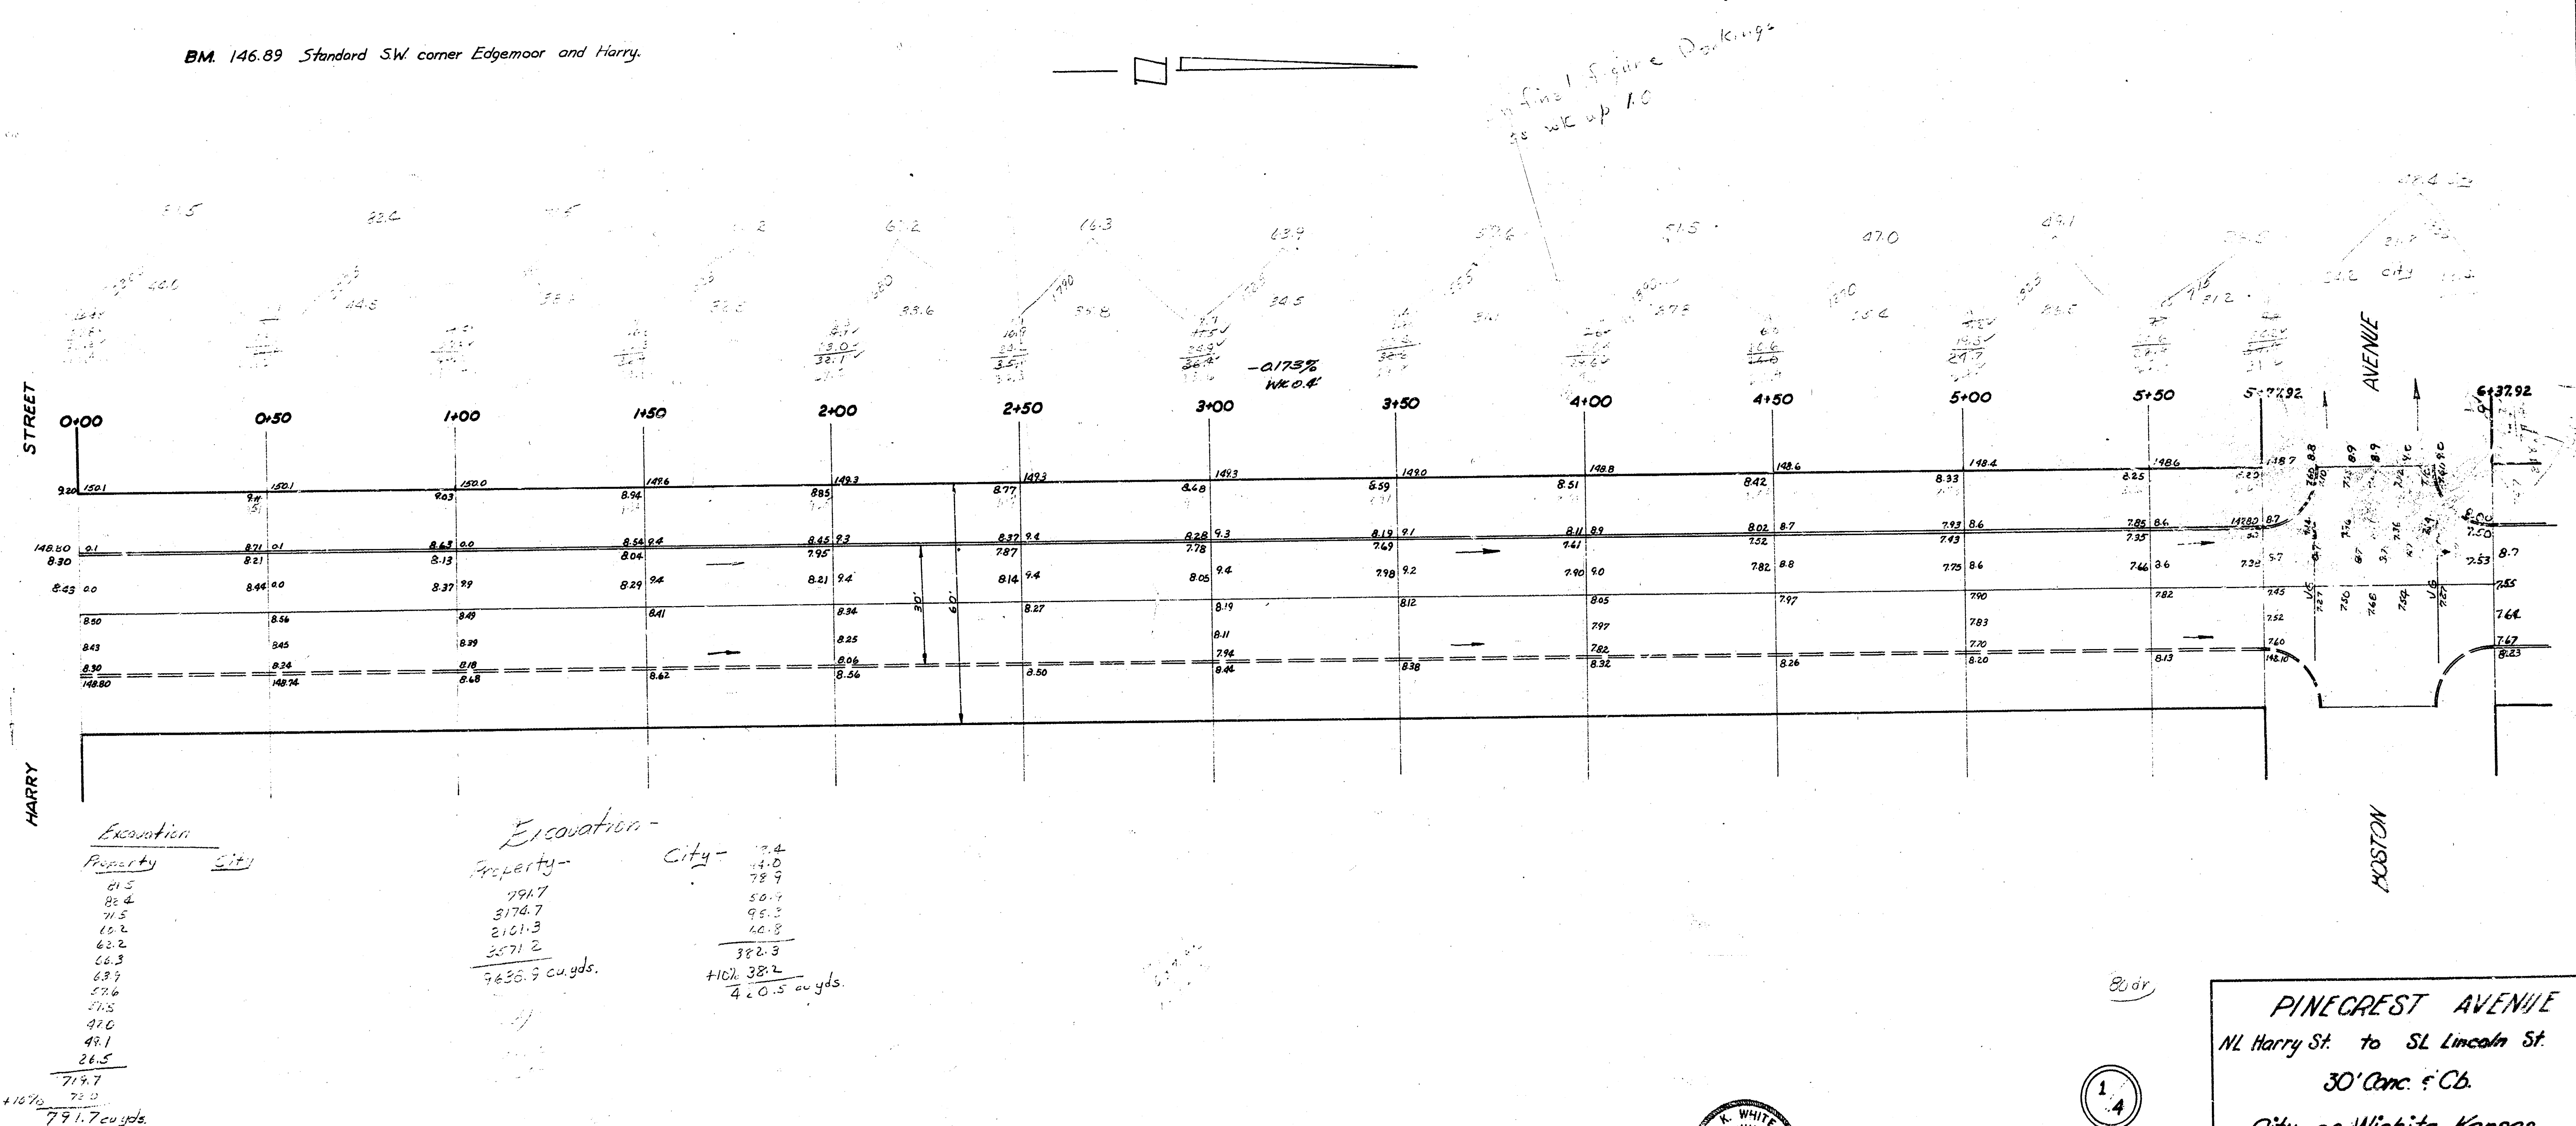

Excavation

Property	City
21.5	7.4
26.4	14.0
71.5	78.7
62.2	50.1
68.3	95.3
69.7	40.8
57.6	382.3
57.5	
47.0	
49.1	
26.5	
719.7	
72.0	
791.7 cu yds.	








1.4

PINECREST AVENUE
N. Harry St. to S. Lincoln St.
30' Conc. & Cb.
City of Wichita Kansas
L.K. White City Engineer
April, 1951 Proj. No. C10-173

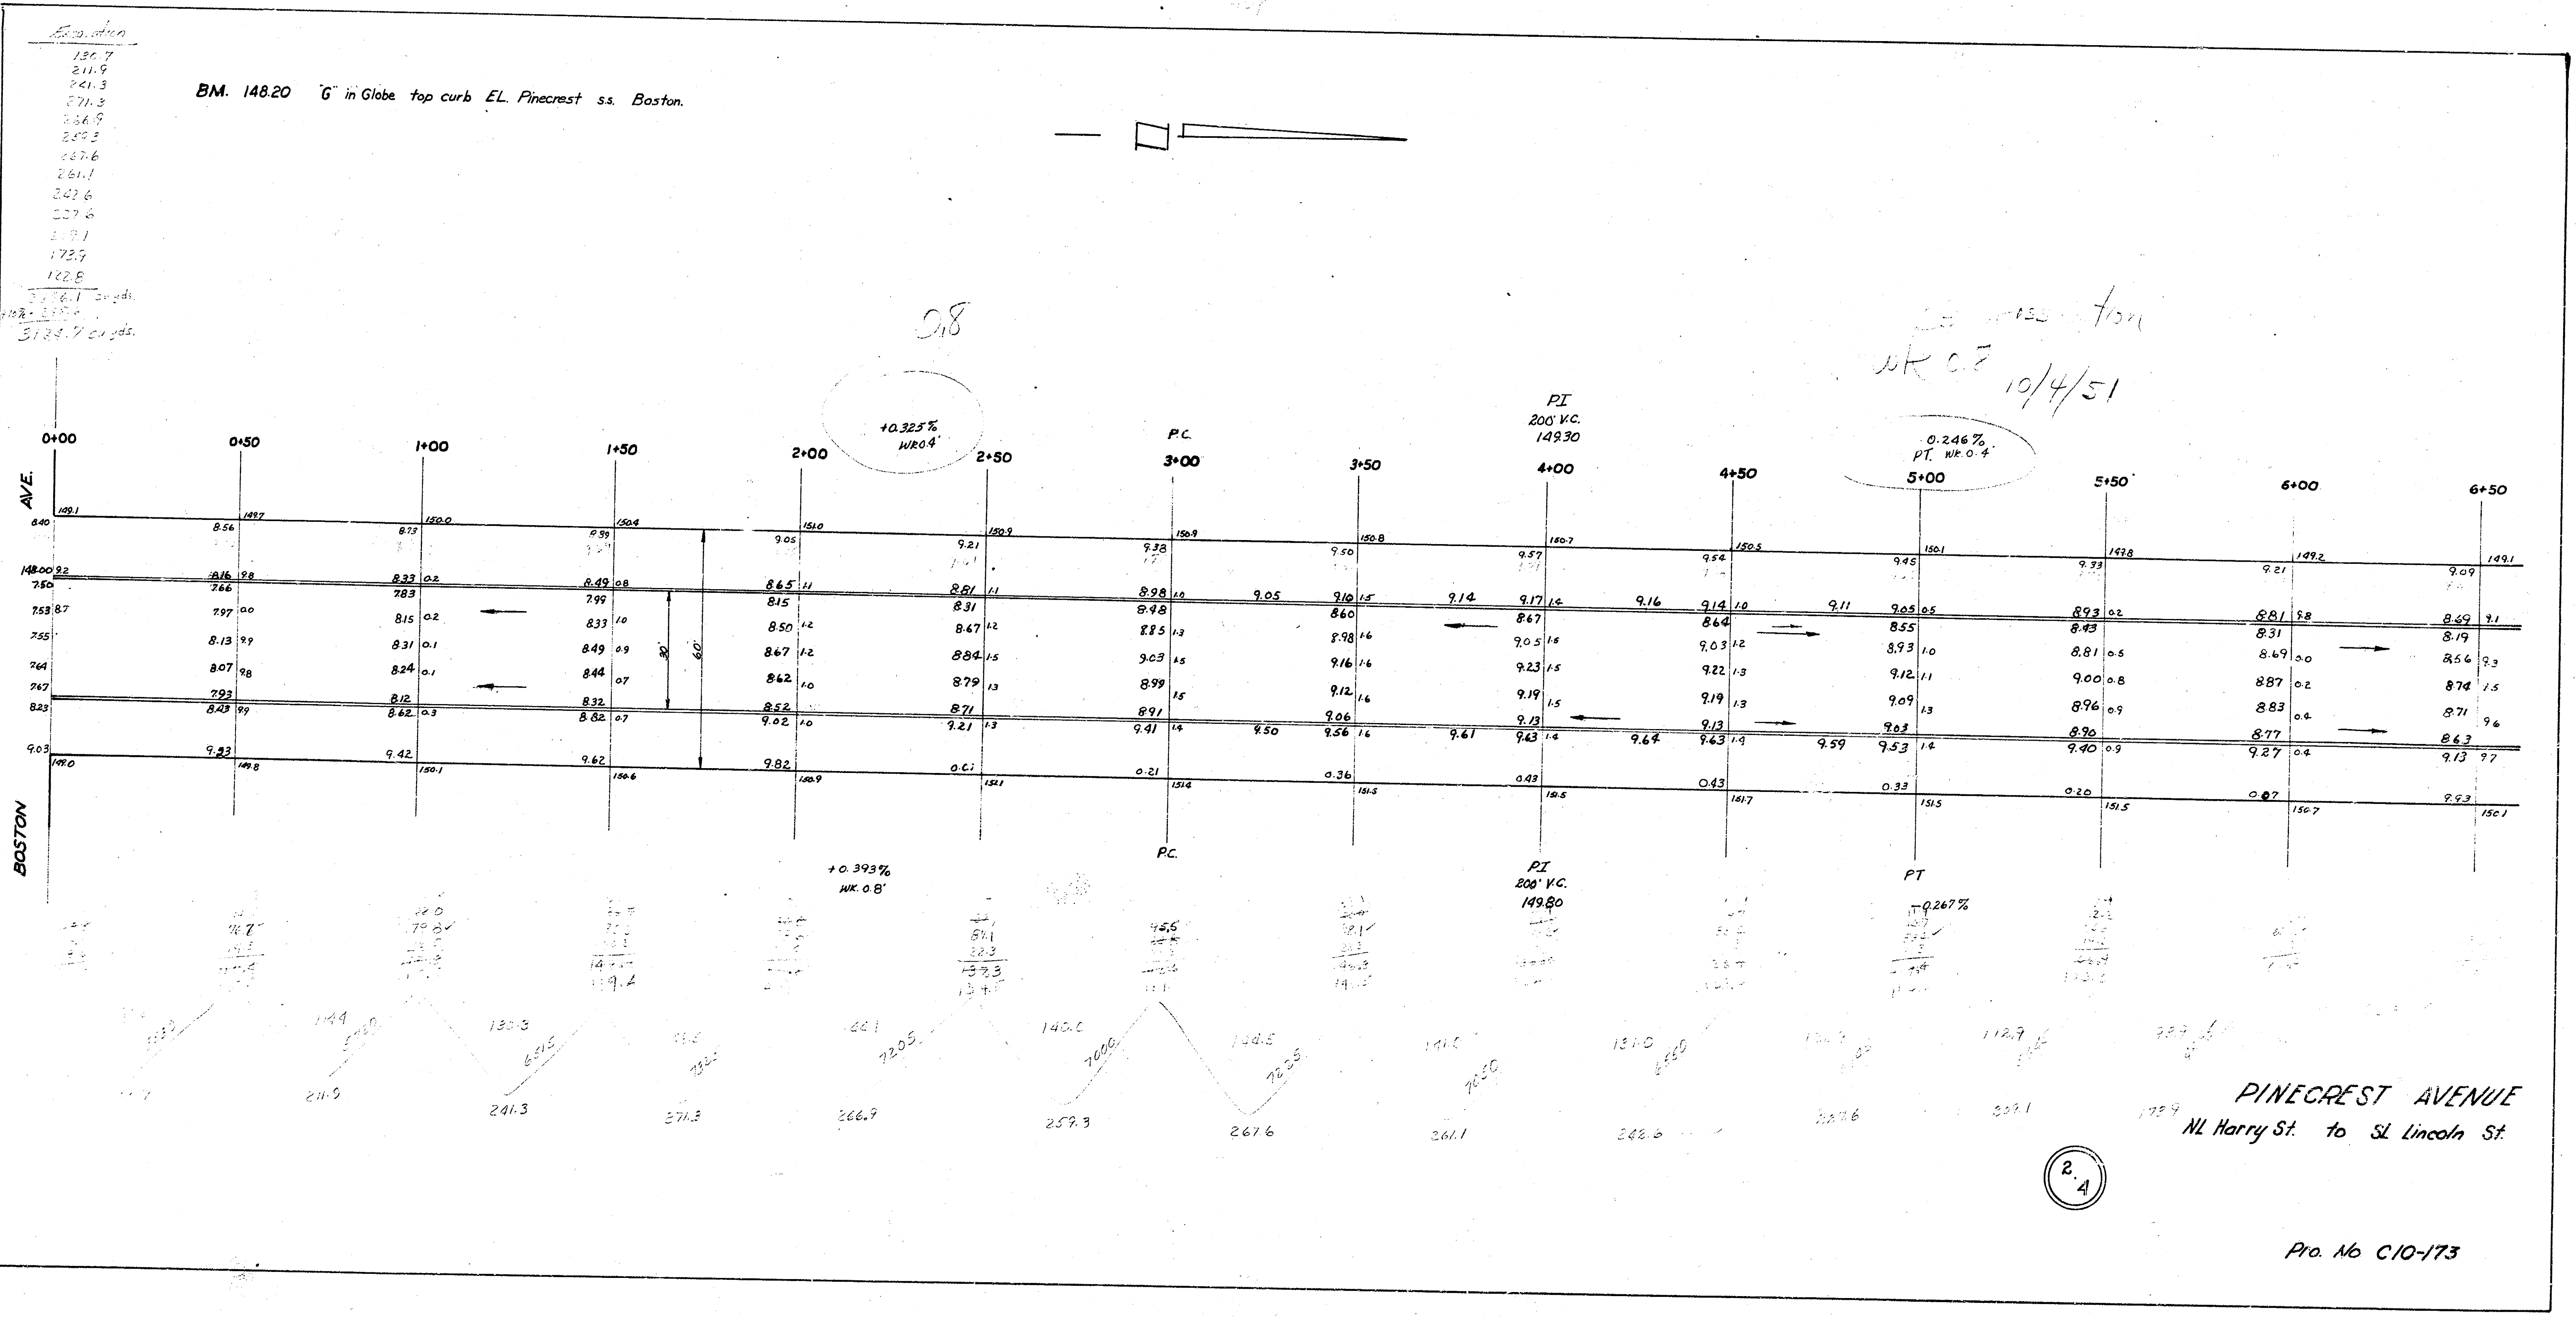

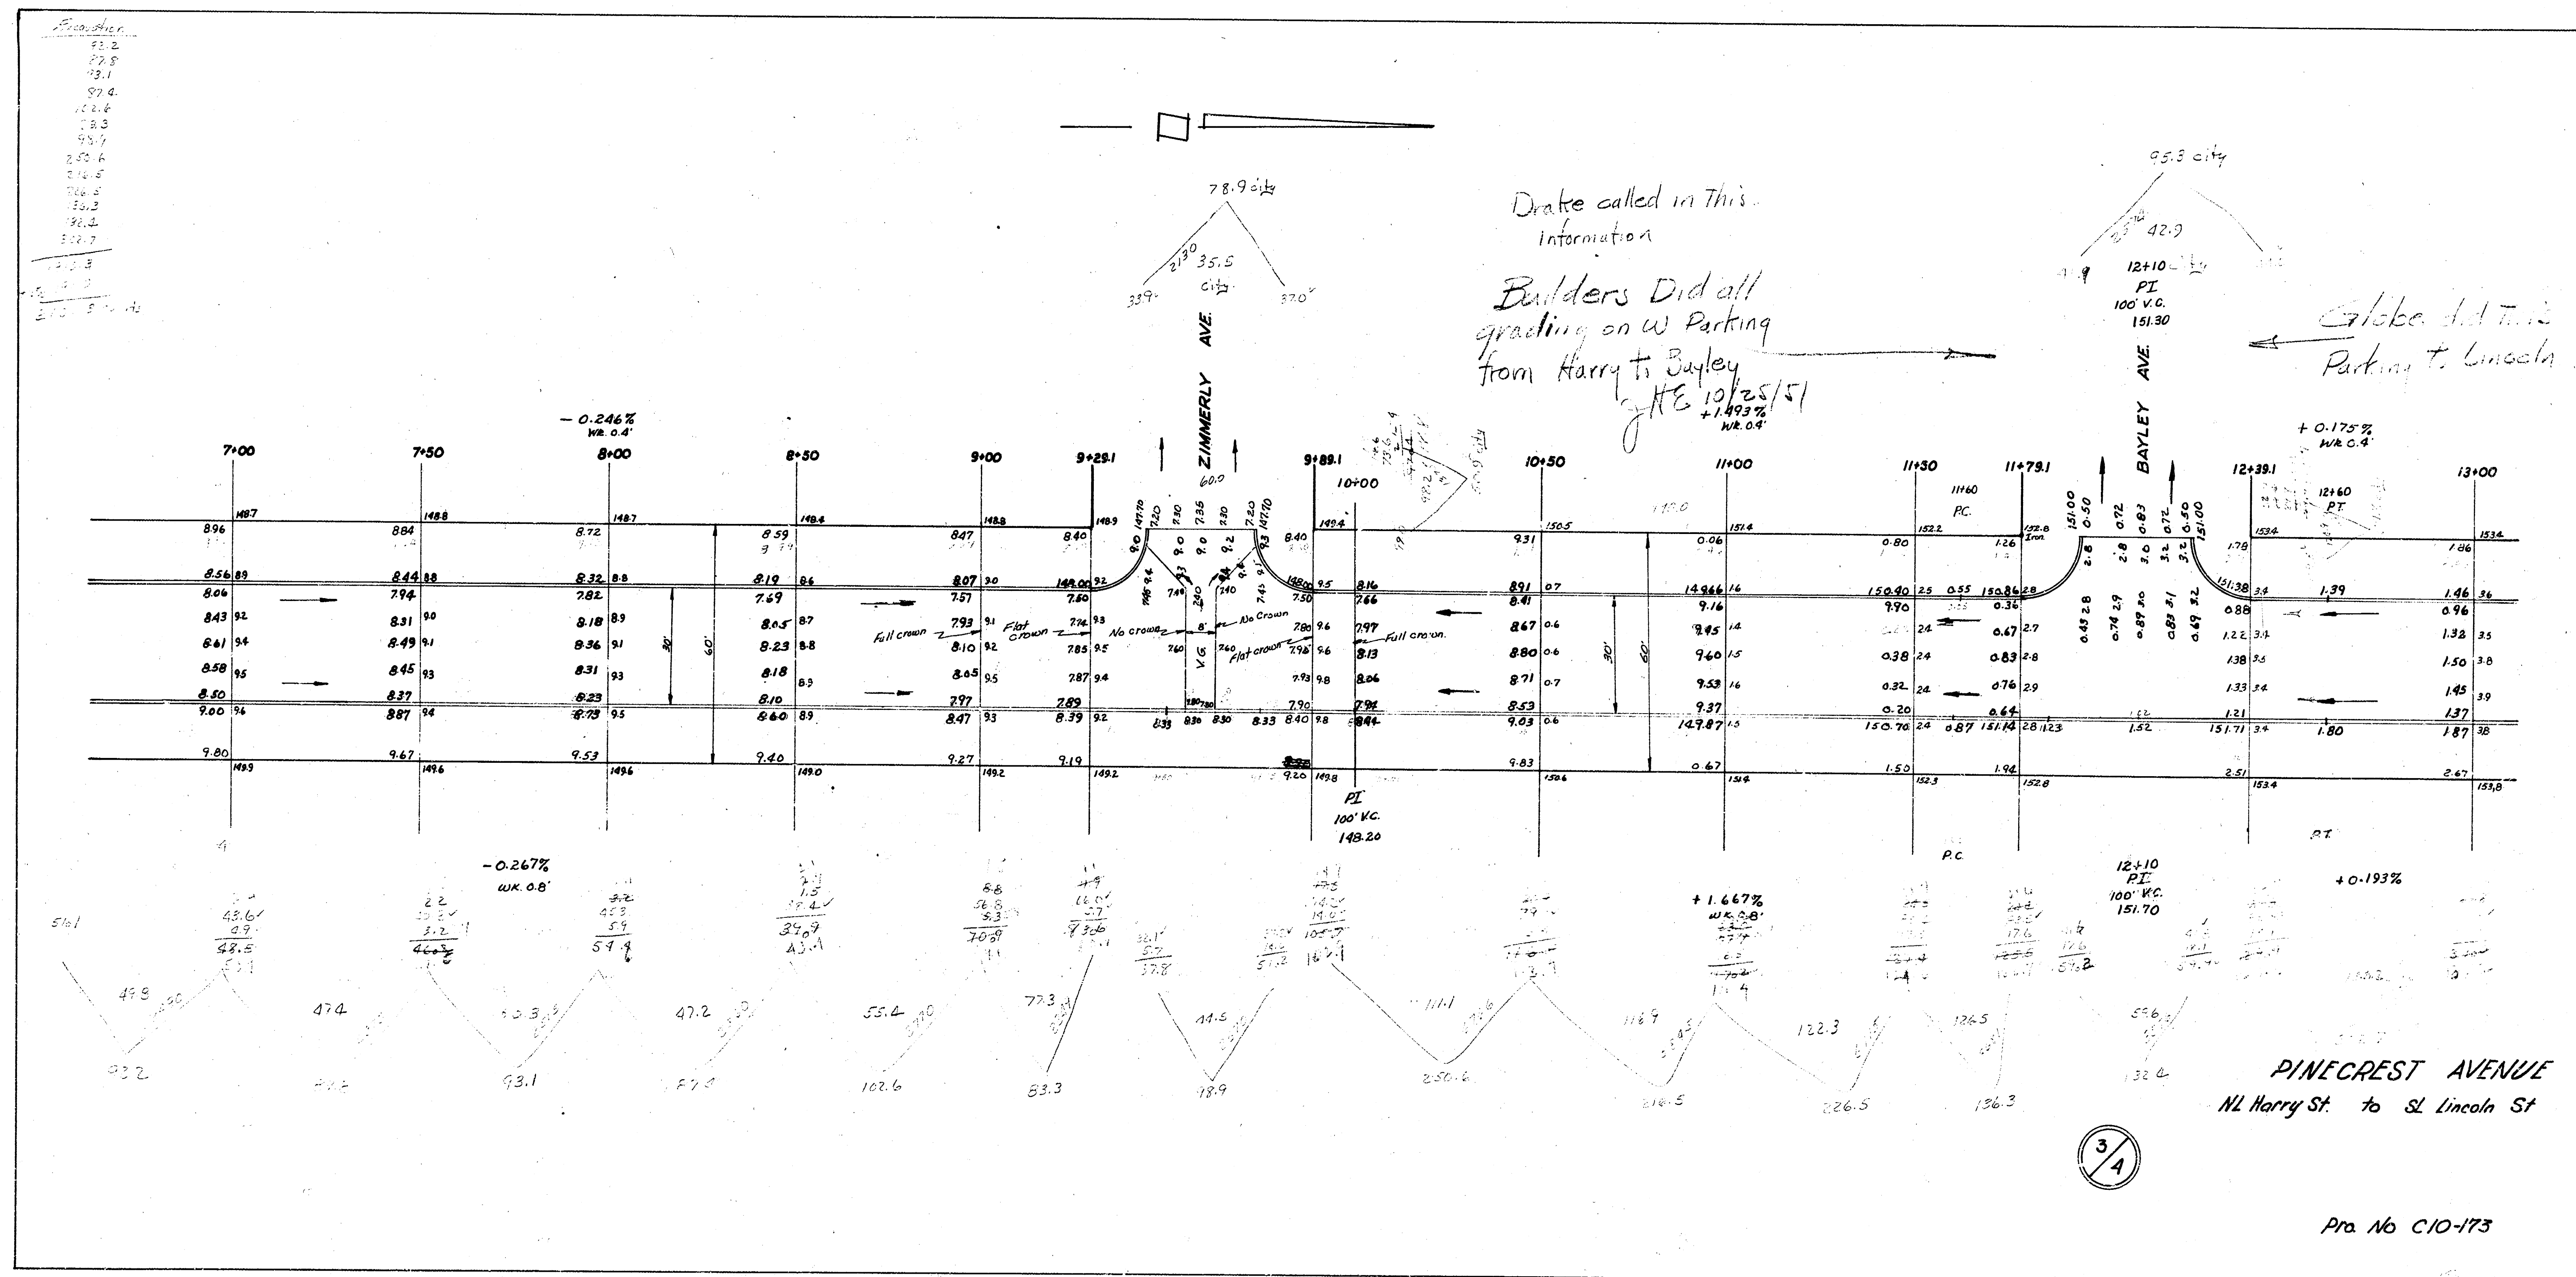

280.2
 227.4
 223.9
 227.6
 230.6
 247.8
 246.3
 244.6
 222.6
 221.7
 223.5
 217.3
 245.2

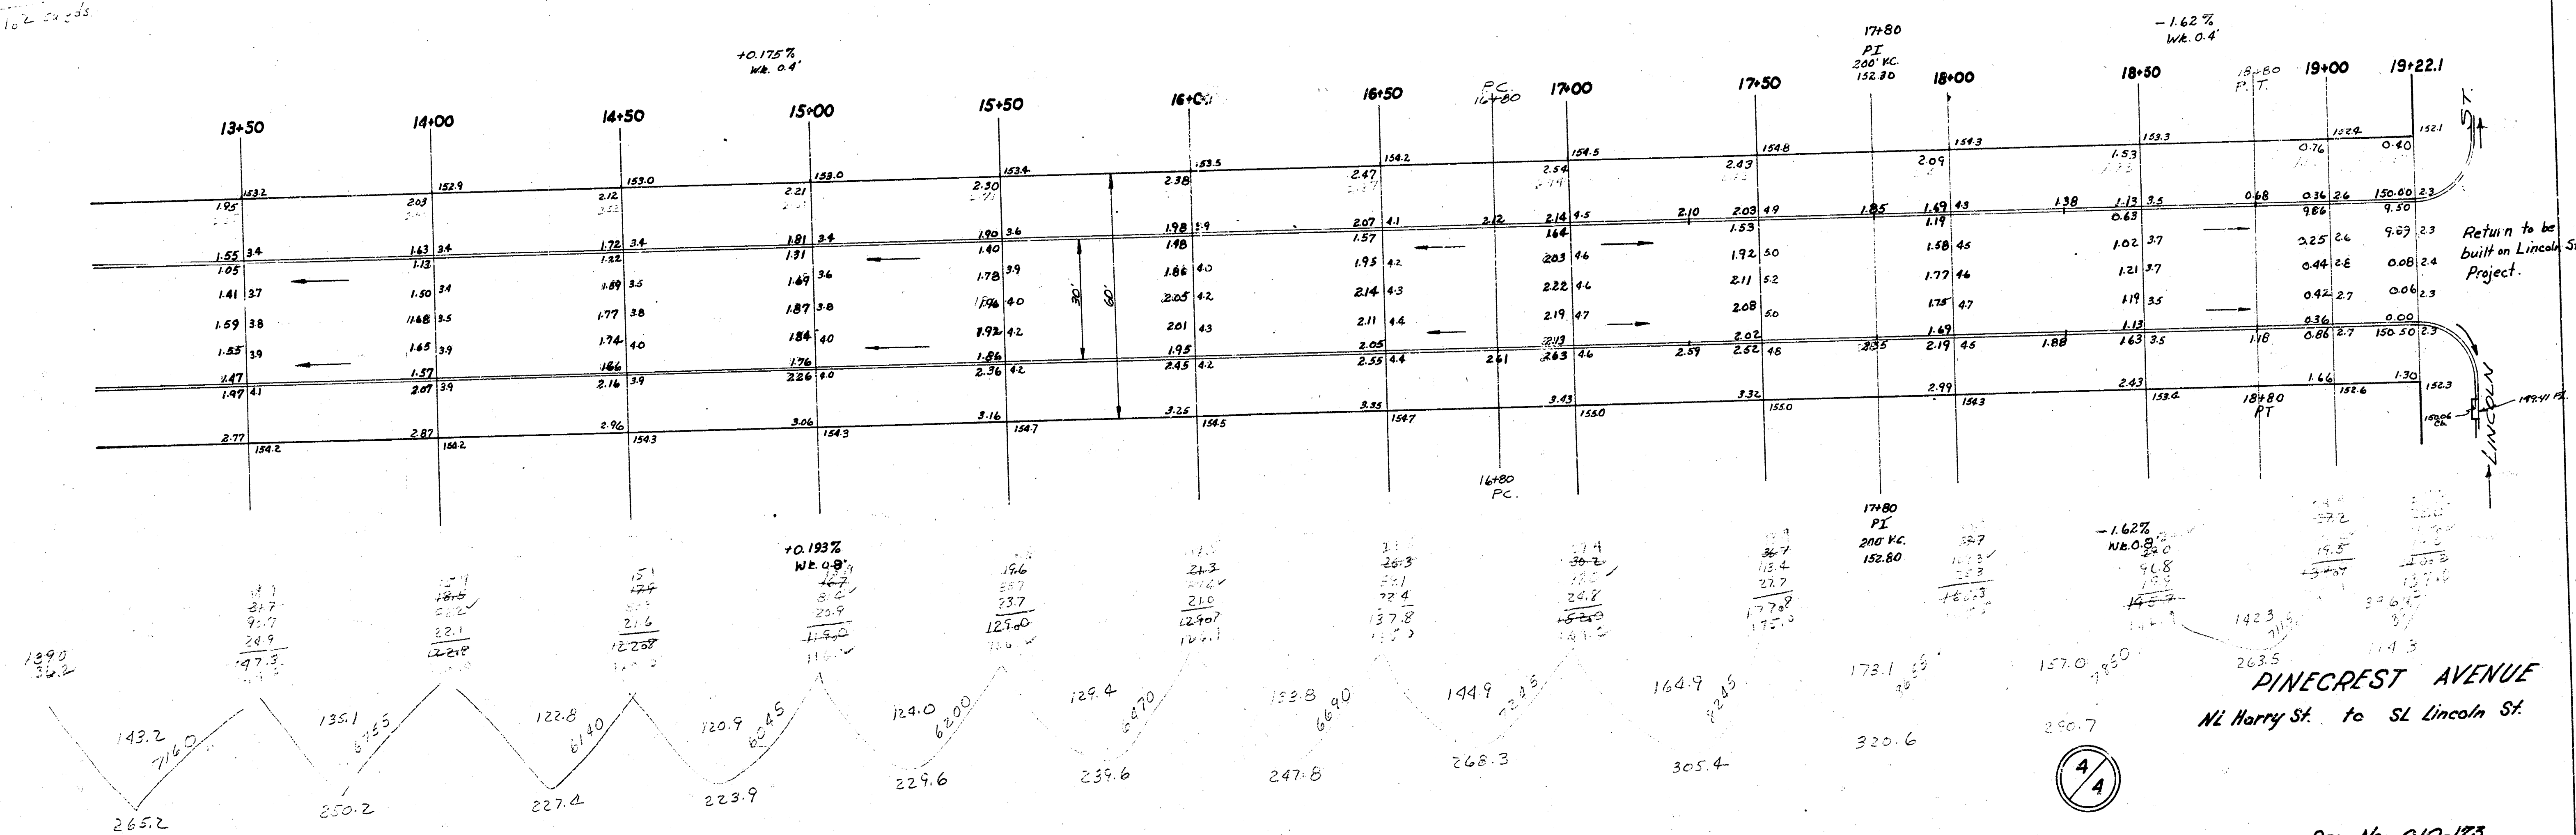

Pro. No C/D-173


B.M. 146.89 Standard SW corner Edgemoor & Harry.




5+50
 52.7
 54.1
 74.3
 67.2
 70.7
 76.3
 78.1
 76.5
 68.1
 67.7
 66.5
 33.1
 53.13
 210.90
 714.1 Cb. yds.

5+50
 15.5
 30.4
 4.8
 1.096
 53.8 Cb. yds.

St.

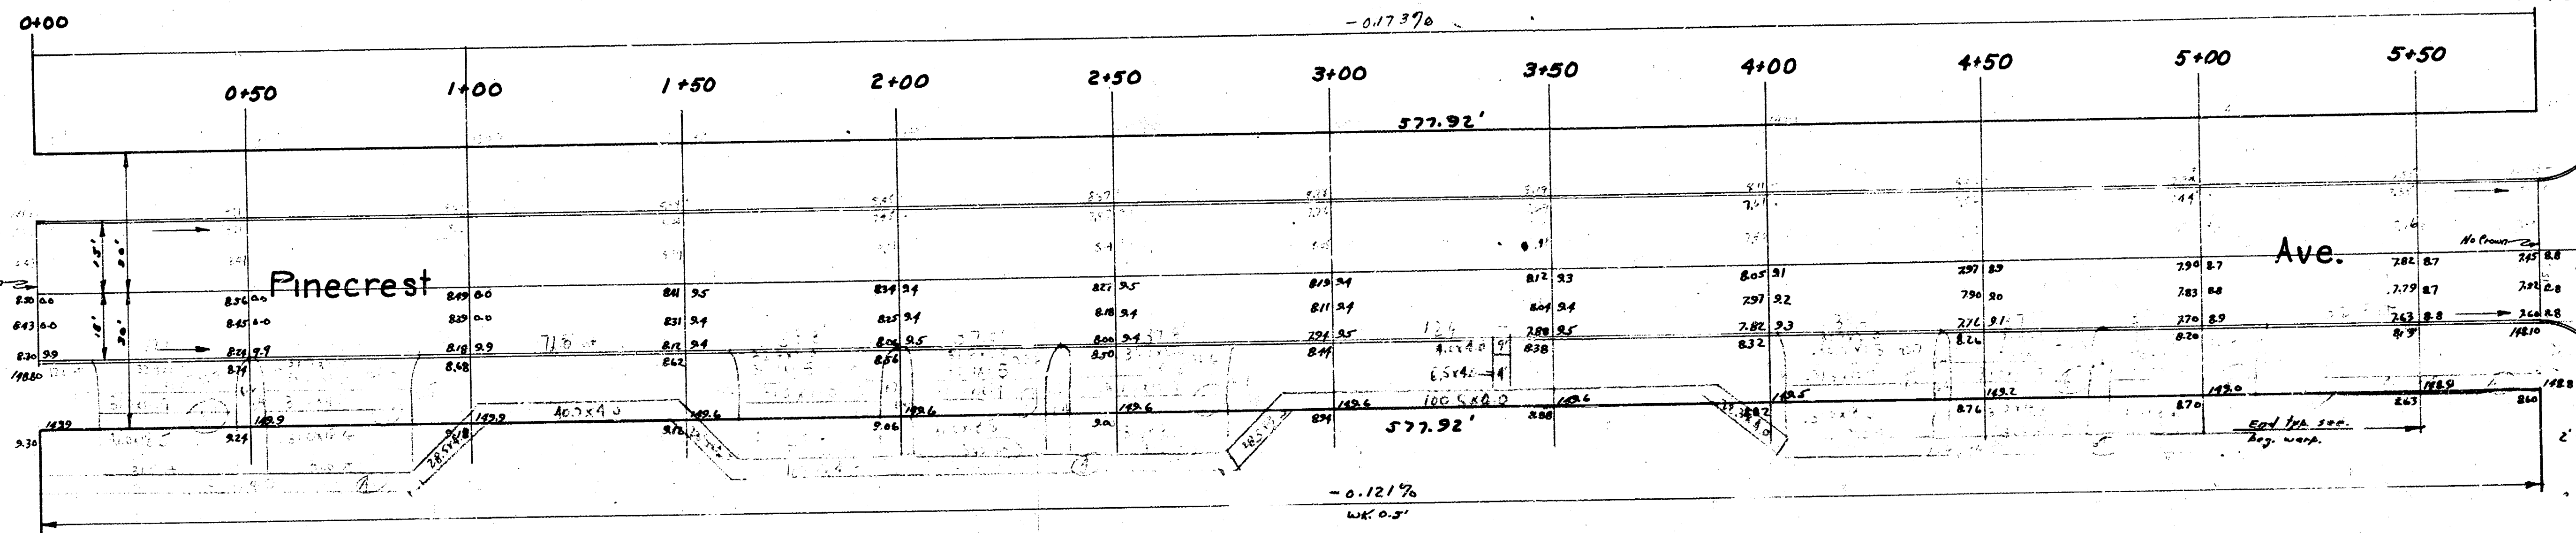

Harry

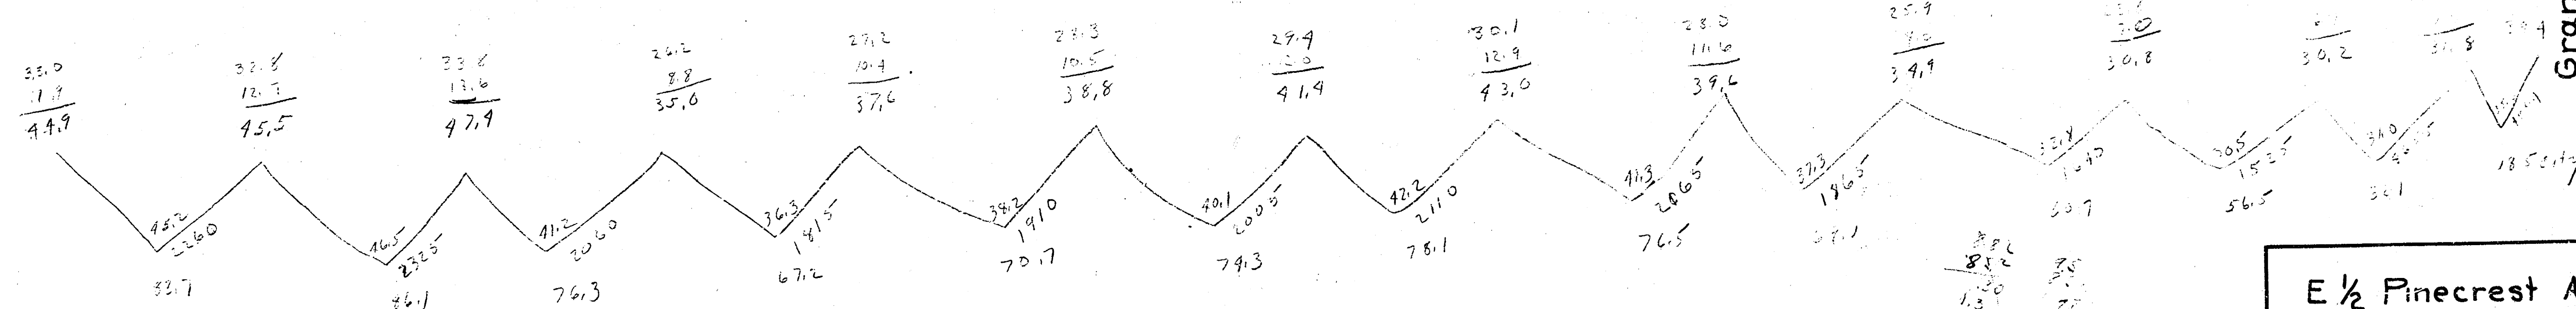

E 1/2 Pinecrest Ave.
 N. L. Harry to E Grand
 15' Conc. & Cb.
 City of Wichita, Kansas
 L. K. White - City Engineer
 April 1950 Private Job.

4 4 4 50