
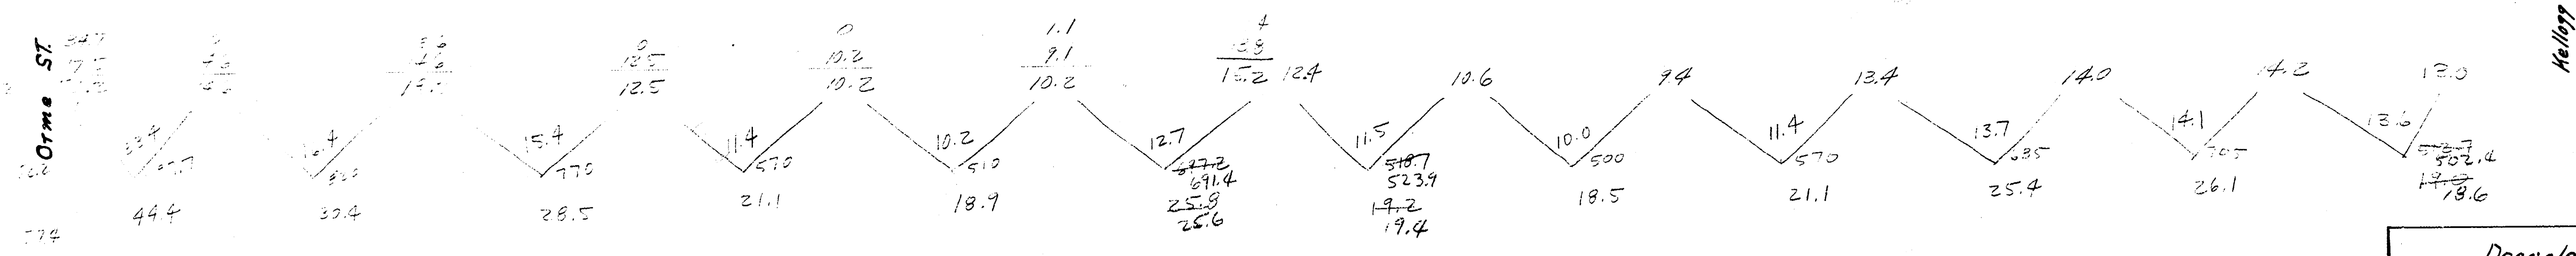



B.M. 152.97 N.W. Cor. of 1st step of Ho. #642 S. Deavola


ST
0
44.4
33.4
28.5
21.1
15.7
12.5
17.2
18.5
21.1
25.4
29.1
19.0
27.4
+10.26
339.2 cu yds.

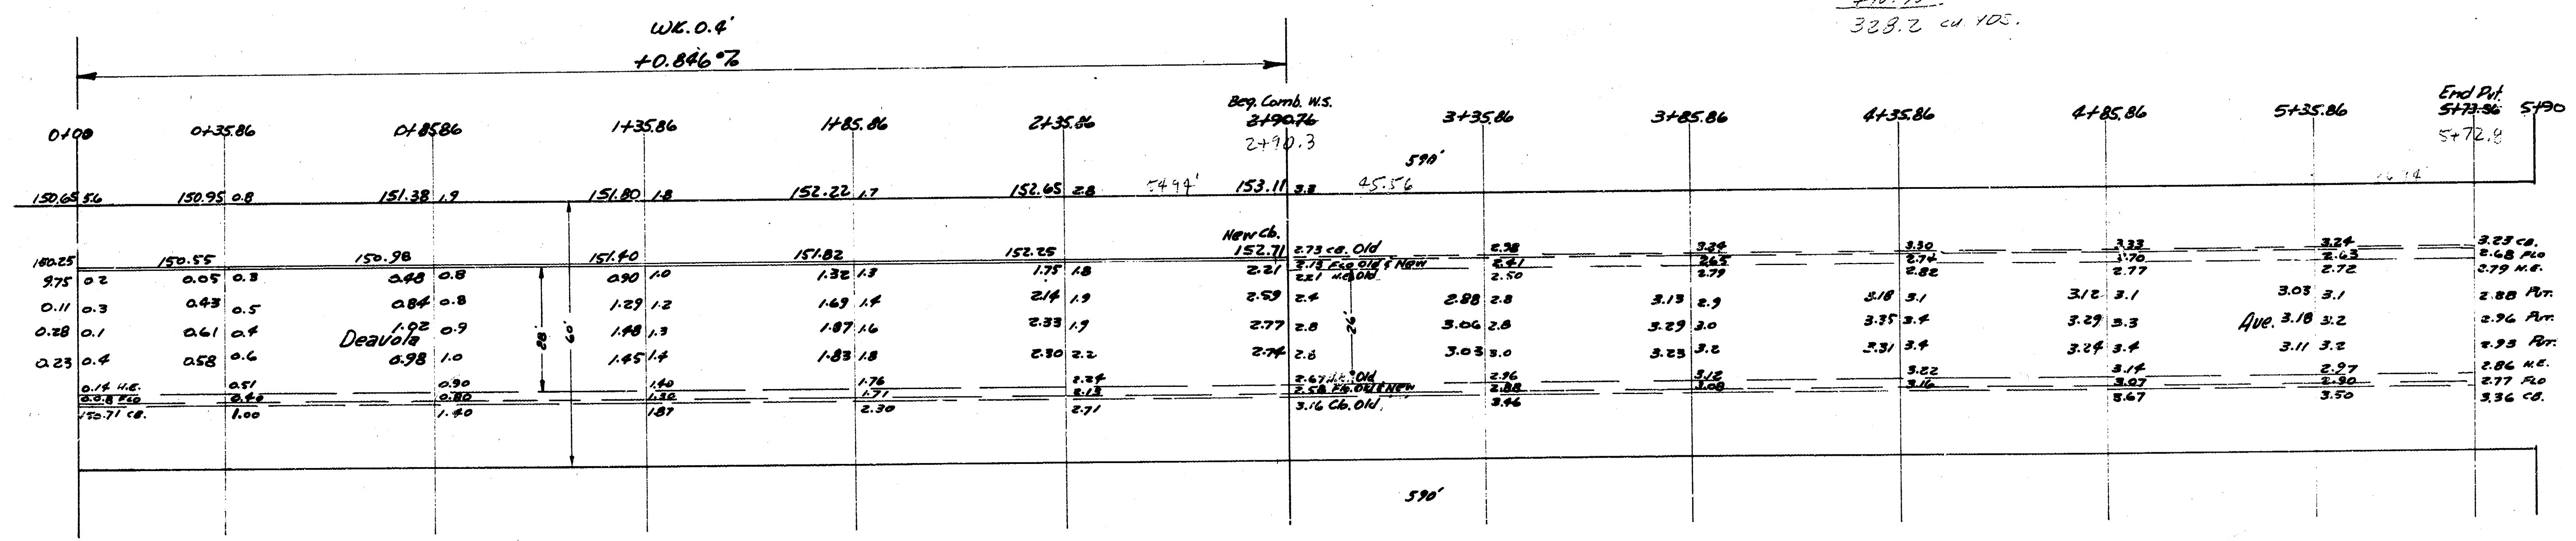



Deavola Ave.
N.L. Orme — S.L. Kellogg
26' Conc. & 28' Conc. & Cb.
City of Wichita, Kansas
L.K. White City Engineer
September 1948 Project C18-128

1942
 DEAVOLA AVE — S.L. KELLOGG TO N.L. ORME
 CB. & GTR.

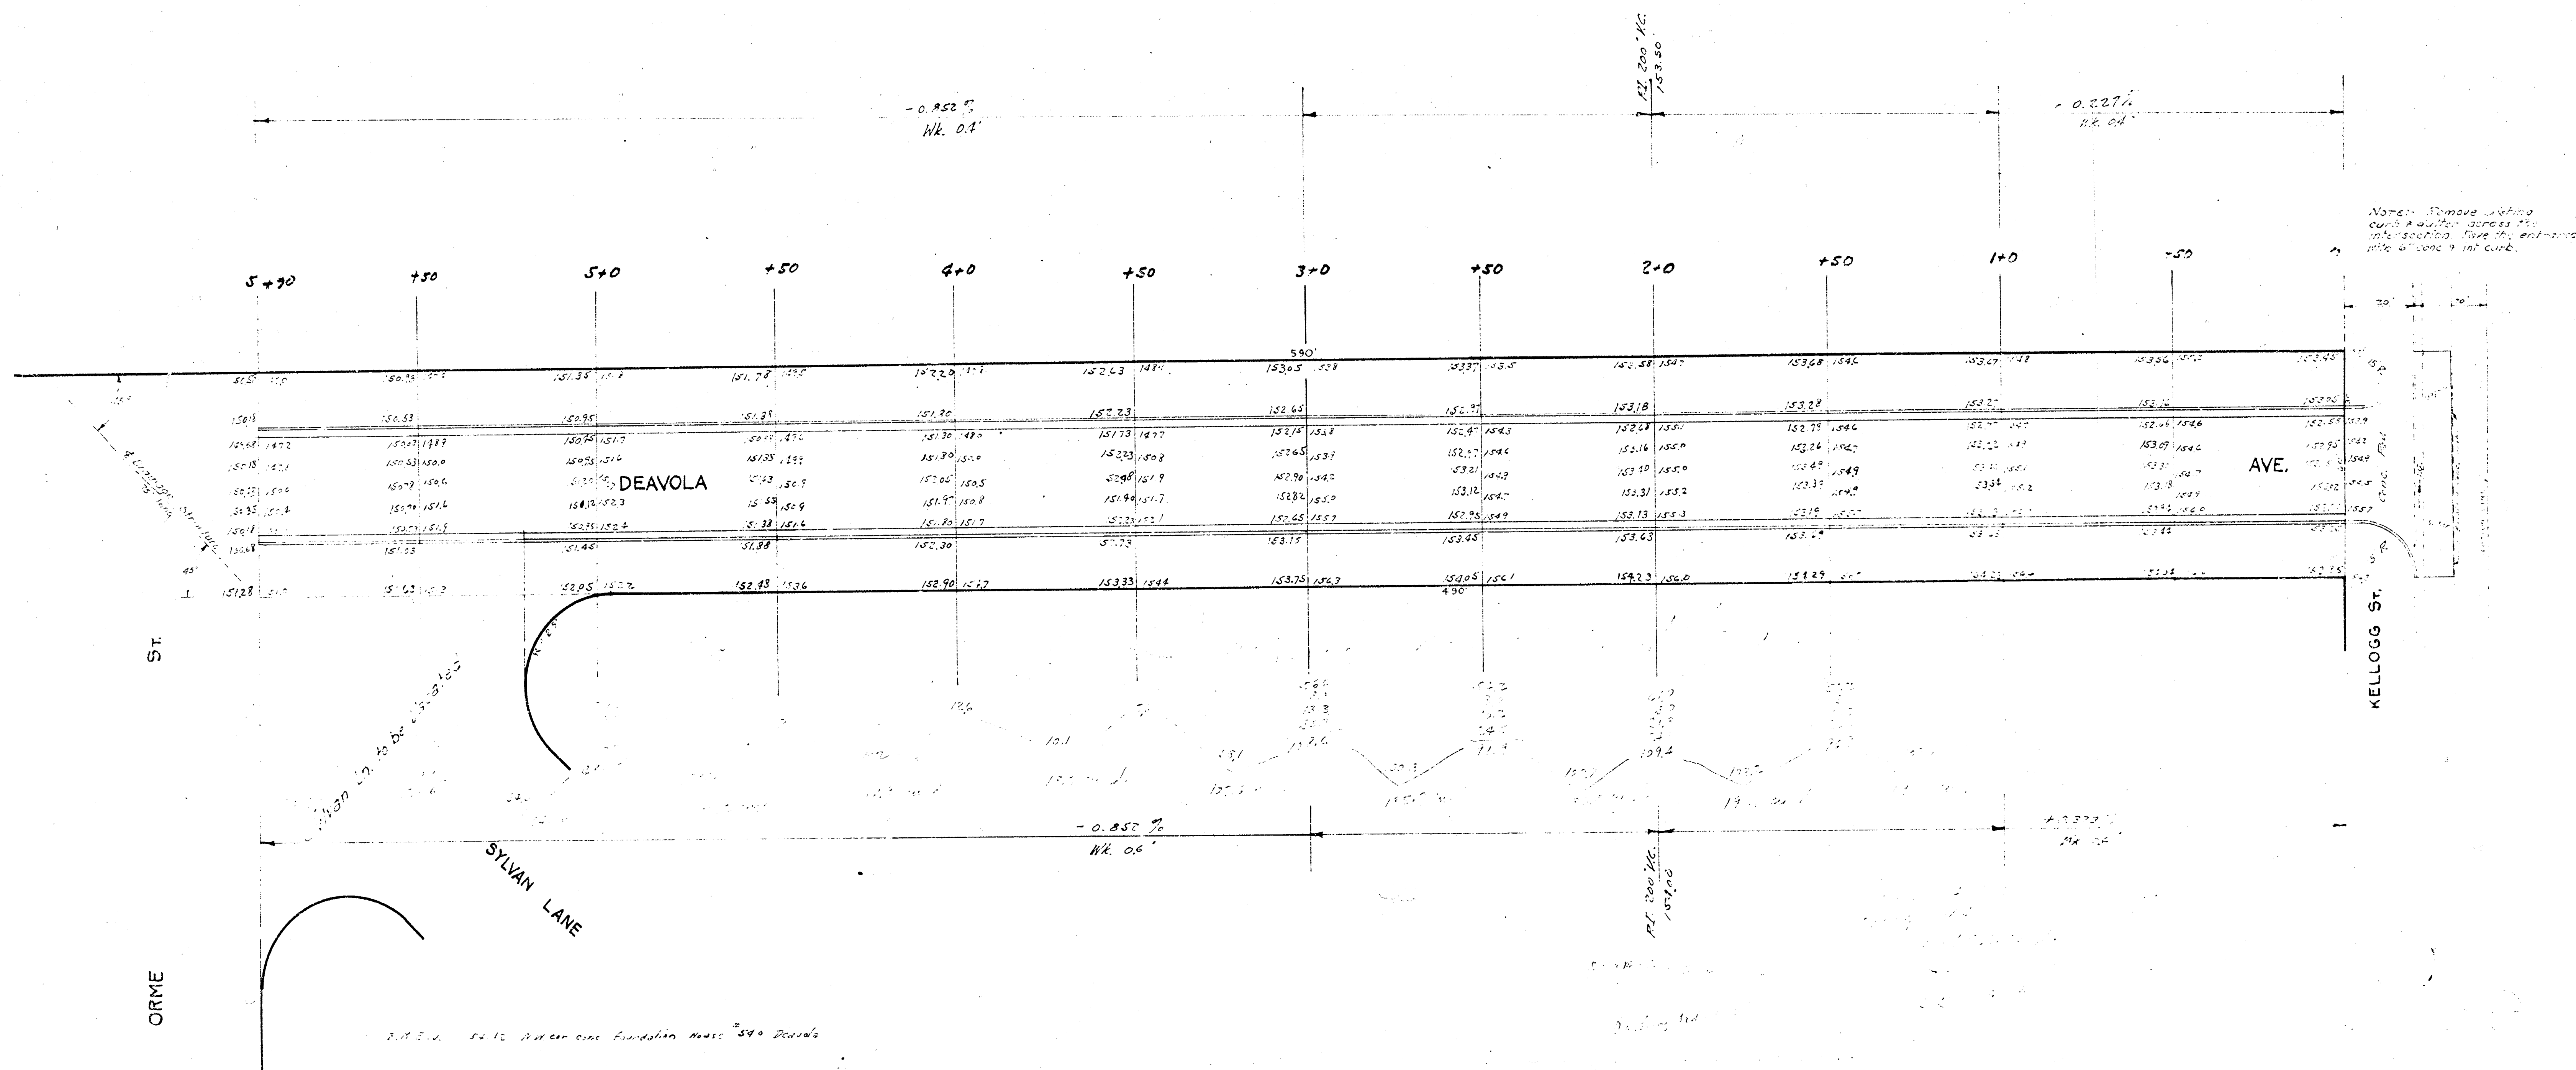

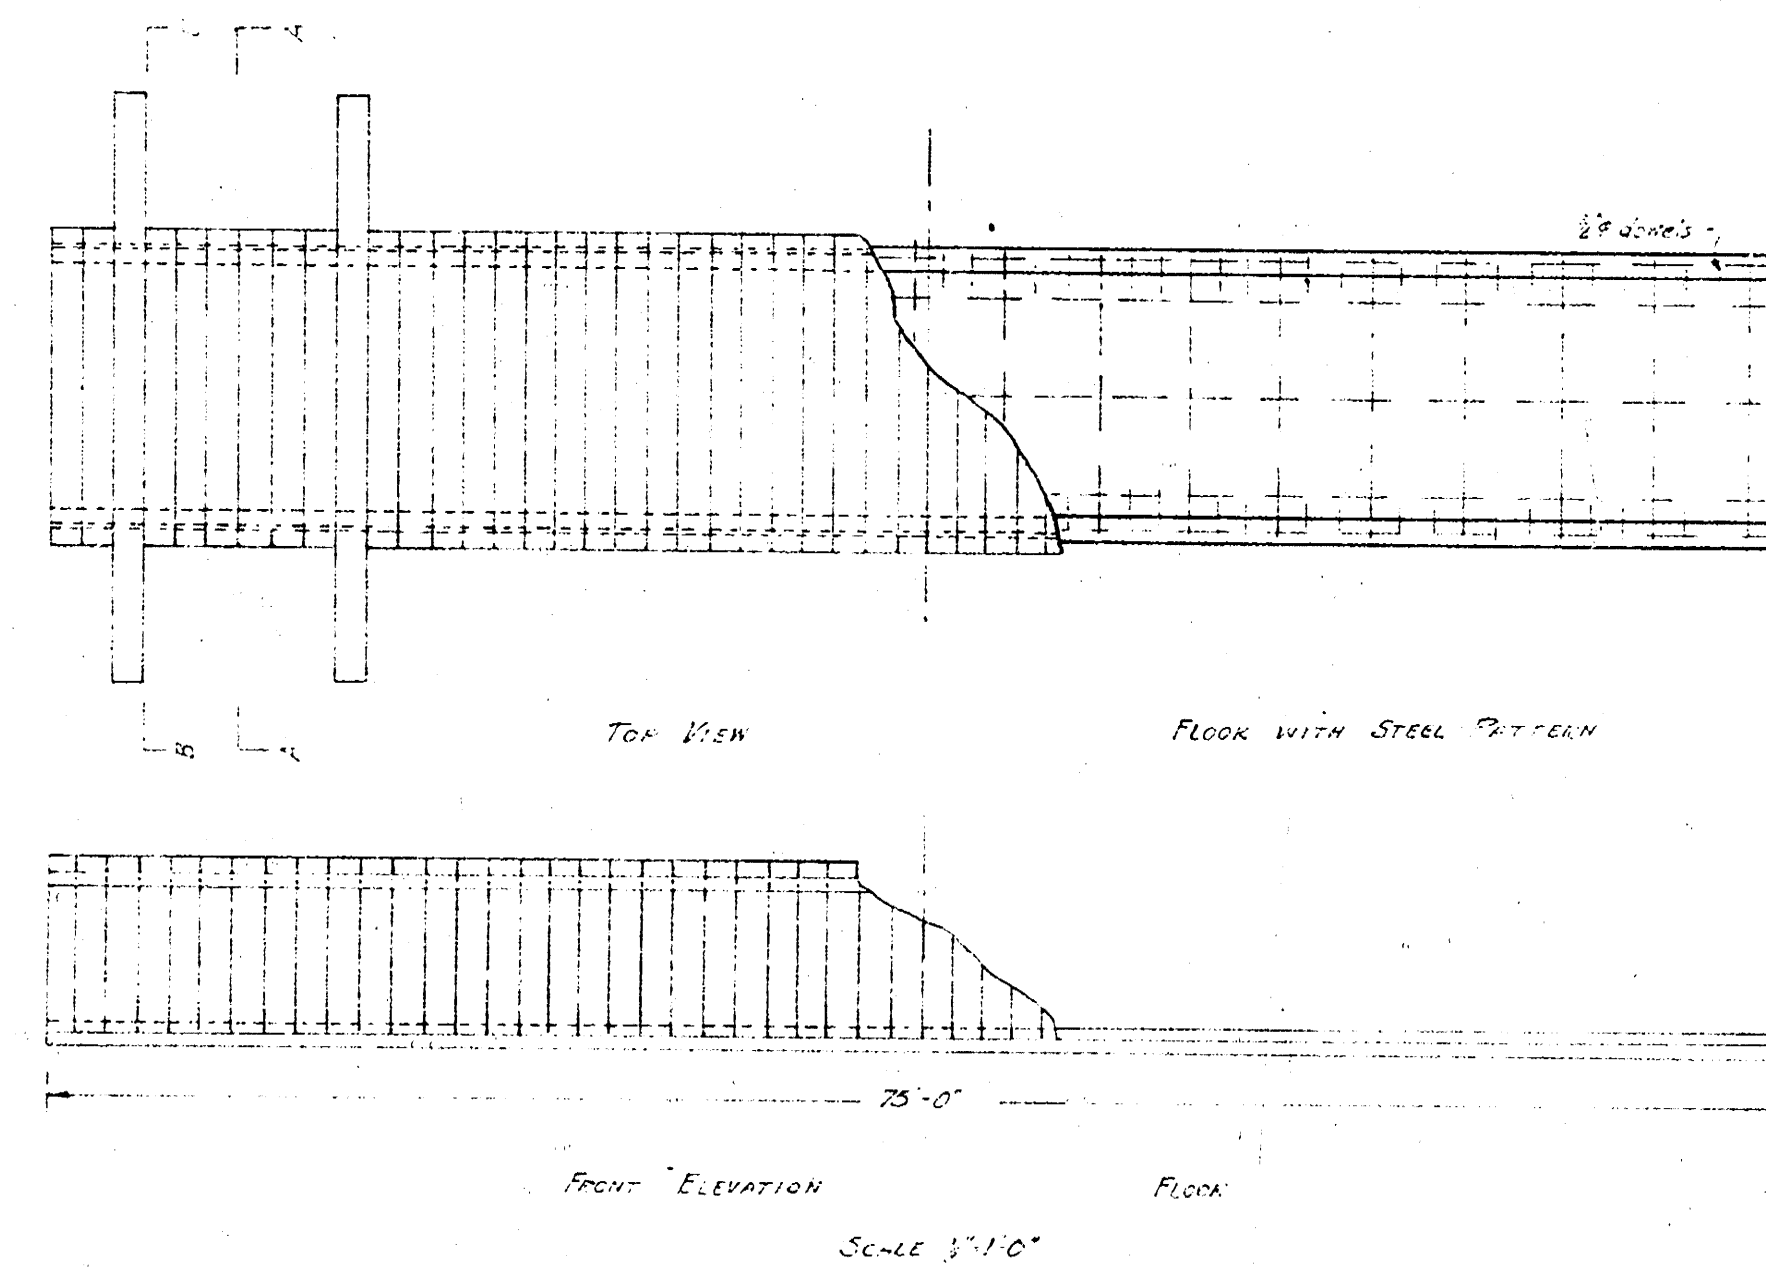

NOTE: All timbers are salvaged bridge timbers

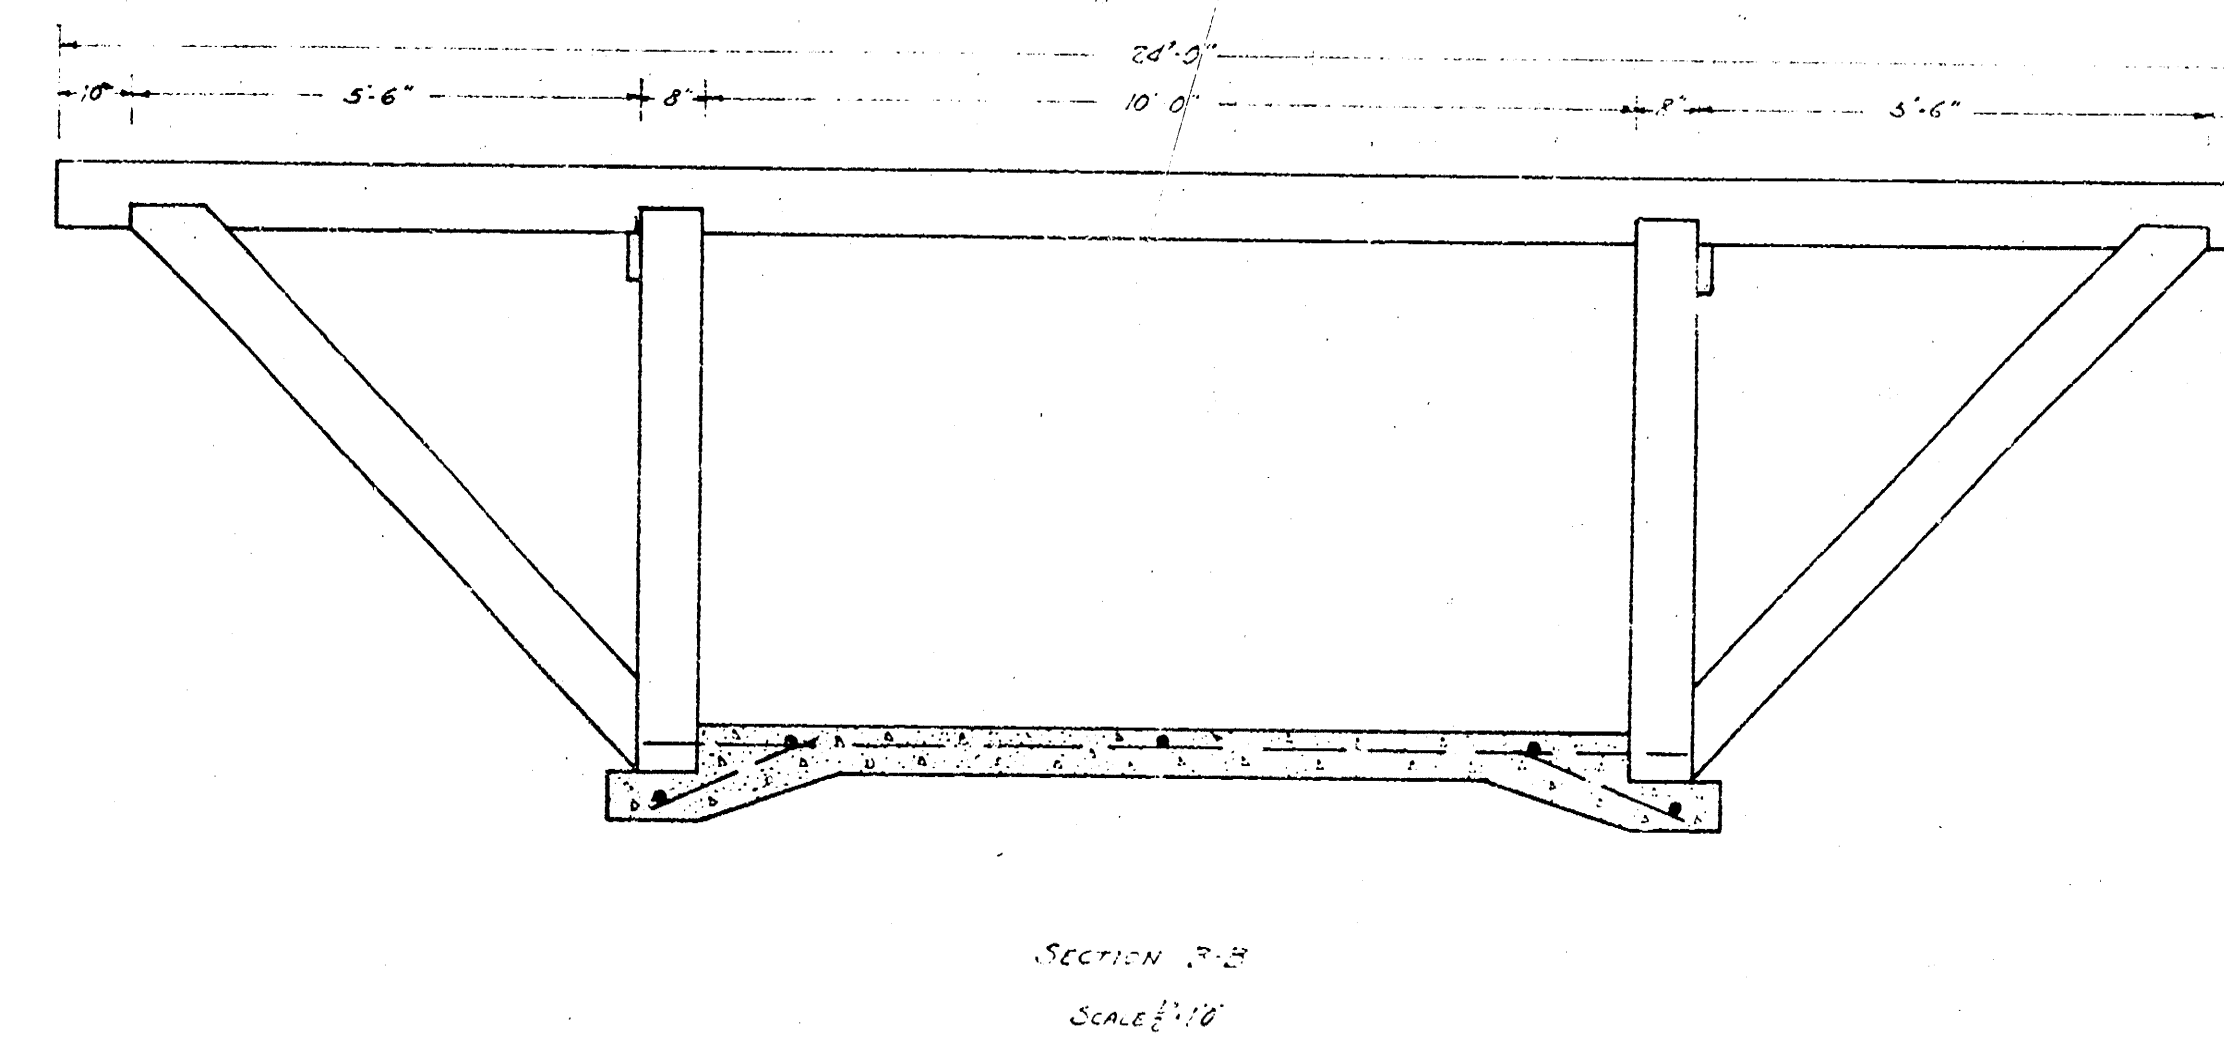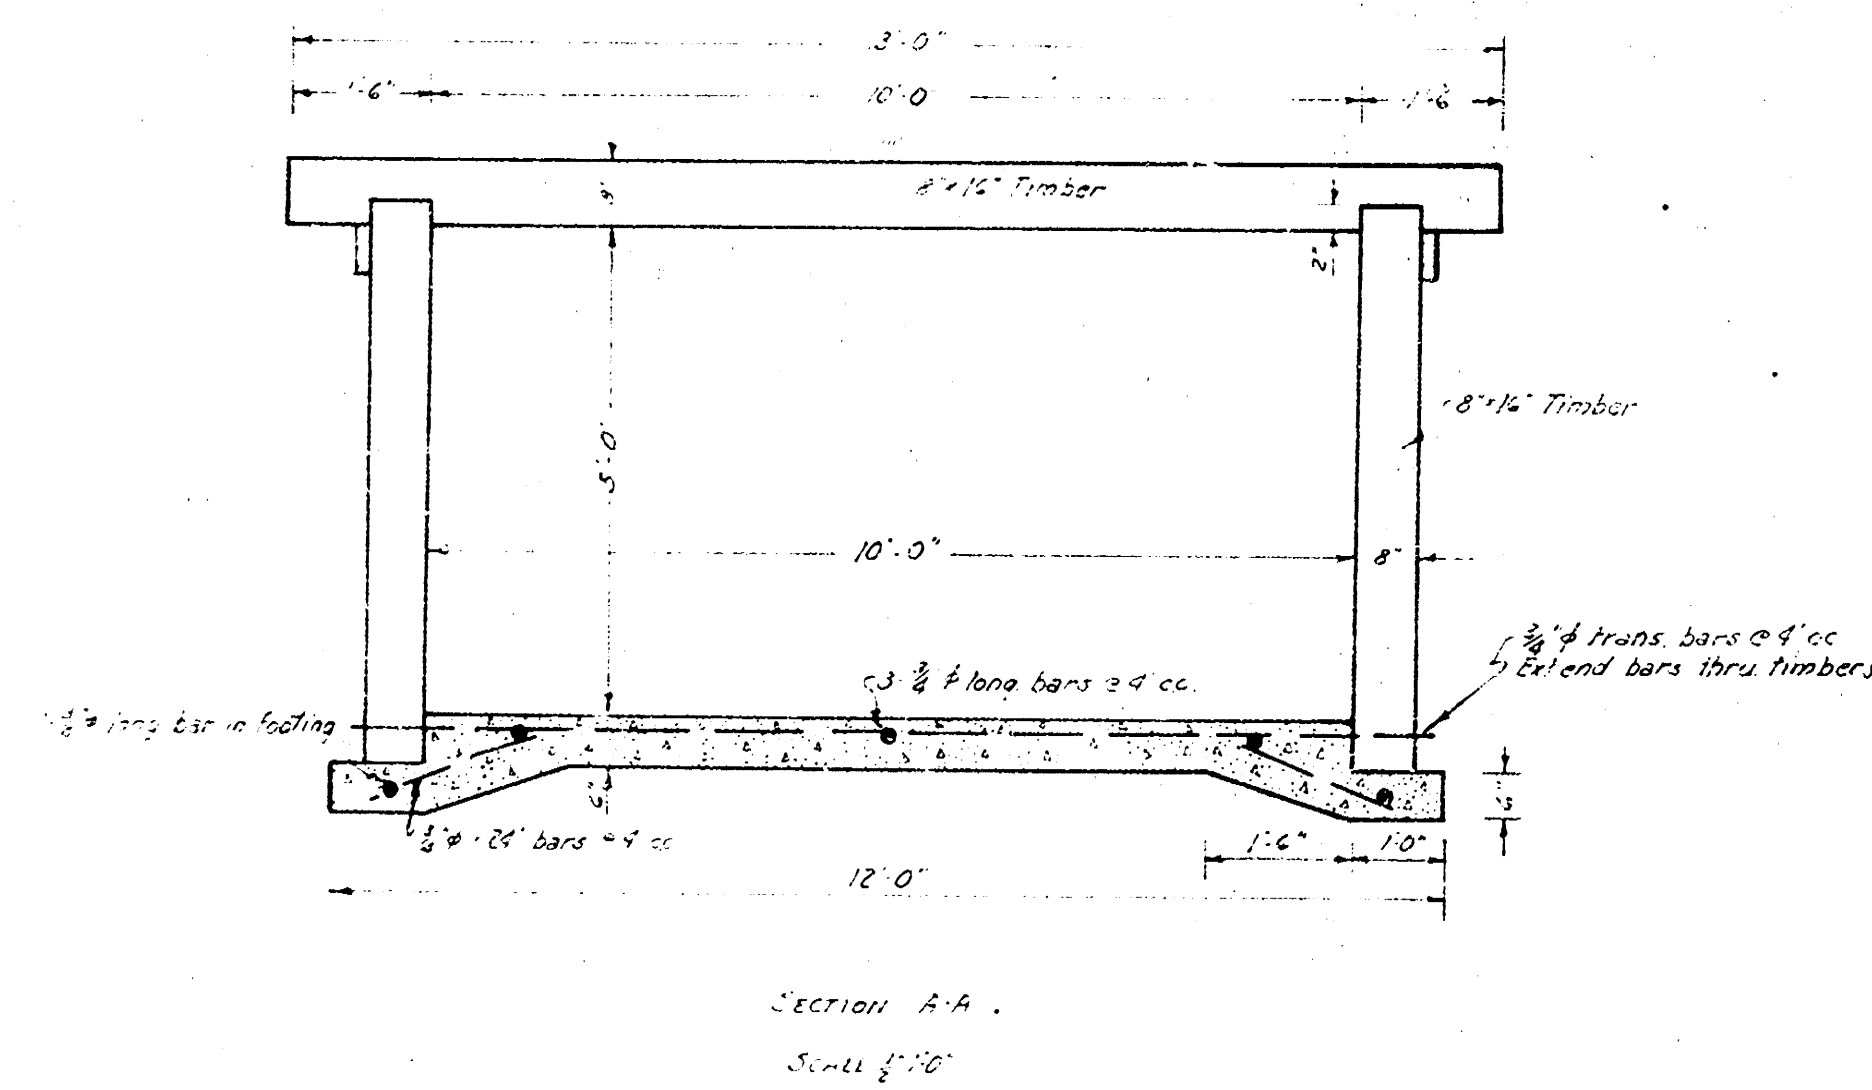

DETAILS OF CULVERT TO BE CONSTRUCTED
AT THE INTERSECTION OF DEAVOLA & ORME

NOTE TO CONTRACTOR
Bids are to be taken on excavation and
concrete base only. The walls and top are
to be constructed with salvaged bridge
timbers by force account.