



 Stationing on H.P.



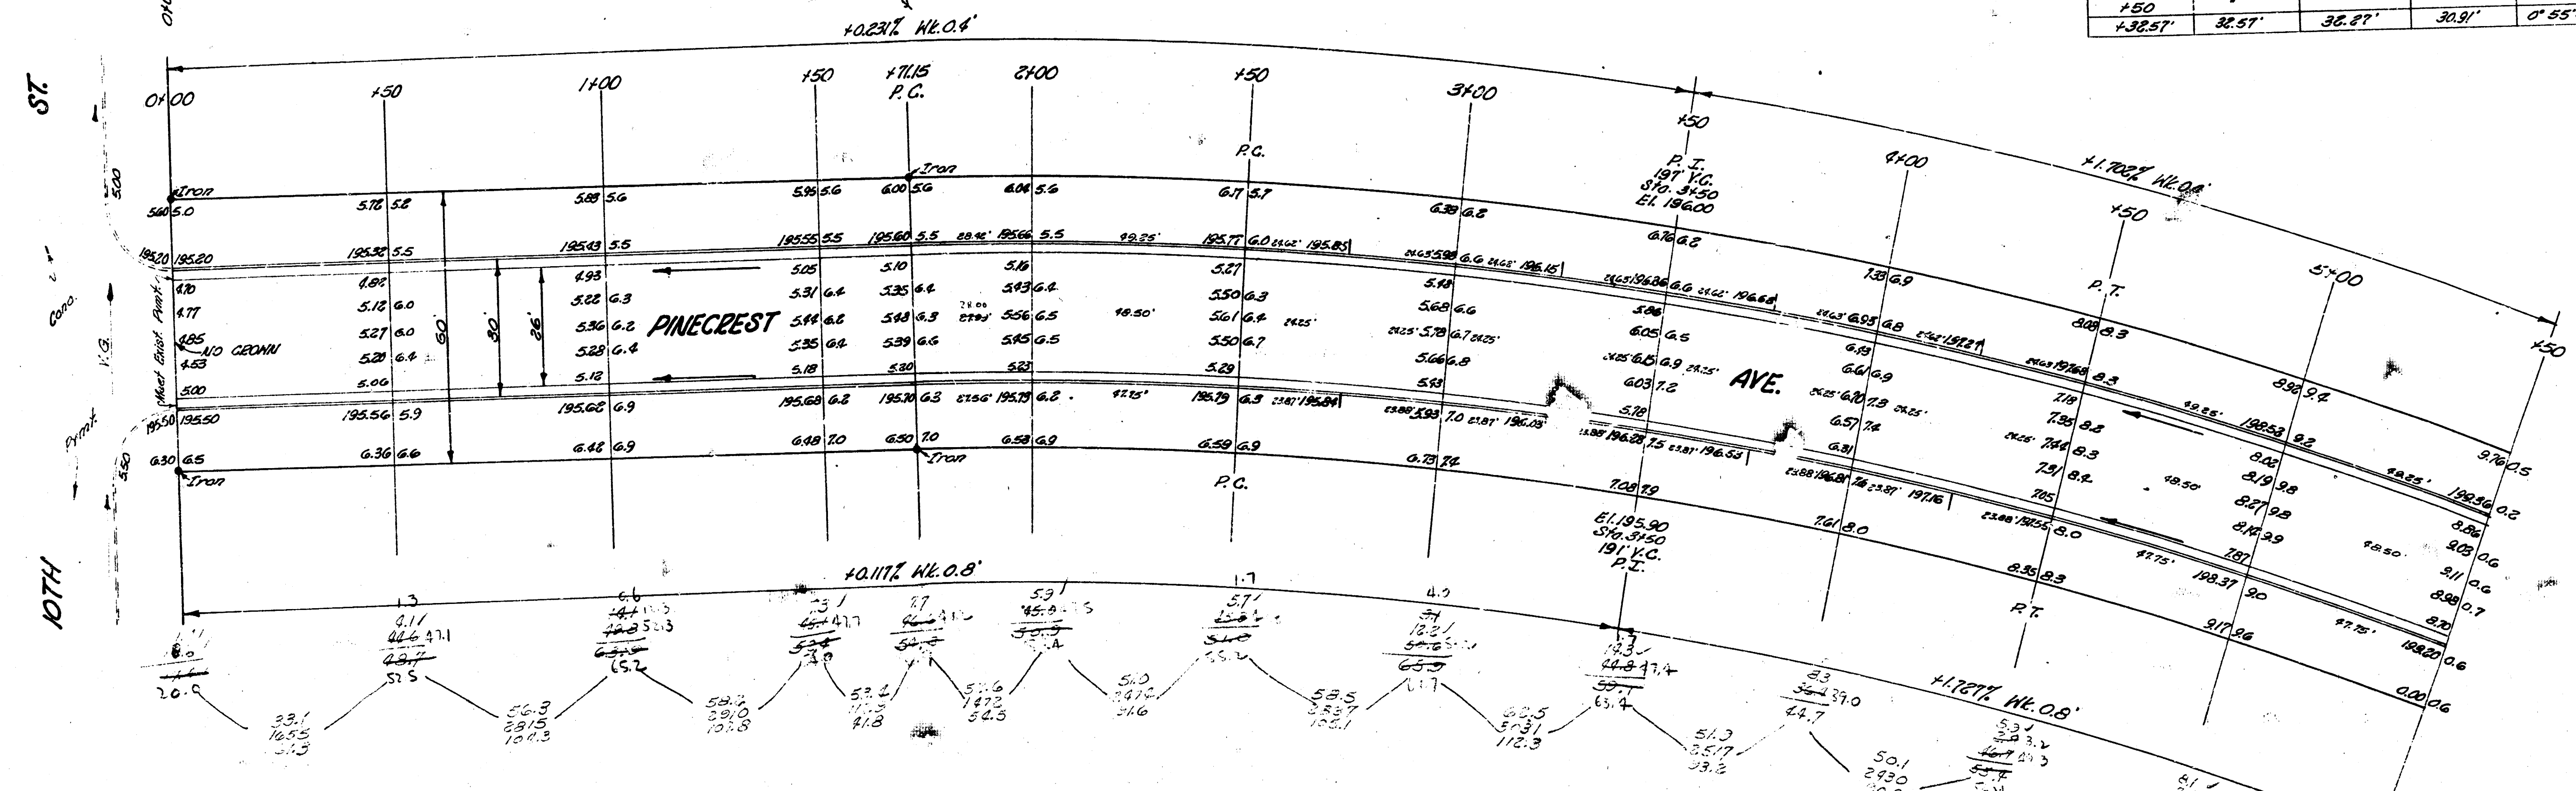


SACRIFICATION
 3.1194.85
 TOTAL 3417.4 CUBIC FEET

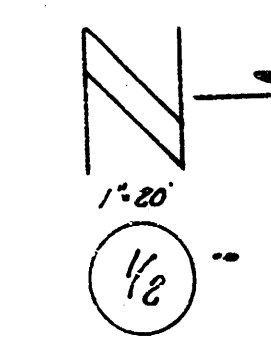

PINECREST AVE.
 N.E. 10TH ST. TO S.E. LAMBDALDE DR.
 26'-3'-30" A.C.
CITY OF WICHITA, KANSAS
 B.E. SMITH
 Nov. 1953
 CITY ENGINEER
 P.E. No. 012-54


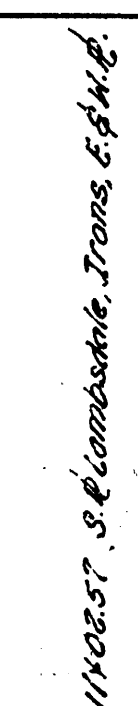

LAMESDALE

2/2