


STA. ON VVR

Pr. op	Pr. op
133.7	134.6
64.3	57.4
24.9	25.8
18.9	11.4
24.0	35.1
33.1	44.0
34.6	53.0
10.1	10.3
120.0	122.9
10.6	110.8
79.9	79.7
80.8	841.0 am. feds
20.9	
899.6	

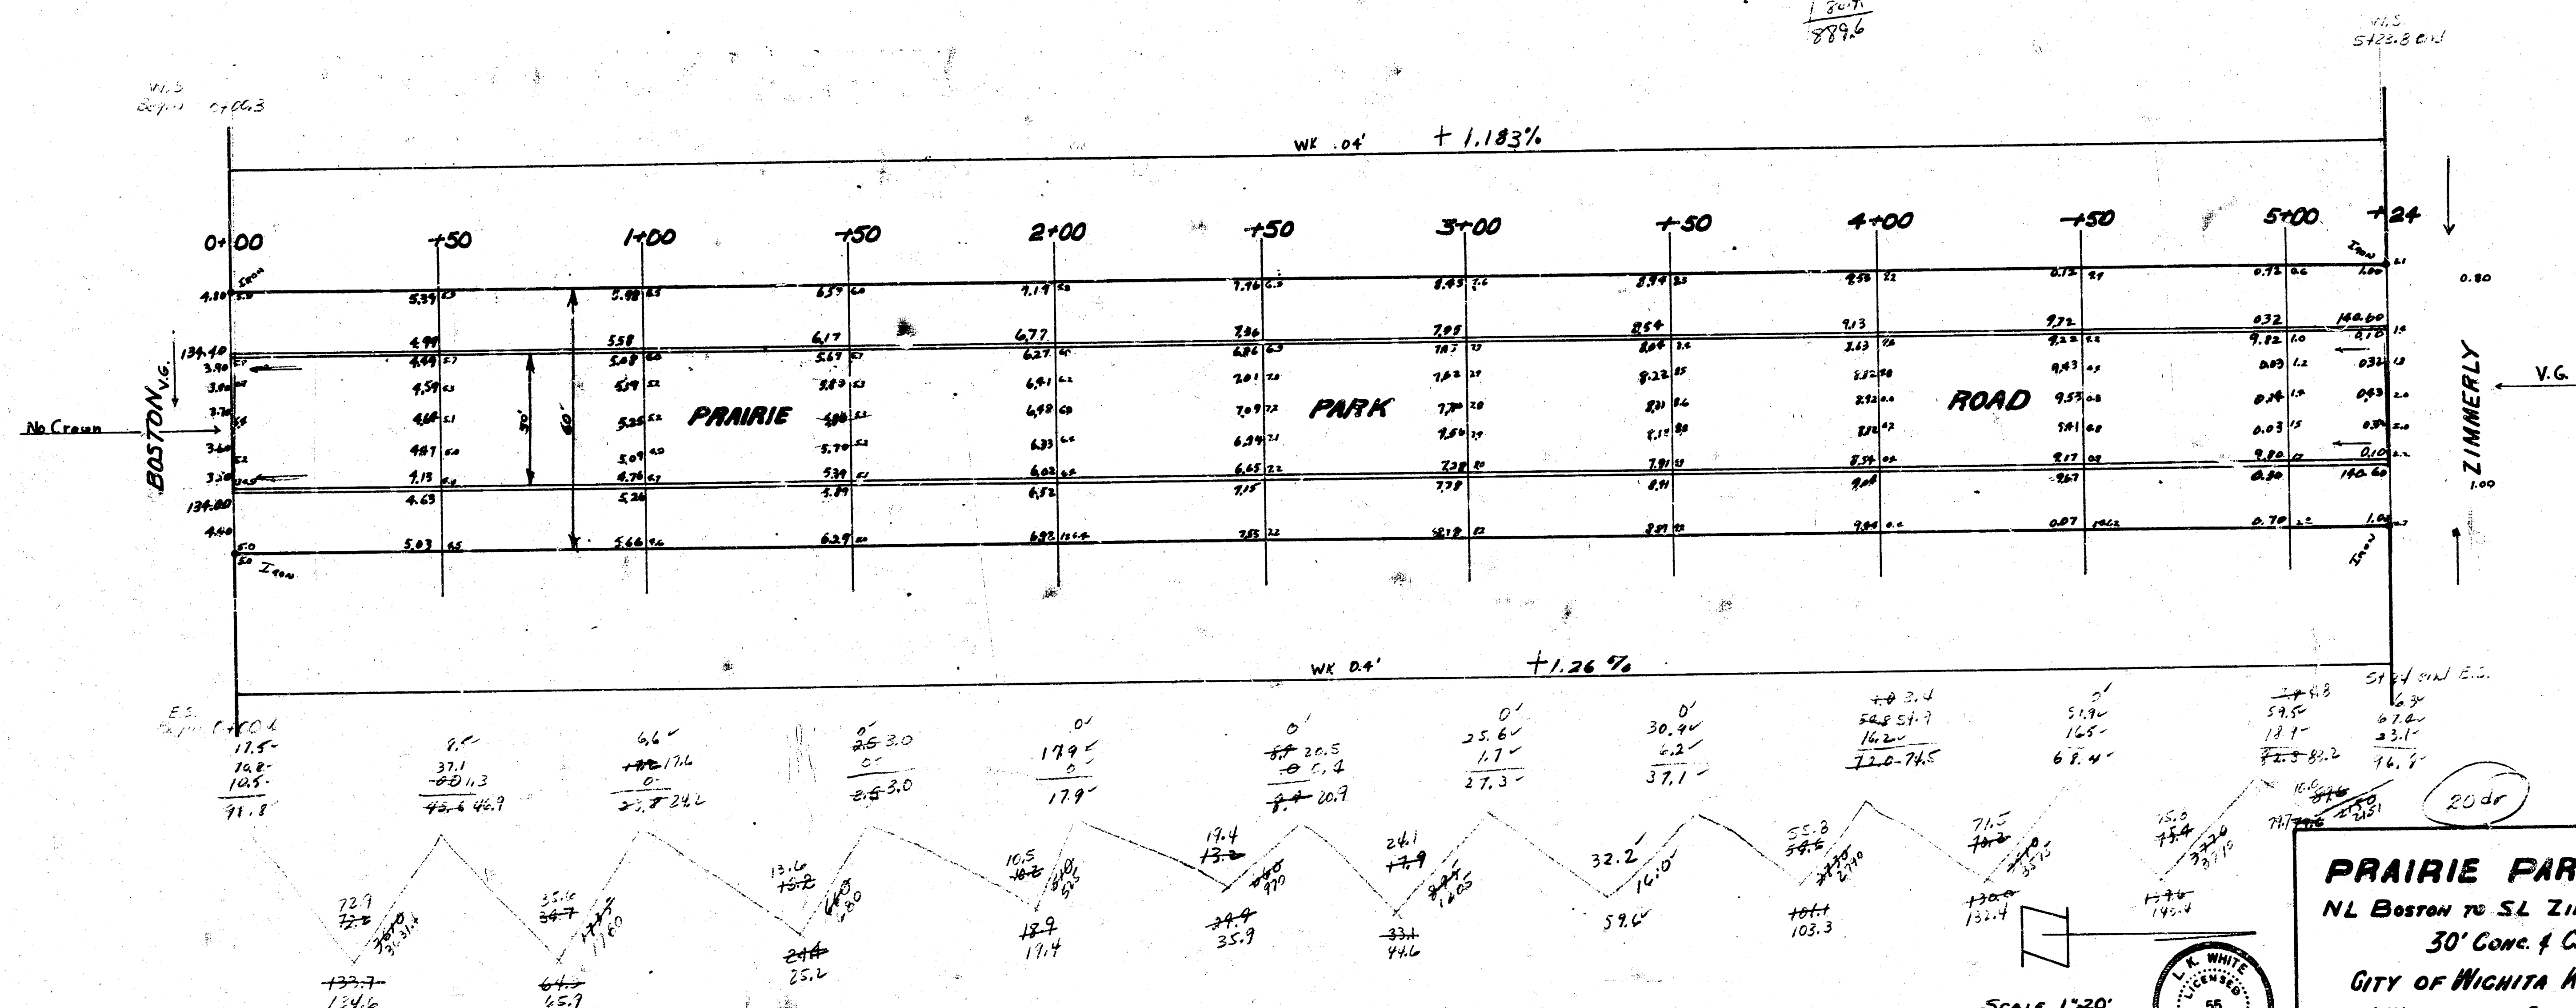

PRAIRIE PARK RD.
 NL BOSTON TO SL ZIMMERLY
 30' CONC. & CO.
 CITY OF WICHITA KANSAS
 LK WHITE CITY ENGINEER
 JAN. 1952 PROJ. NO. CU-275

4 15 5 (ie)