



End of Pavement
N.E. Corner
House No. 3723
Grail

B.M. 146.36 N.E. CORNER CONC. PORCH HOUSE NO. 3723 GRAIL
STATIONING ON EAST PROX. LINE

NOTE: TO FIELD ENGINEER
THIS JOB IS TO BE RE-CROSS-SECTION
JUST BEFORE PAVING

CURVE DATA FOR 6' OFF SET FROM FACE OF E.W. C.B.S.					
RADIUS 80' TO 6' OFFSET ON W.S. Δ = 18°13'					
RADIUS 116' TO 6' OFFSET ON E.S. Δ = 15°08'					

QUENTIN
± BOSTON TO S.L. ZIMMERLY
30' CONC & CB
CITY OF WICHITA
B.E. SMITH CITY ENGINEER
MARCH 1954 PROJ. NO. C12-53

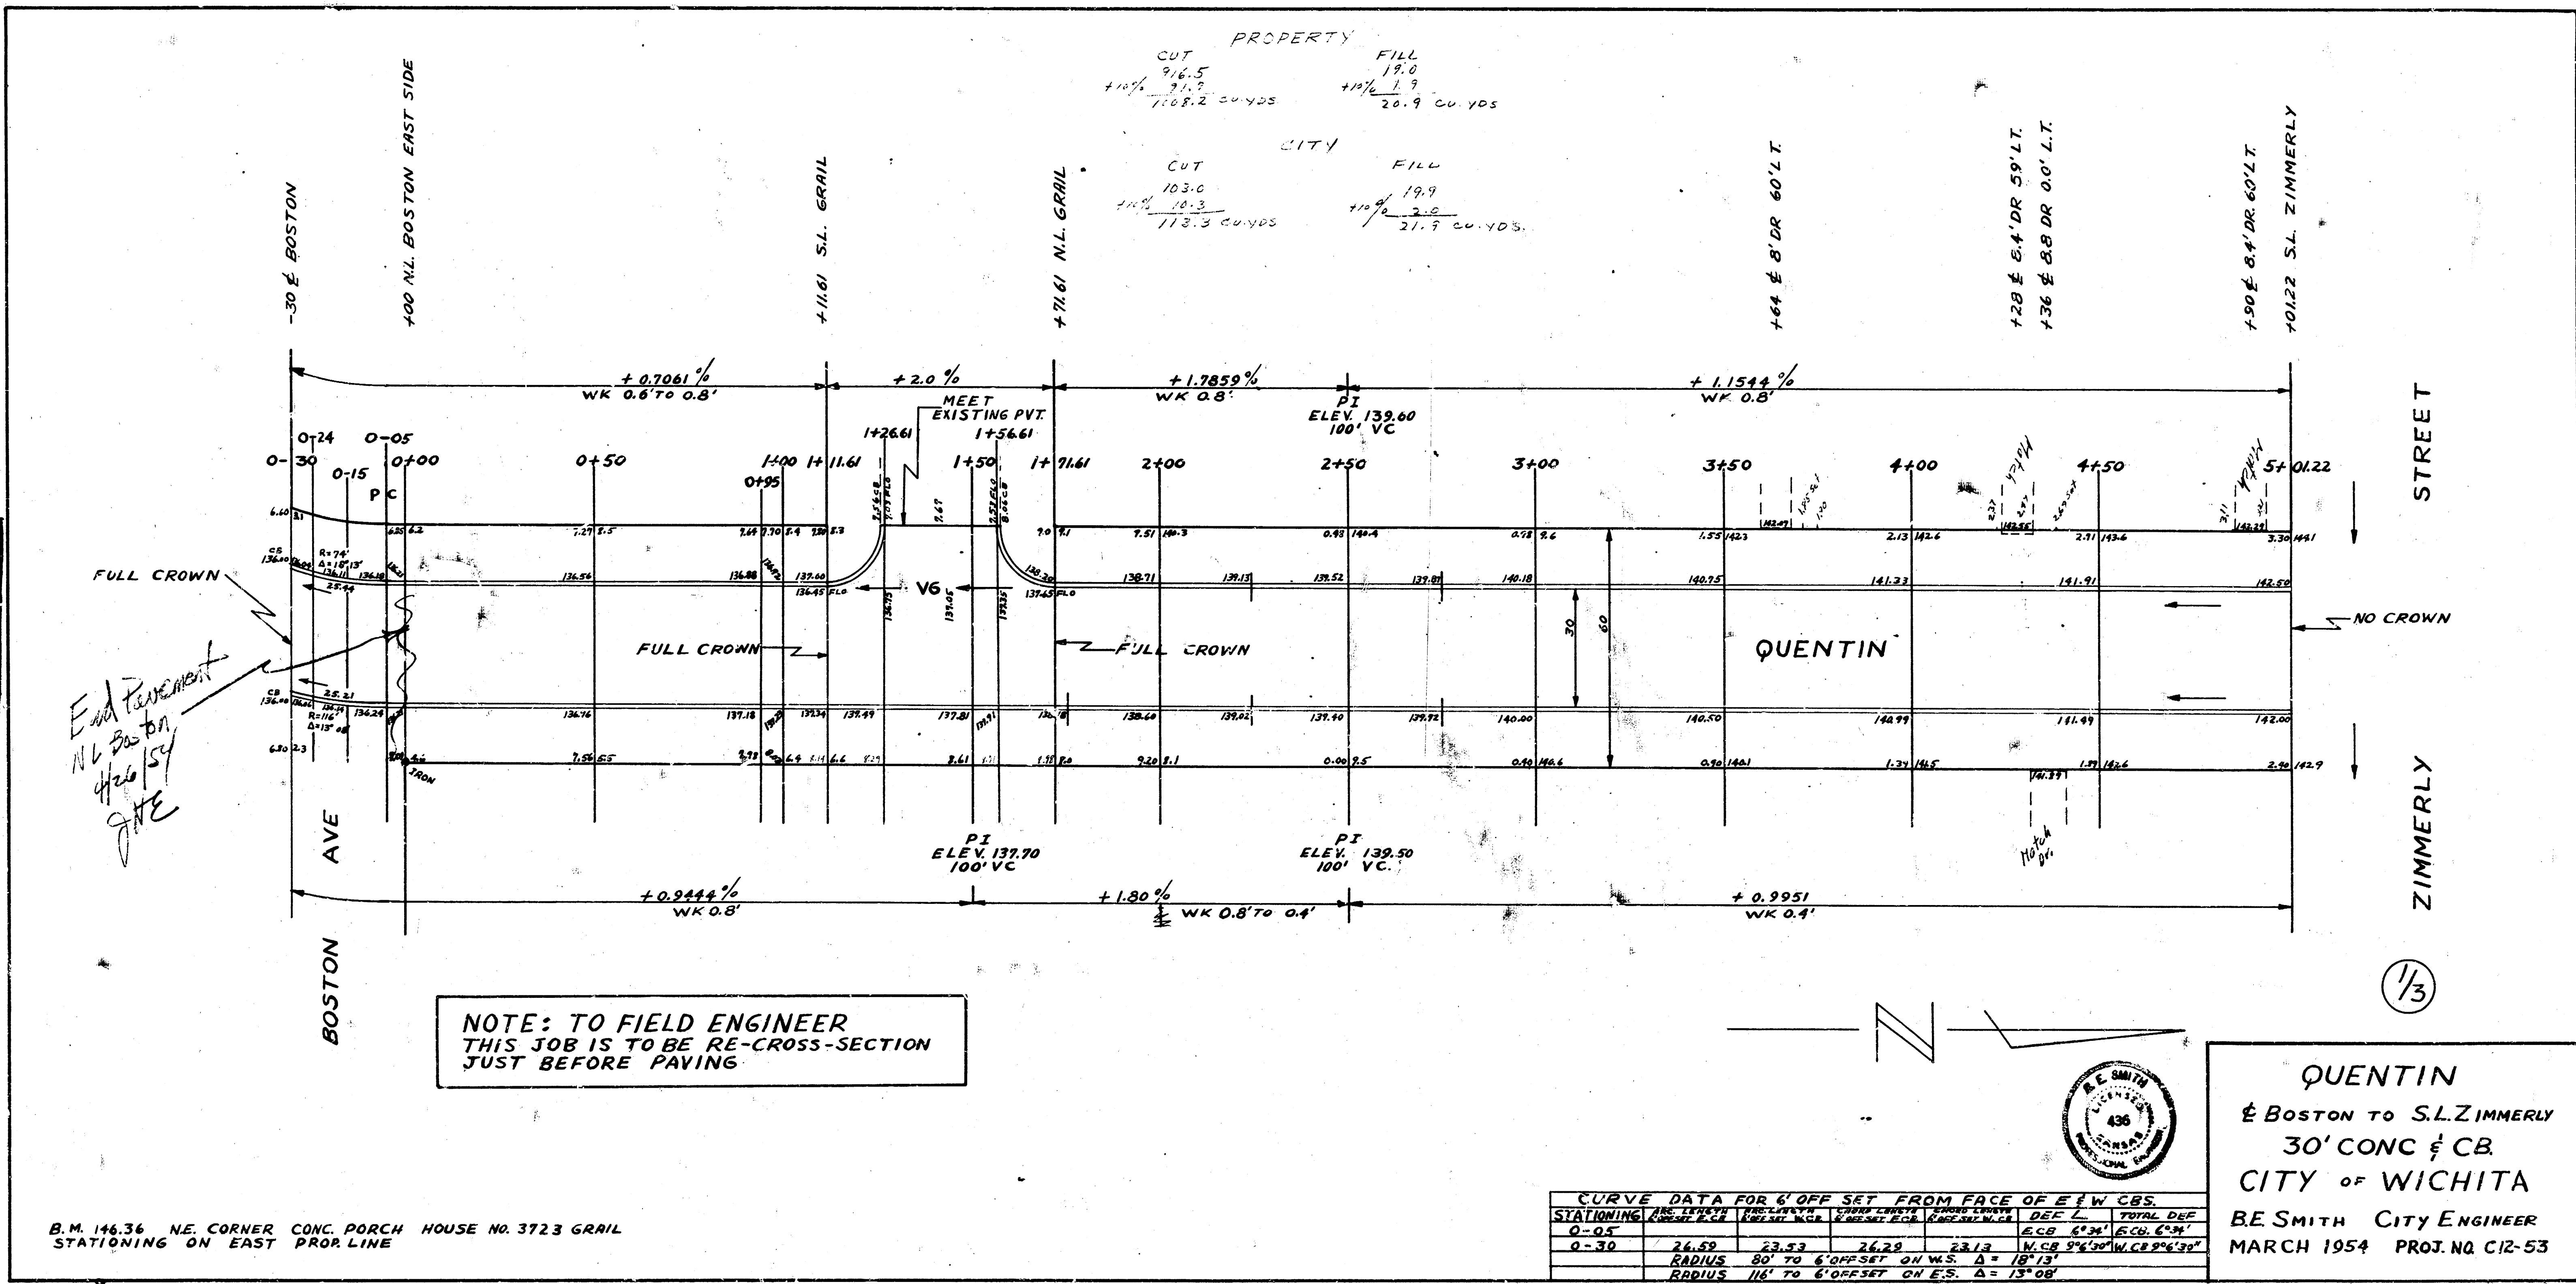

PROPERTY	
CUT	FILL

CITY	
CUT	FILL
103.0	19.9
